



GUSSET PLATE DETAIL G2 TOP

SCALE 1" = 1'-0"

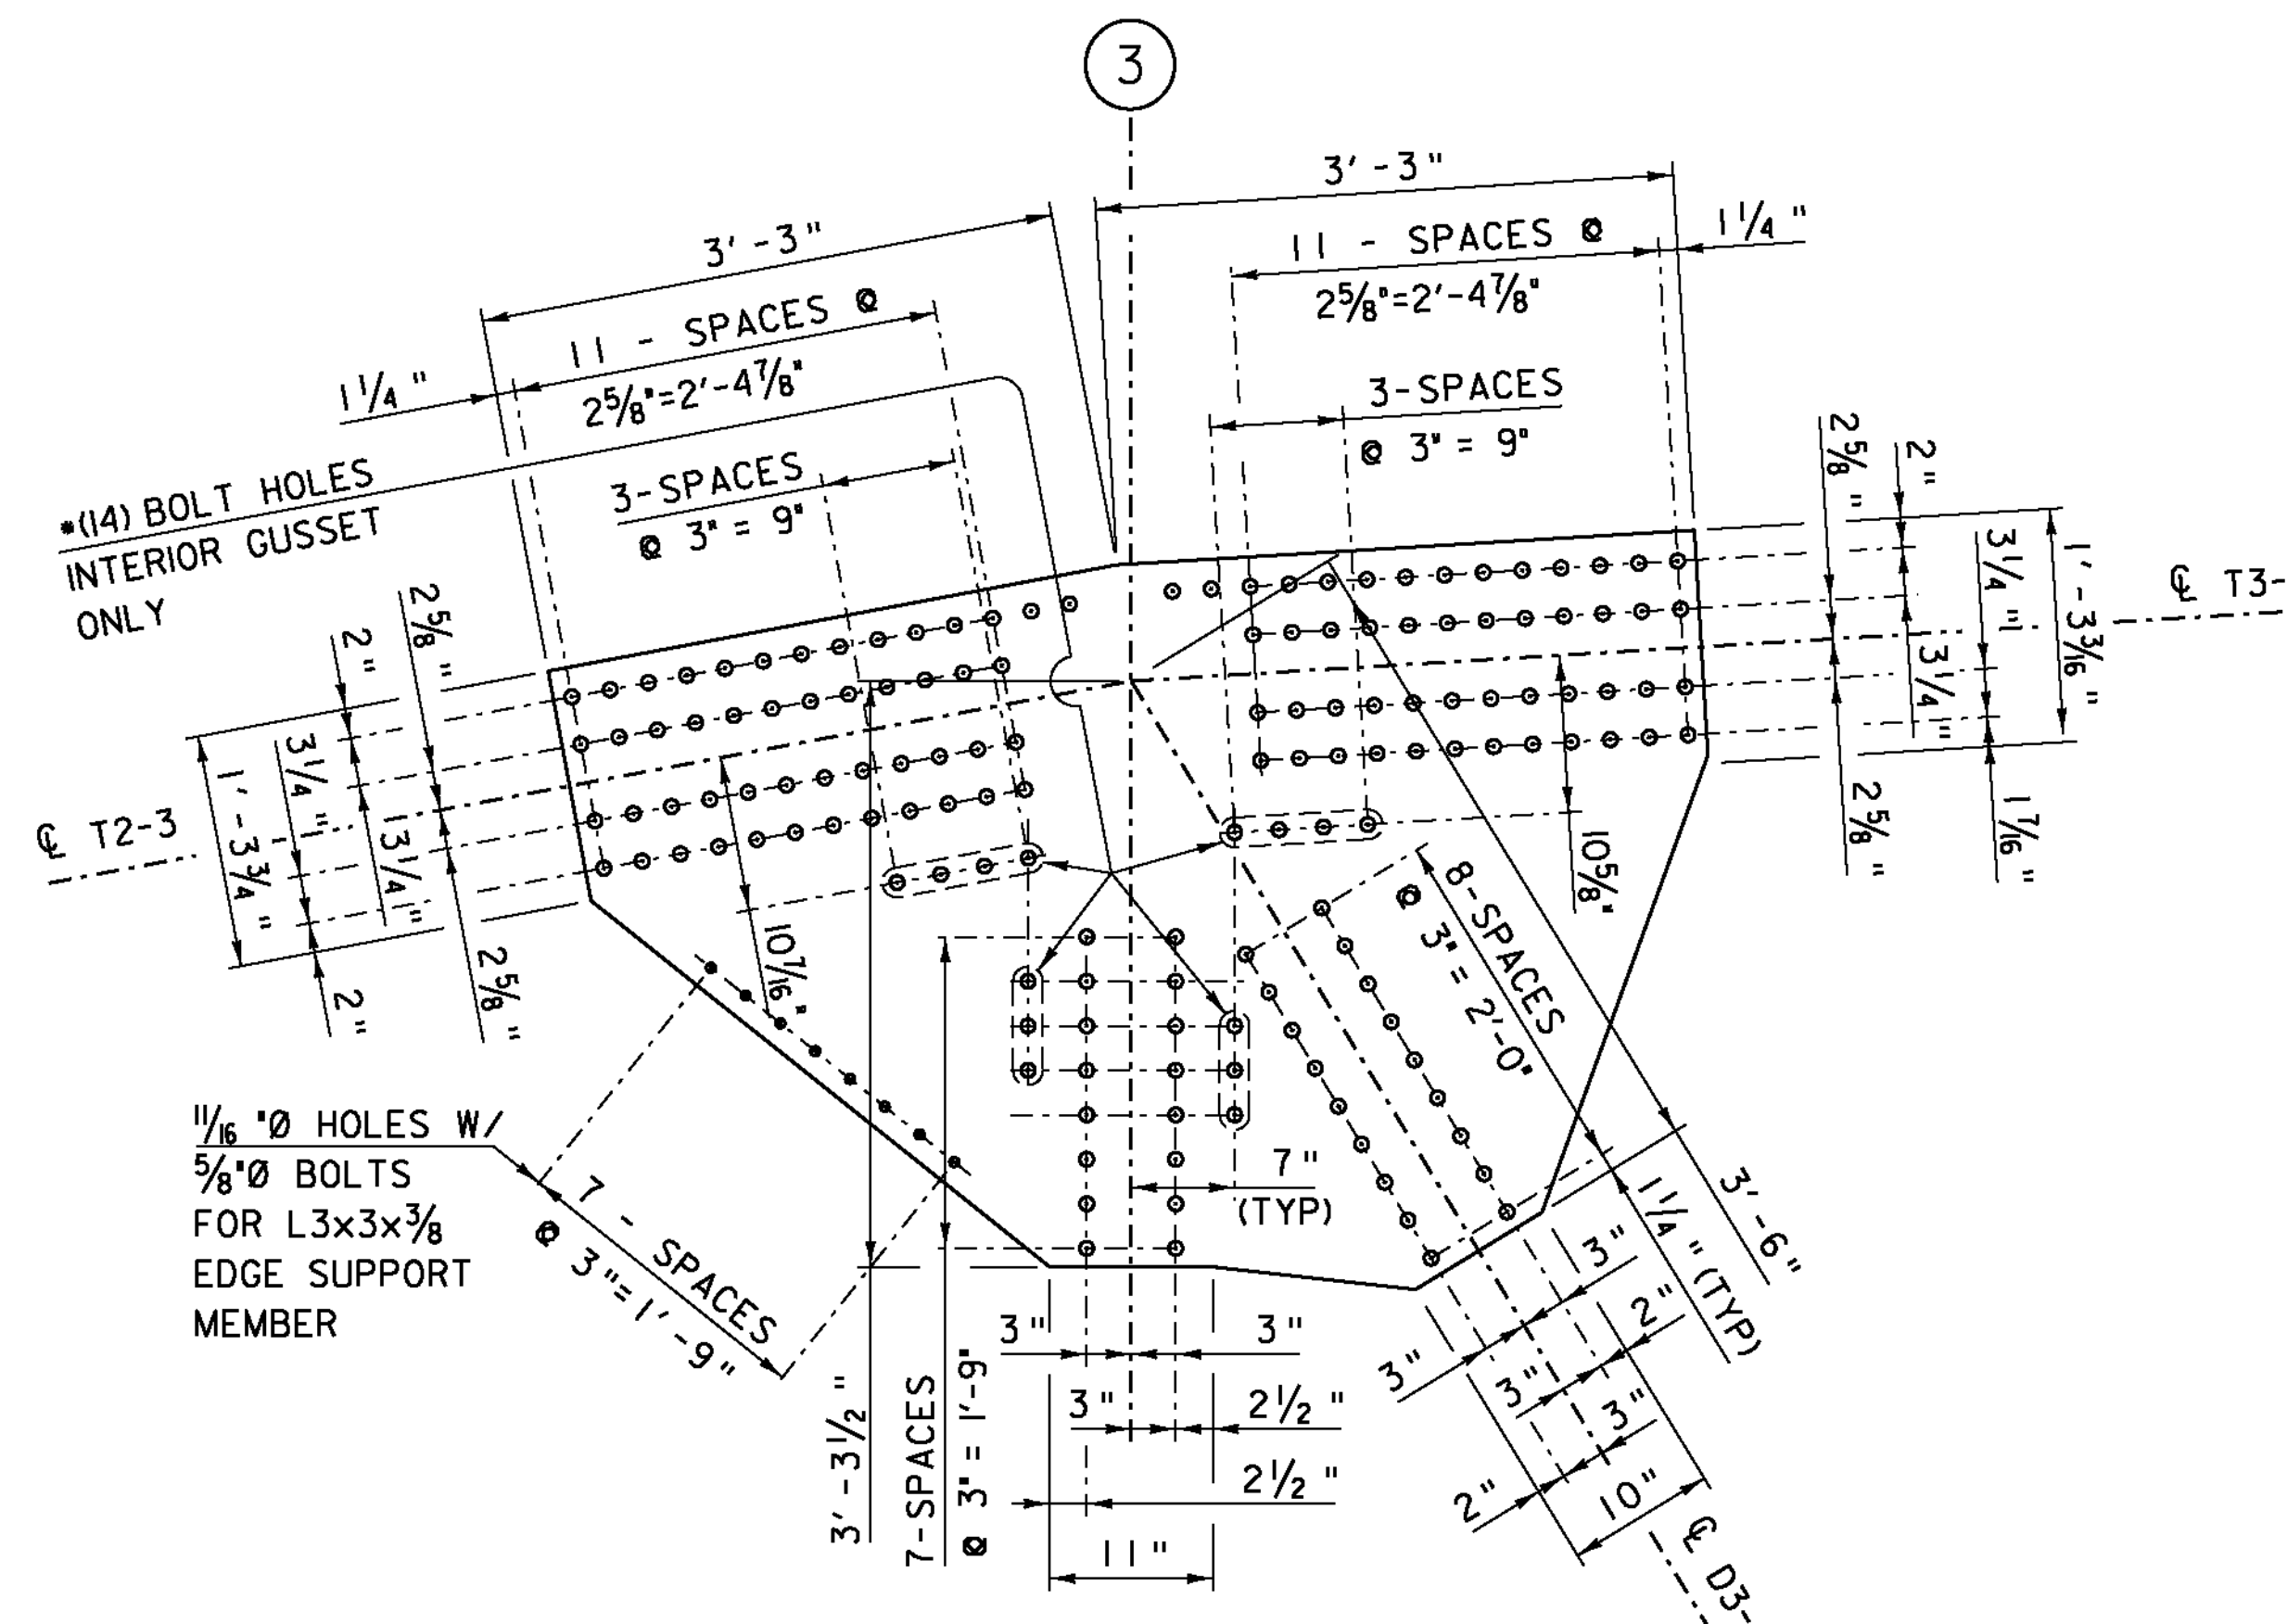


GUSSET PLATE DETAIL G3 TOP

SCALE 1" = 1'-0"

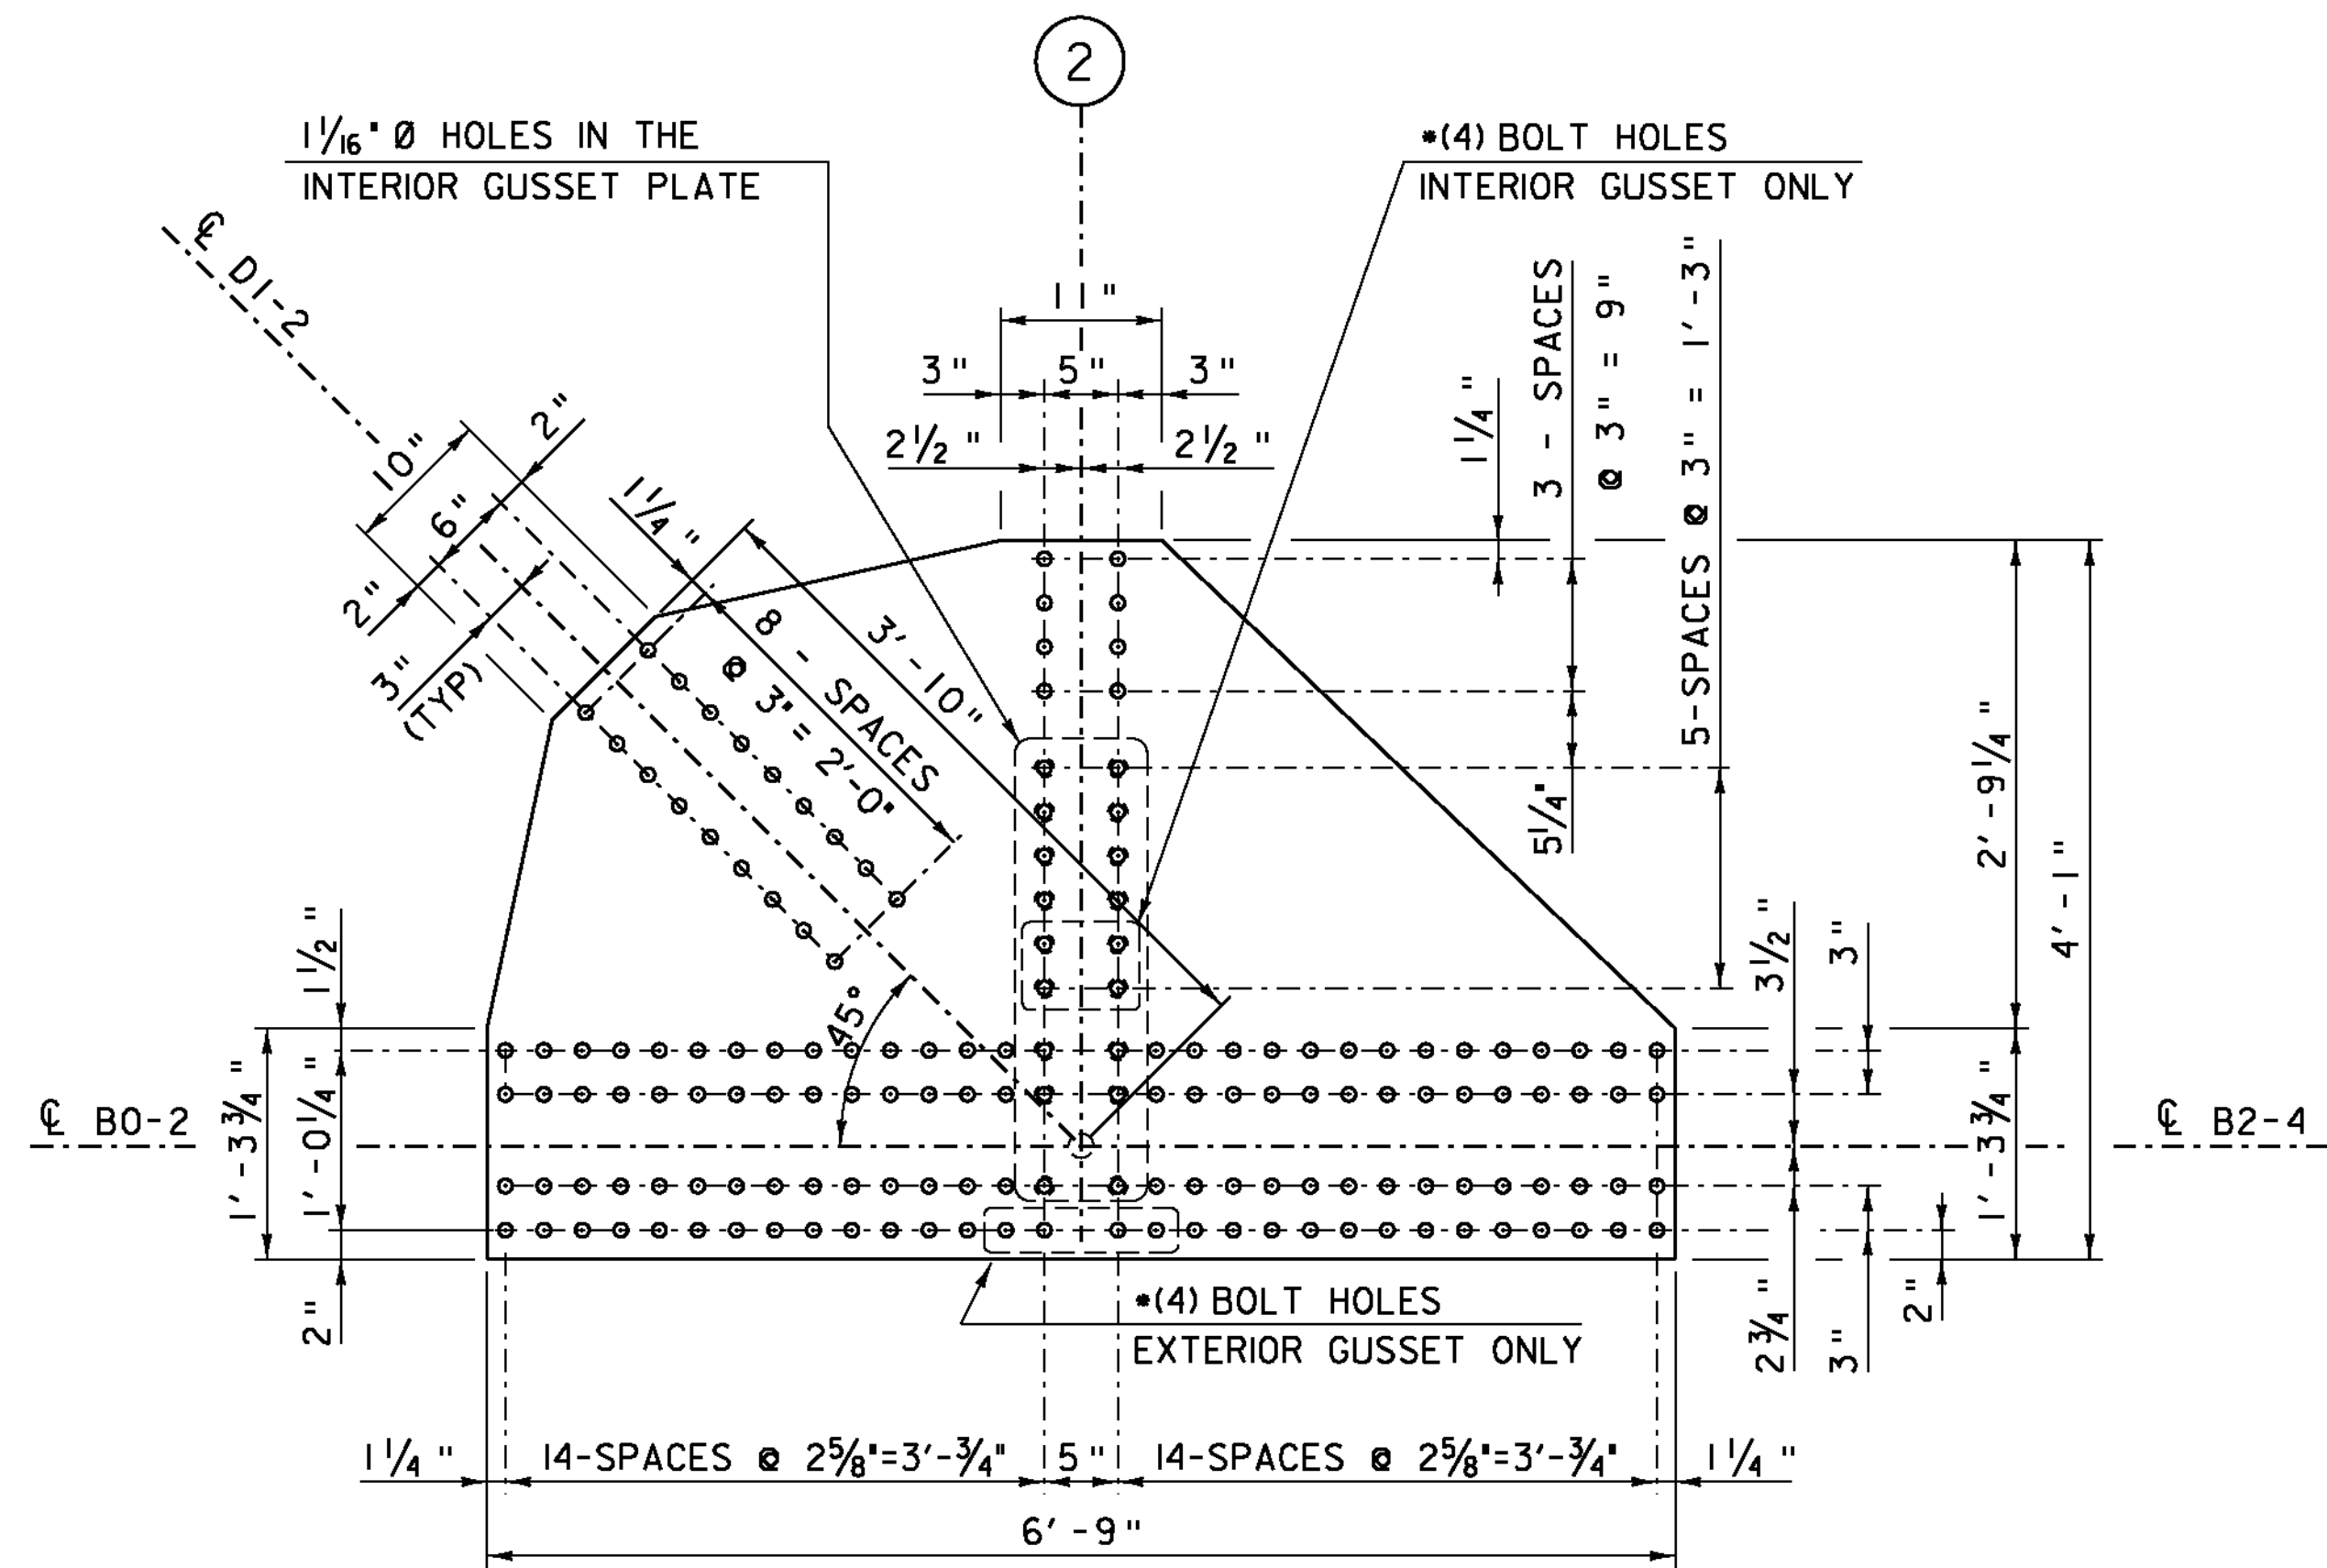

GUSSET PLATE DETAIL G2 BOTTOM

SCALE 1" = 1'-0"

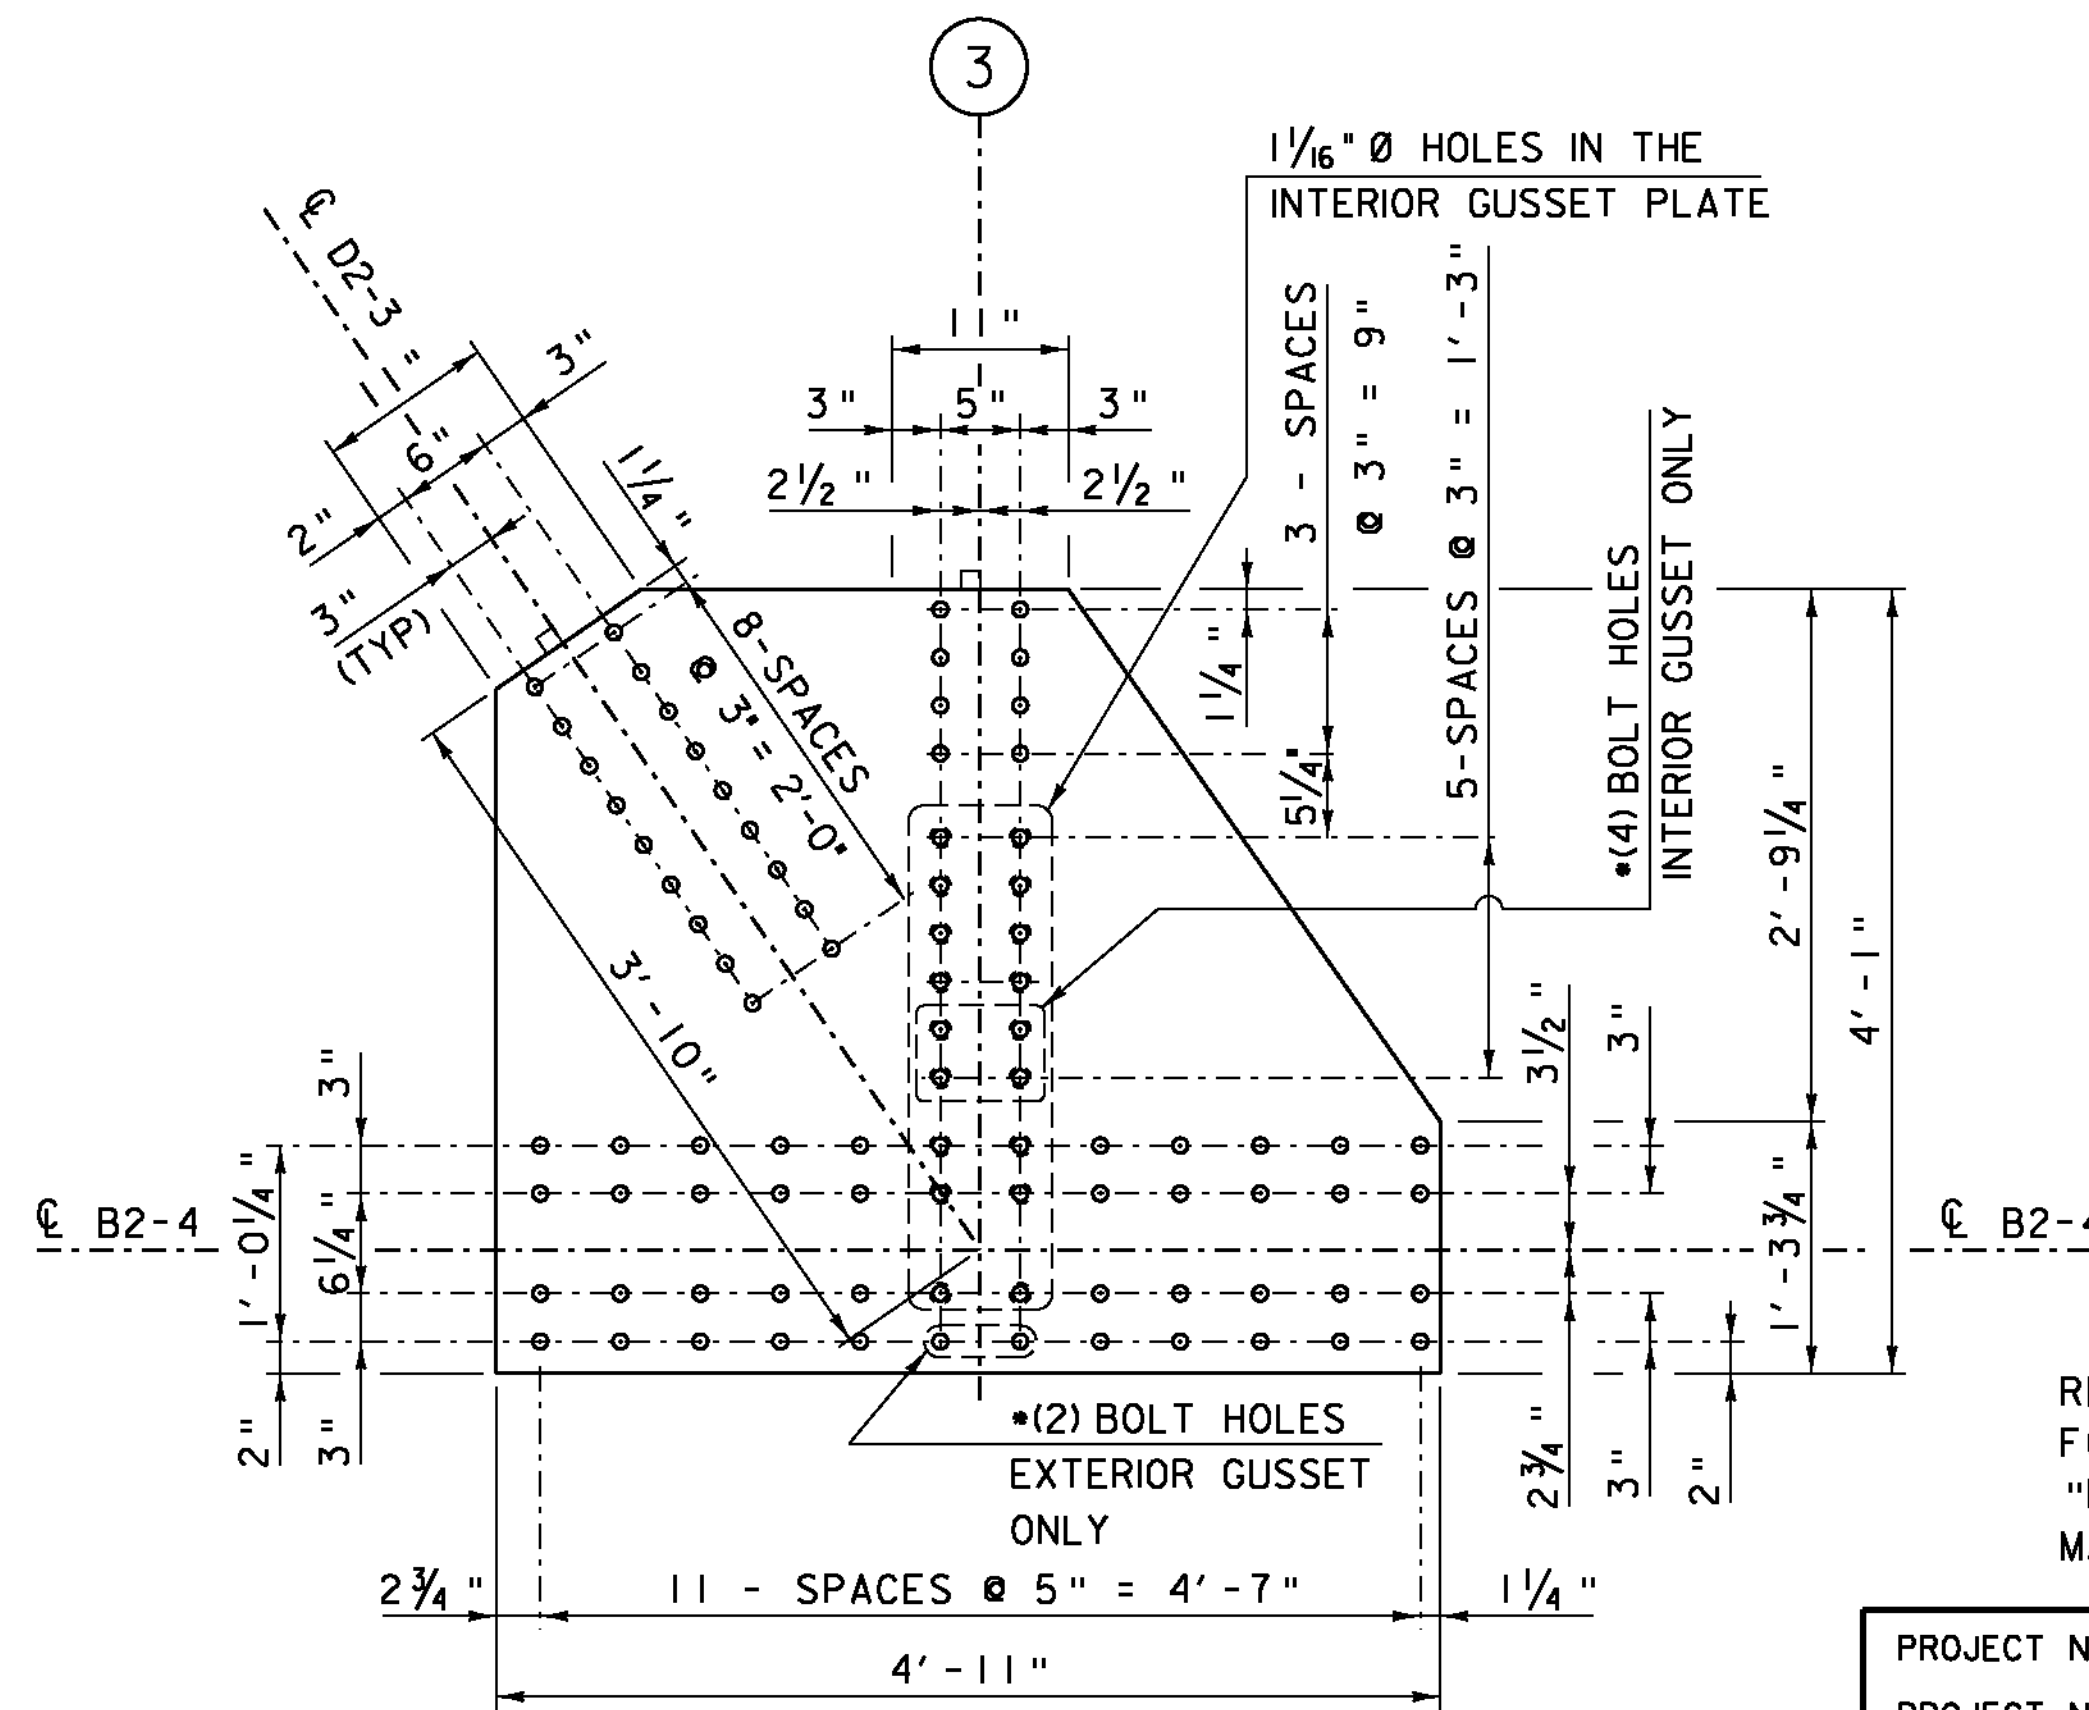

GUSSET PLATE DETAIL G3 BOTTOM

SCALE 1" = 1'-0"

REFER TO TRUSS CONNECTION DETAIL SHEET 1 FOR "TRUSS CONNECTION & GUSSET PLATE NOTES", "FILLER PLATE NOTES", AND "TRUSS STEEL MATERIAL SPECIFICATION NOTES".

PROJECT NAME: BETHEL
PROJECT NUMBER: BRF 022-1(14)

FILE NAME: s78f6itruss.dgn
PROJECT LEADER: M. EVANS-MONGEON
DESIGNED BY: N. VANDENBERG
TRUSS CONNECTION DETAIL SHEET 2

PLOT DATE: 20-MAY-2011
DRAWN BY: M. LONGSTREET
CHECKED BY: S. SCRIBNER
SHEET 91 OF 148