



GUSSET PLATE DETAIL G4 TOP

SCALE 1" = 1'-0"

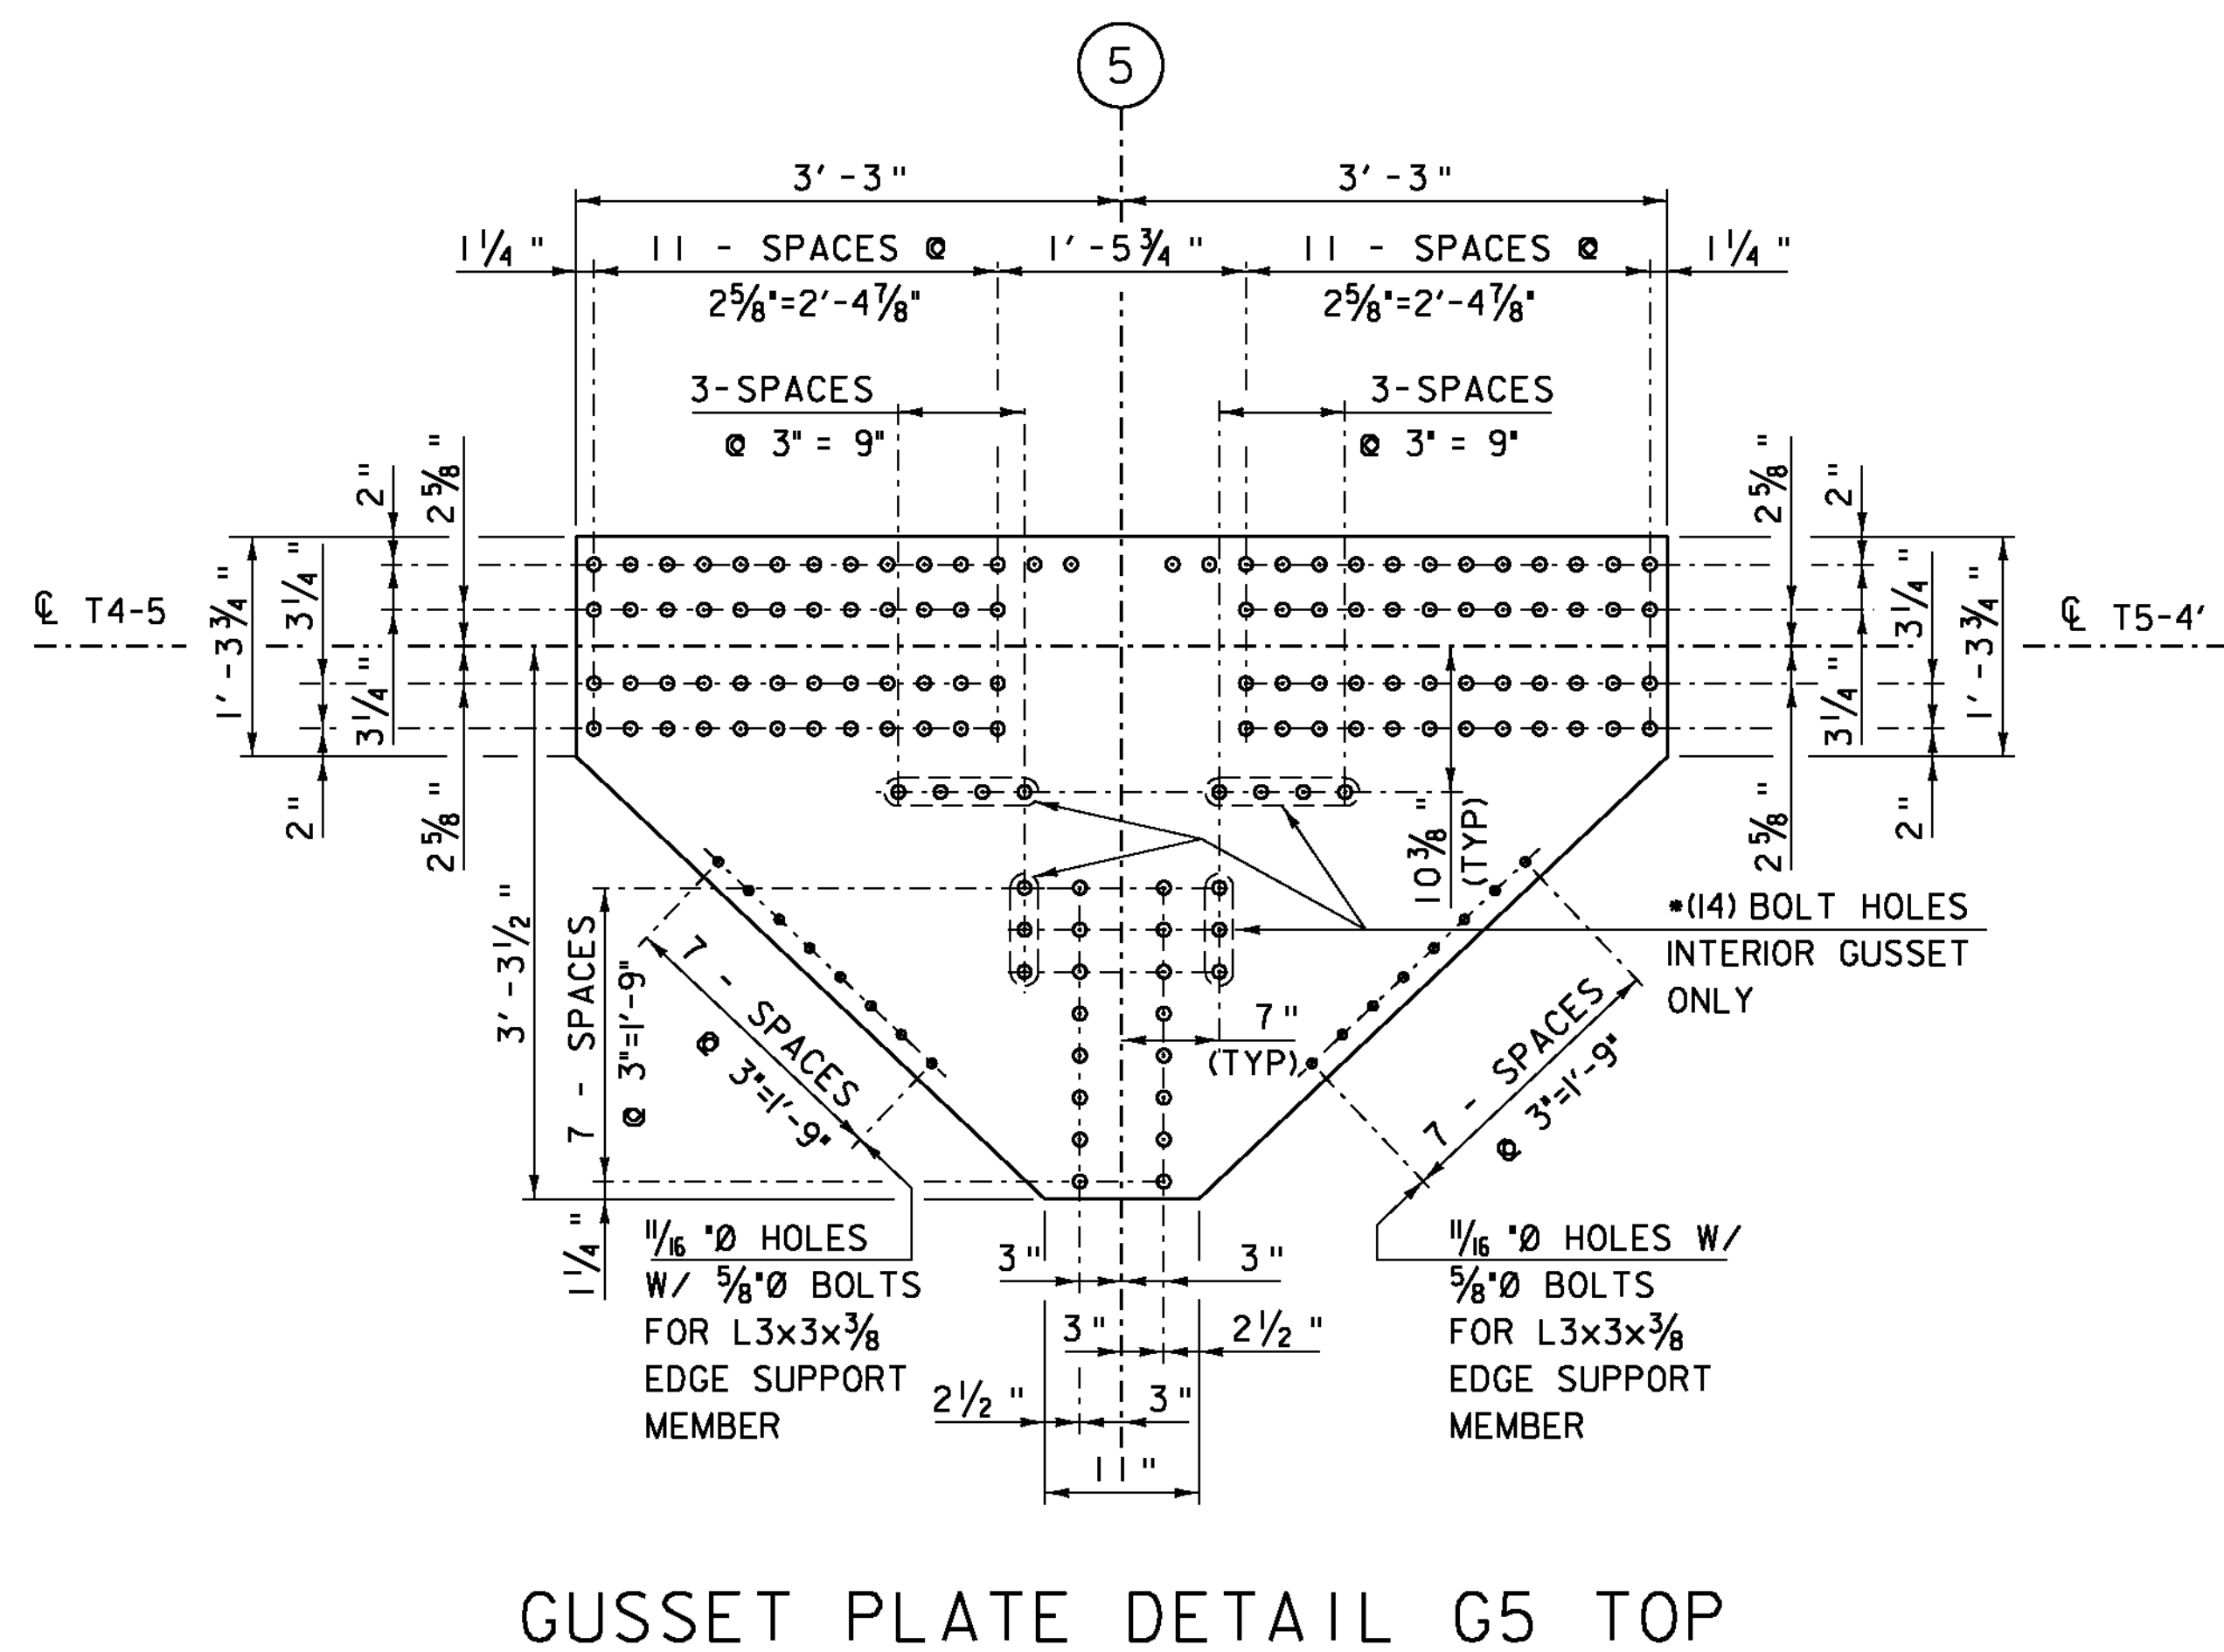


GUSSET PLATE DETAIL G5 TOP

SCALE 1" = 1'-0"

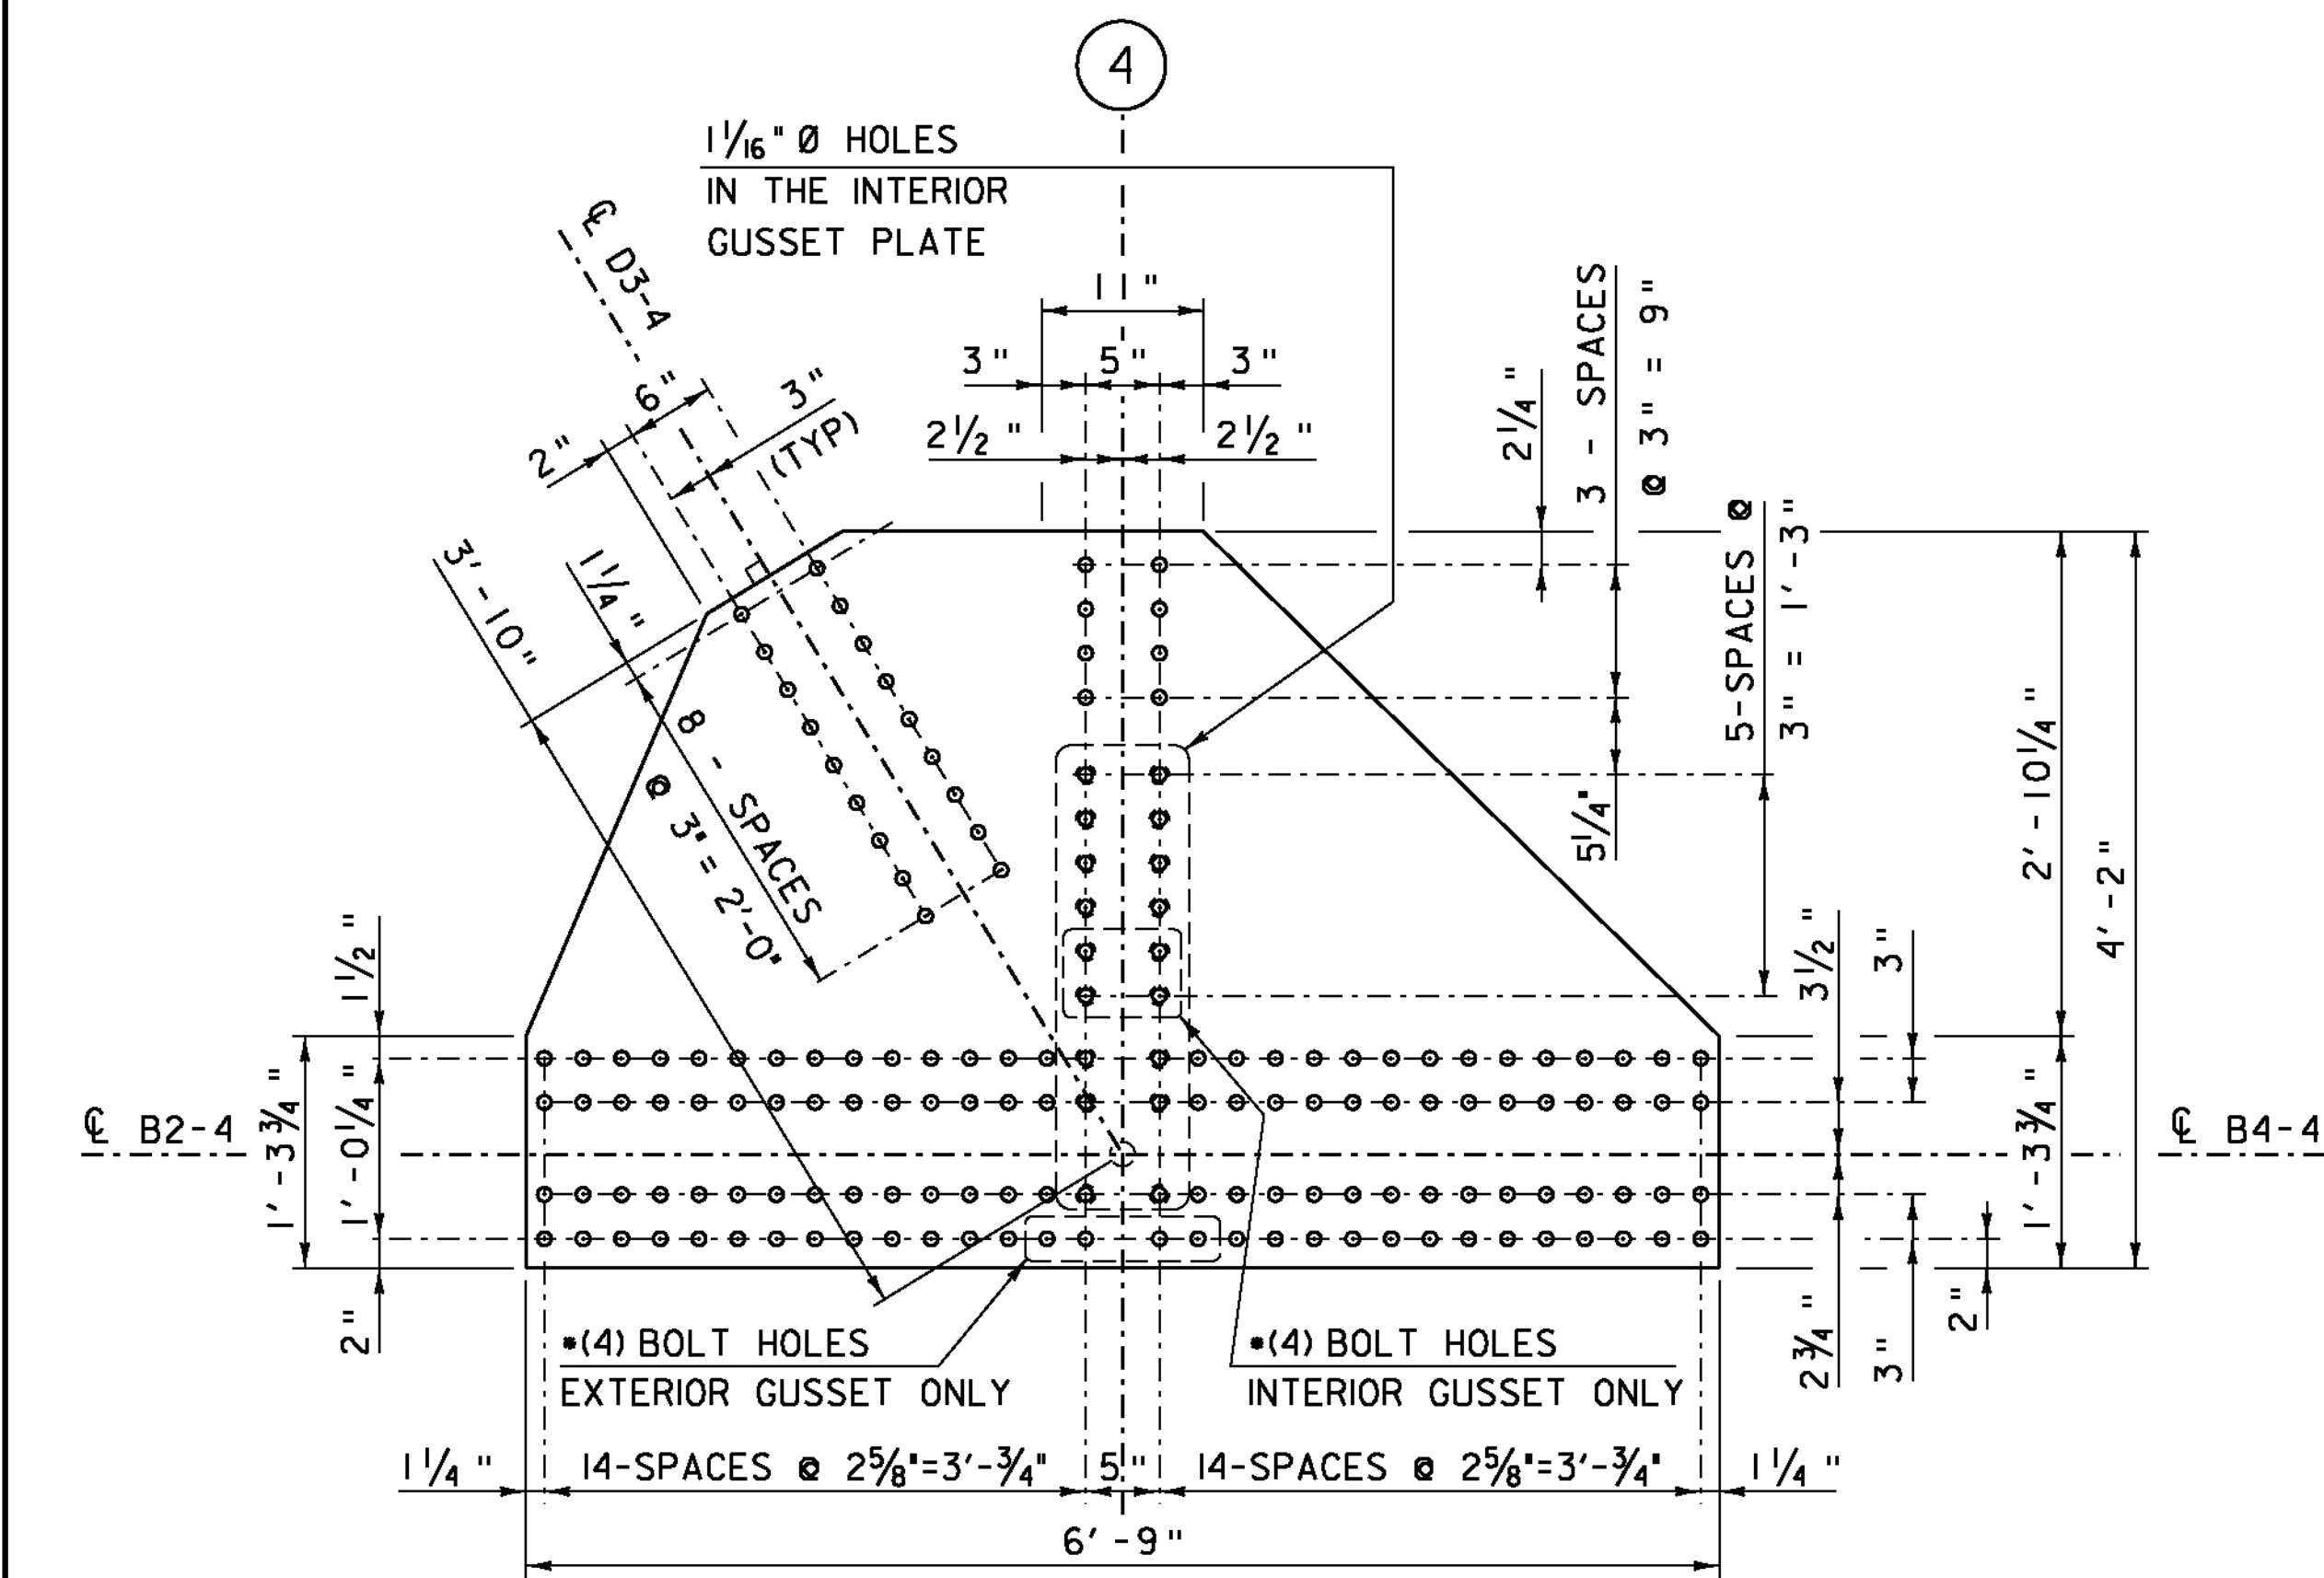

GUSSET PLATE DETAIL G4 BOTTOM

SCALE 1" = 1'-0"

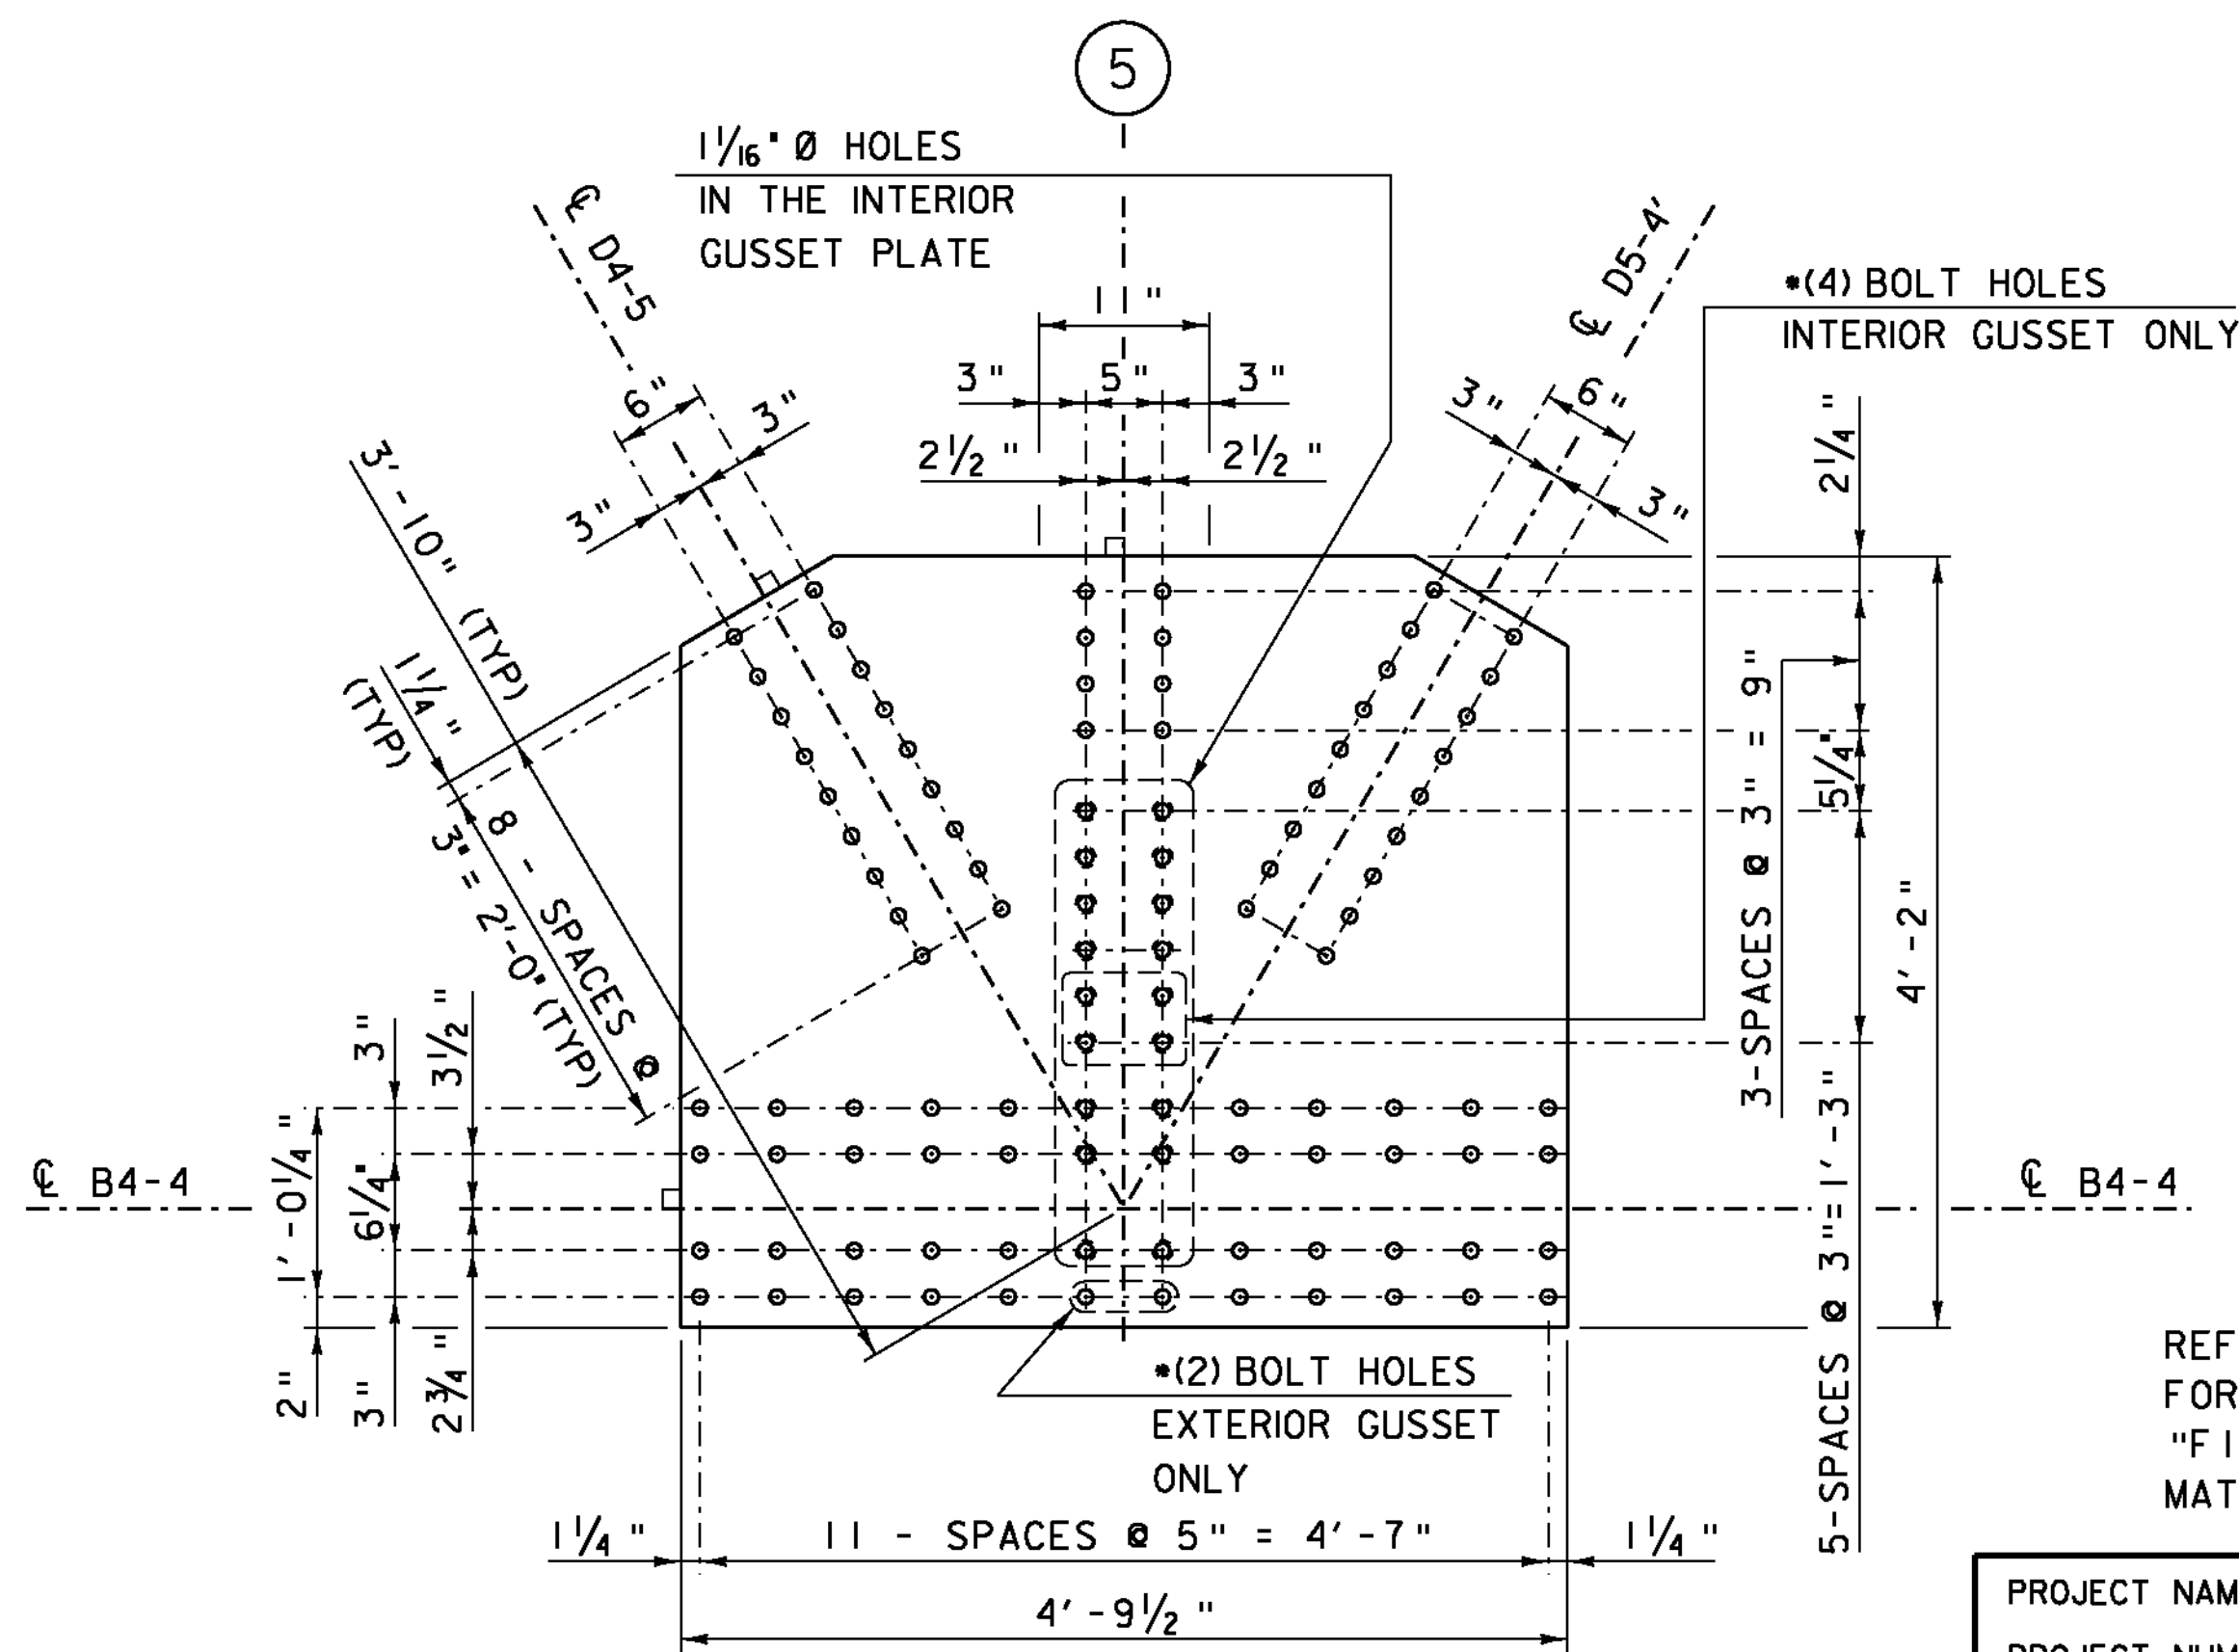

GUSSET PLATE DETAIL G5 BOTTOM

SCALE 1" = 1'-0"

REFER TO TRUSS CONNECTION DETAIL SHEET 1 FOR "TRUSS CONNECTION & GUSSET PLATE NOTES", "FILLER PLATE NOTES", AND "TRUSS STEEL MATERIAL SPECIFICATION NOTES".

PROJECT NAME: BETHEL
PROJECT NUMBER: BRF 022-(14)

FILE NAME: s78f61truss.dgn
PROJECT LEADER: M. EVANS-MONGEON
DESIGNED BY: N. VANDENBERG
TRUSS CONNECTION DETAIL SHEET 3

PLOT DATE: 20-MAY-2011
DRAWN BY: M. LONGSTREET
CHECKED BY: S. SCRIBNER
SHEET 92 OF 148