




121+50

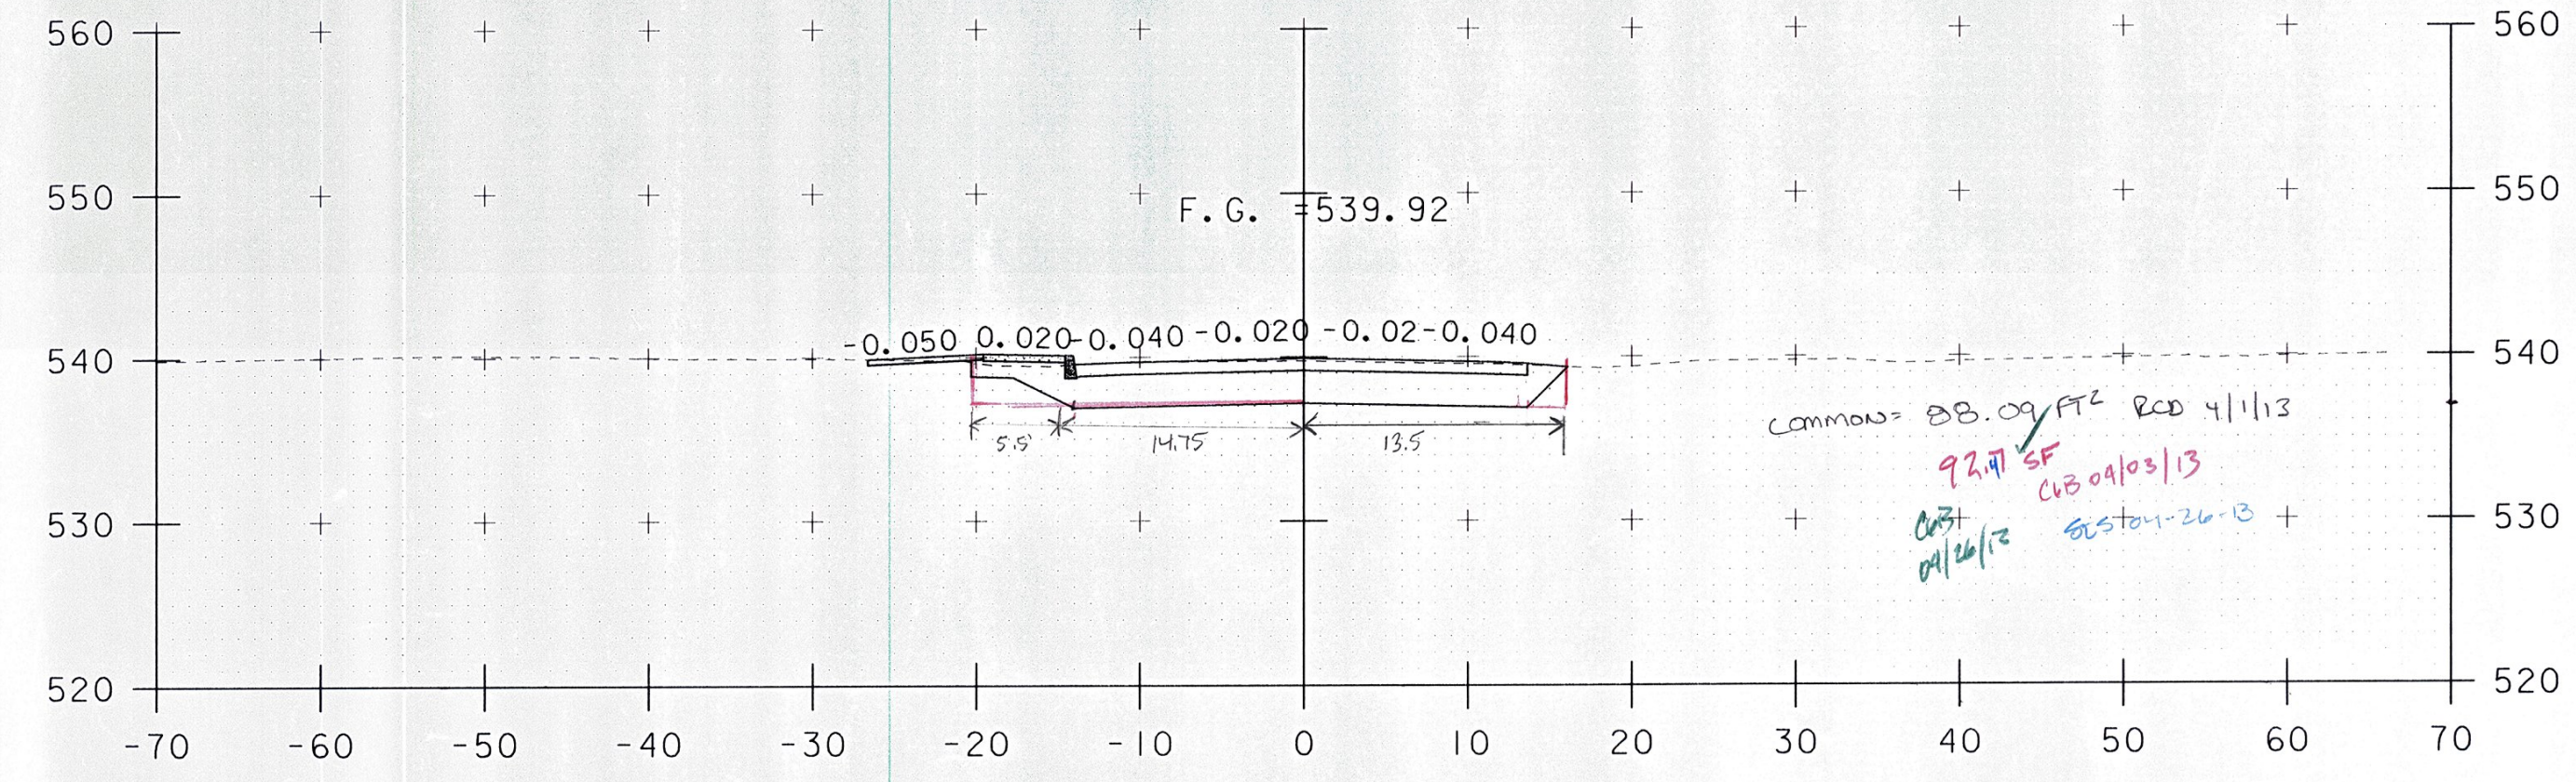


122+00

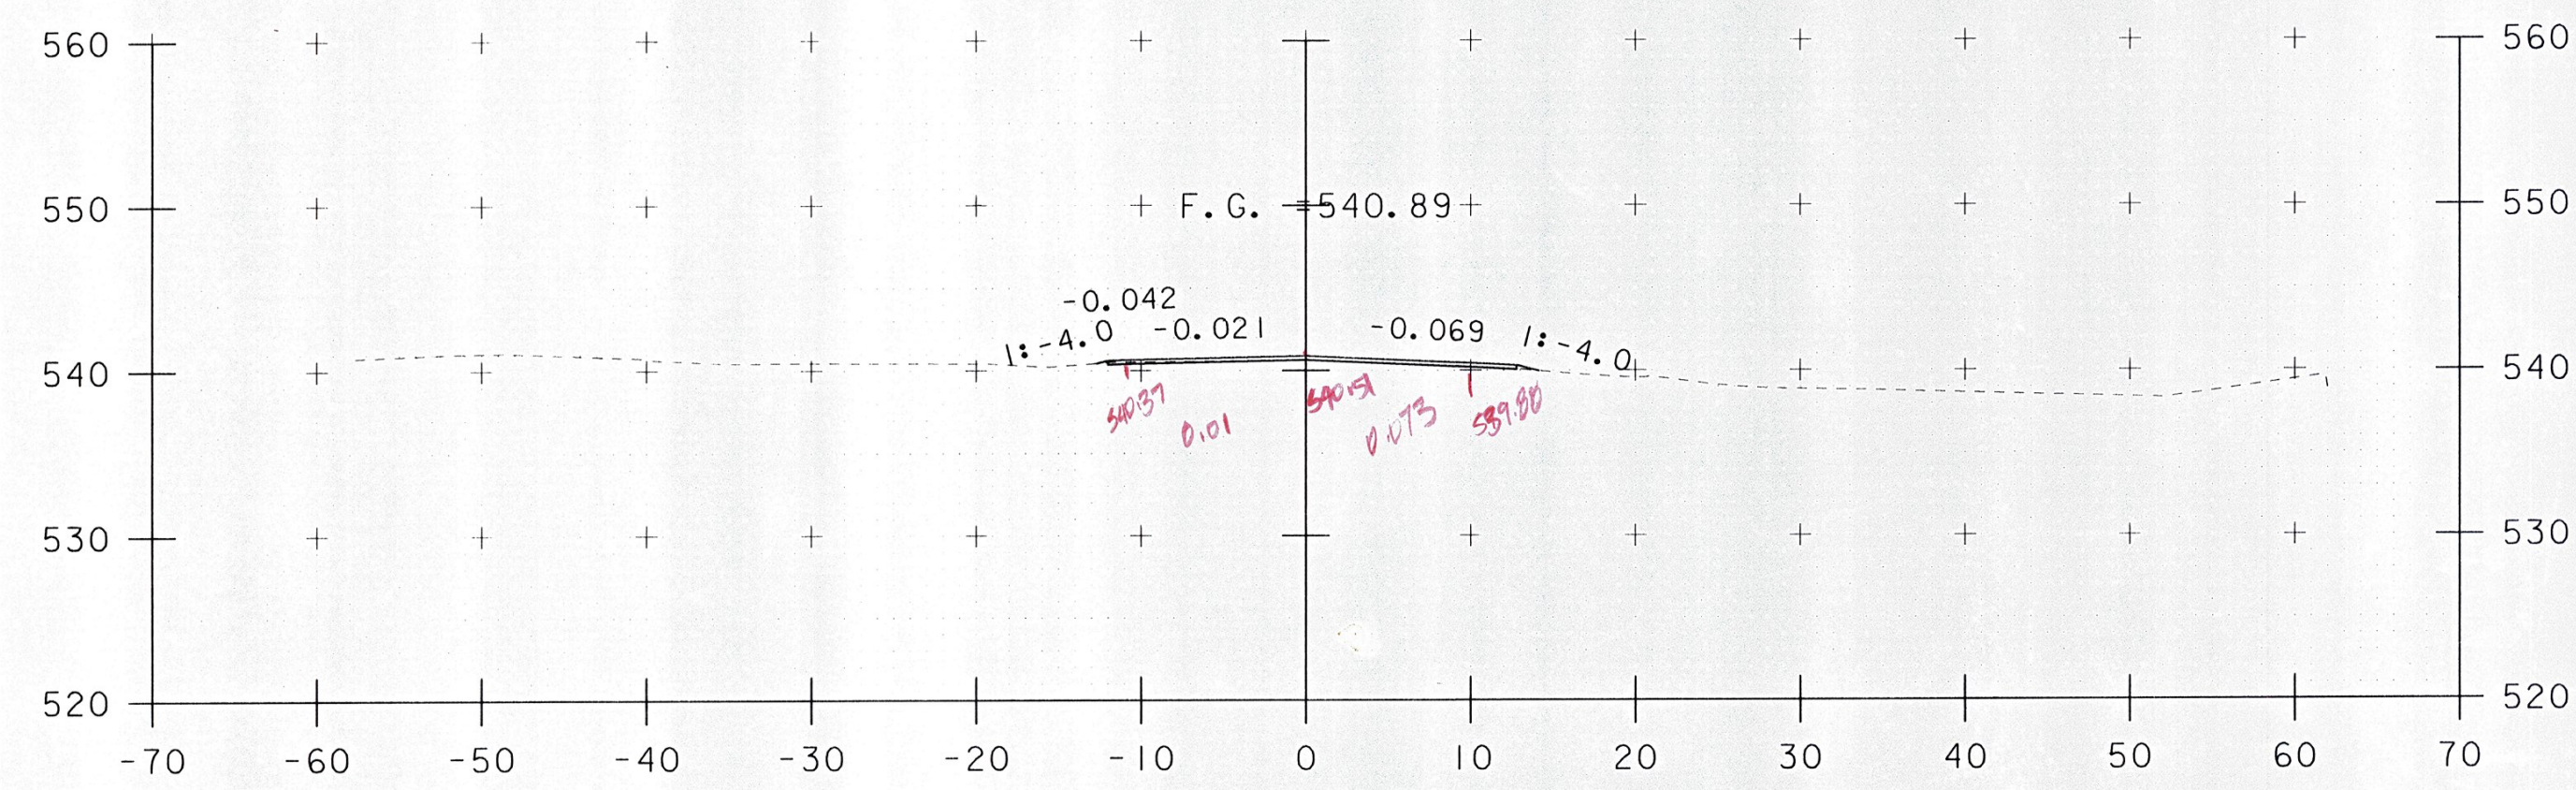


121+25

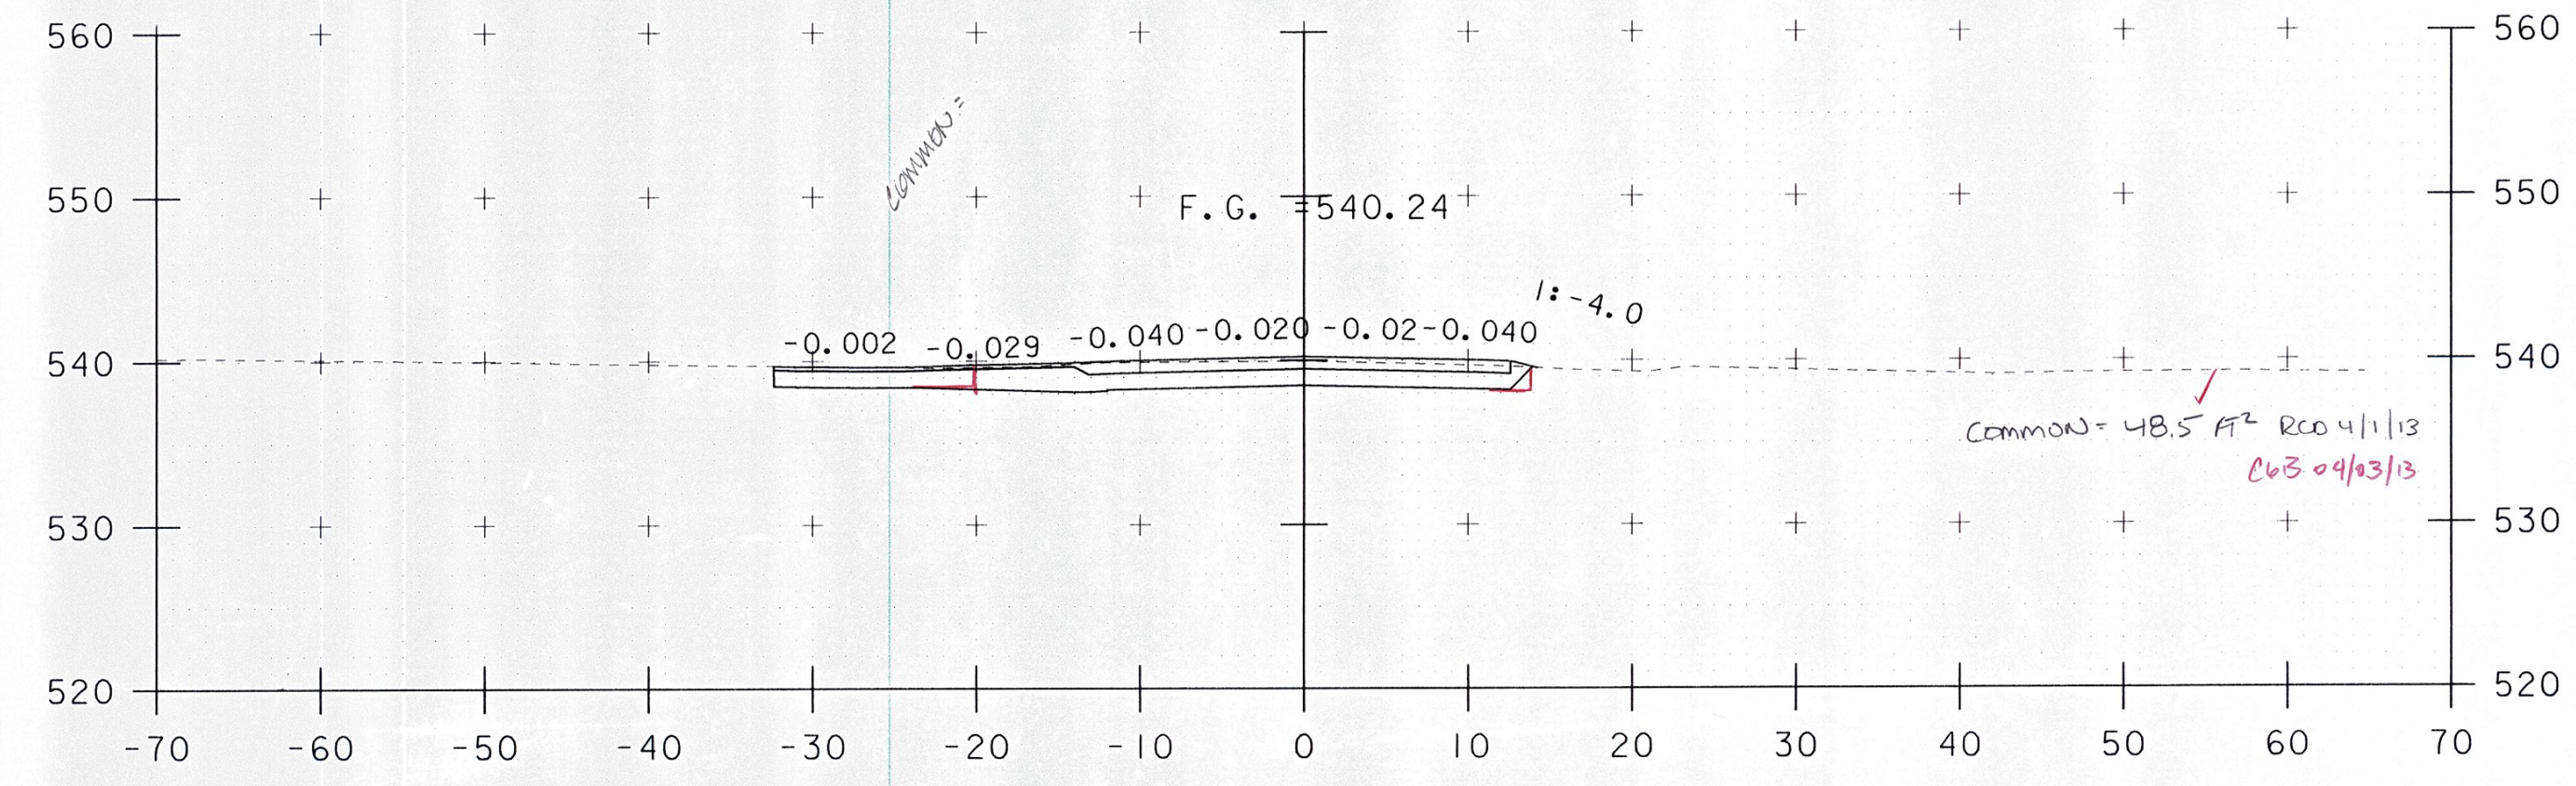


121+75

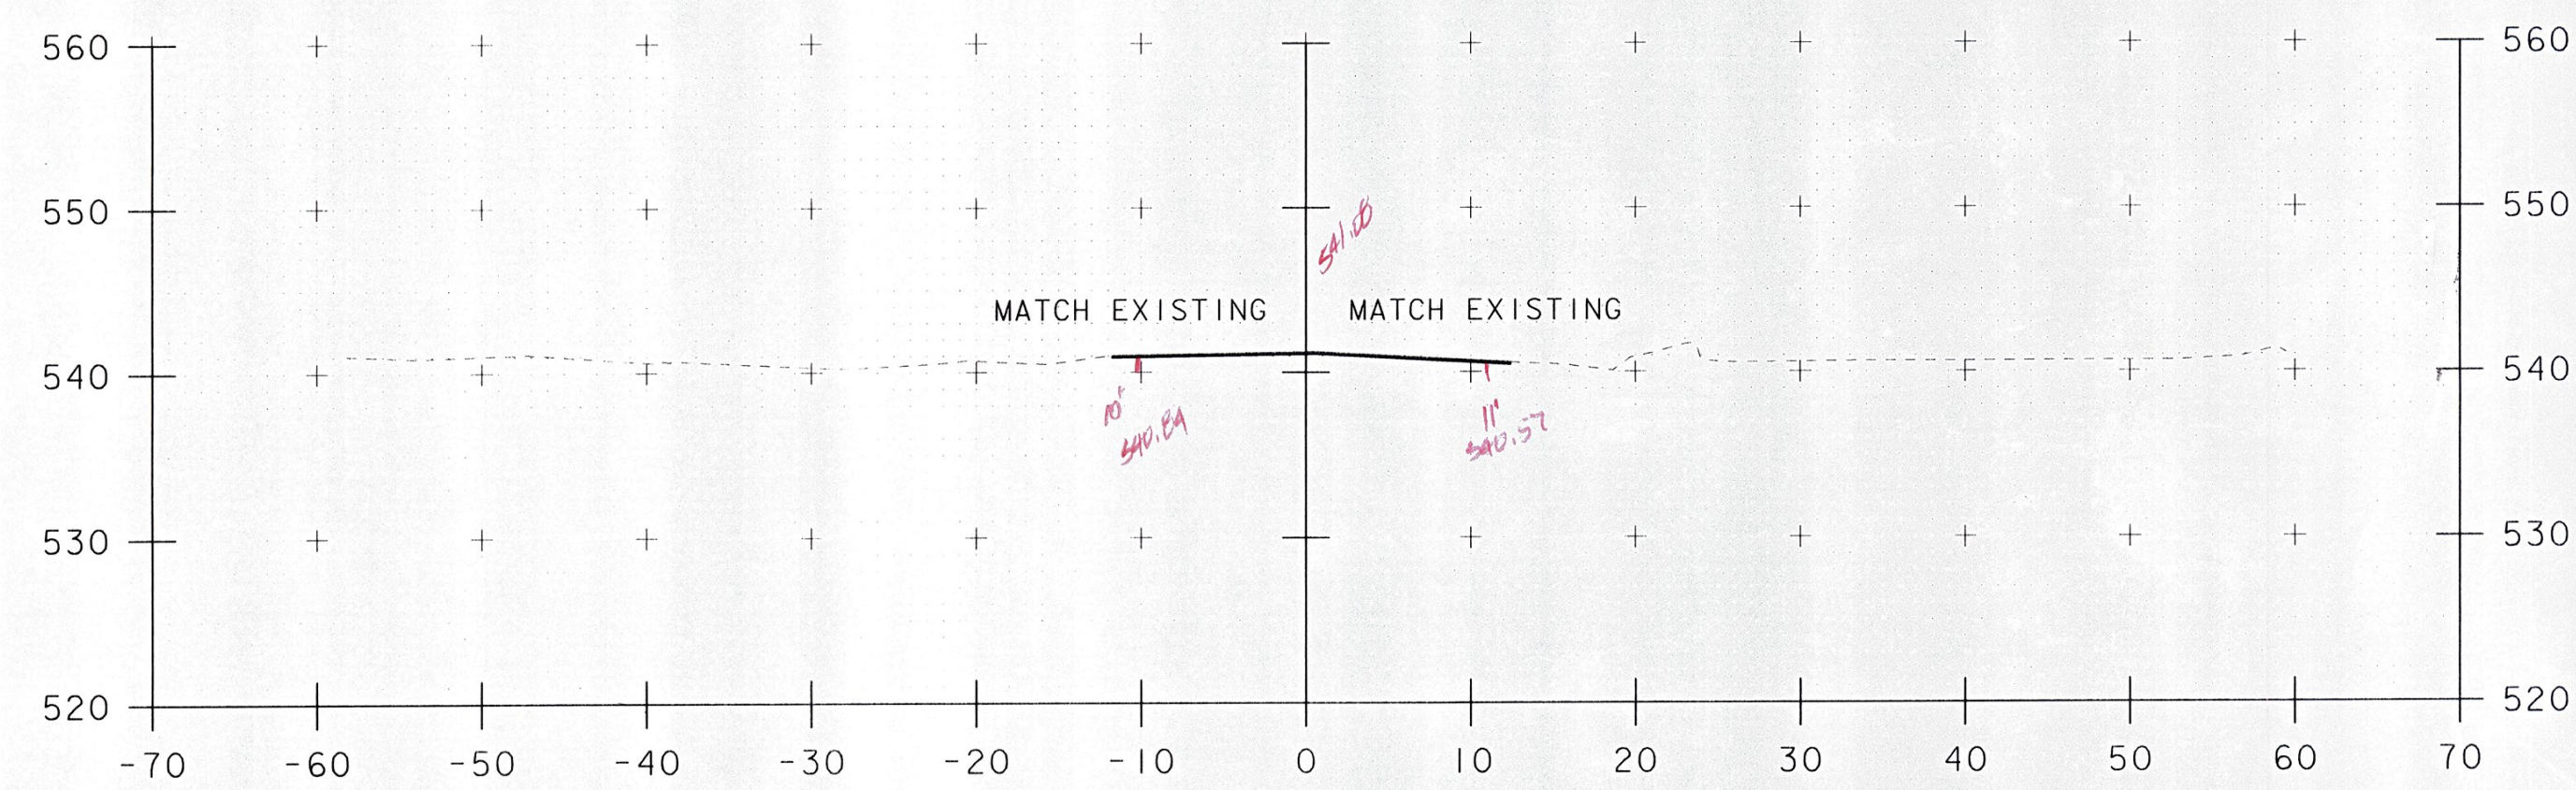

121+00
BEGIN APPROACH

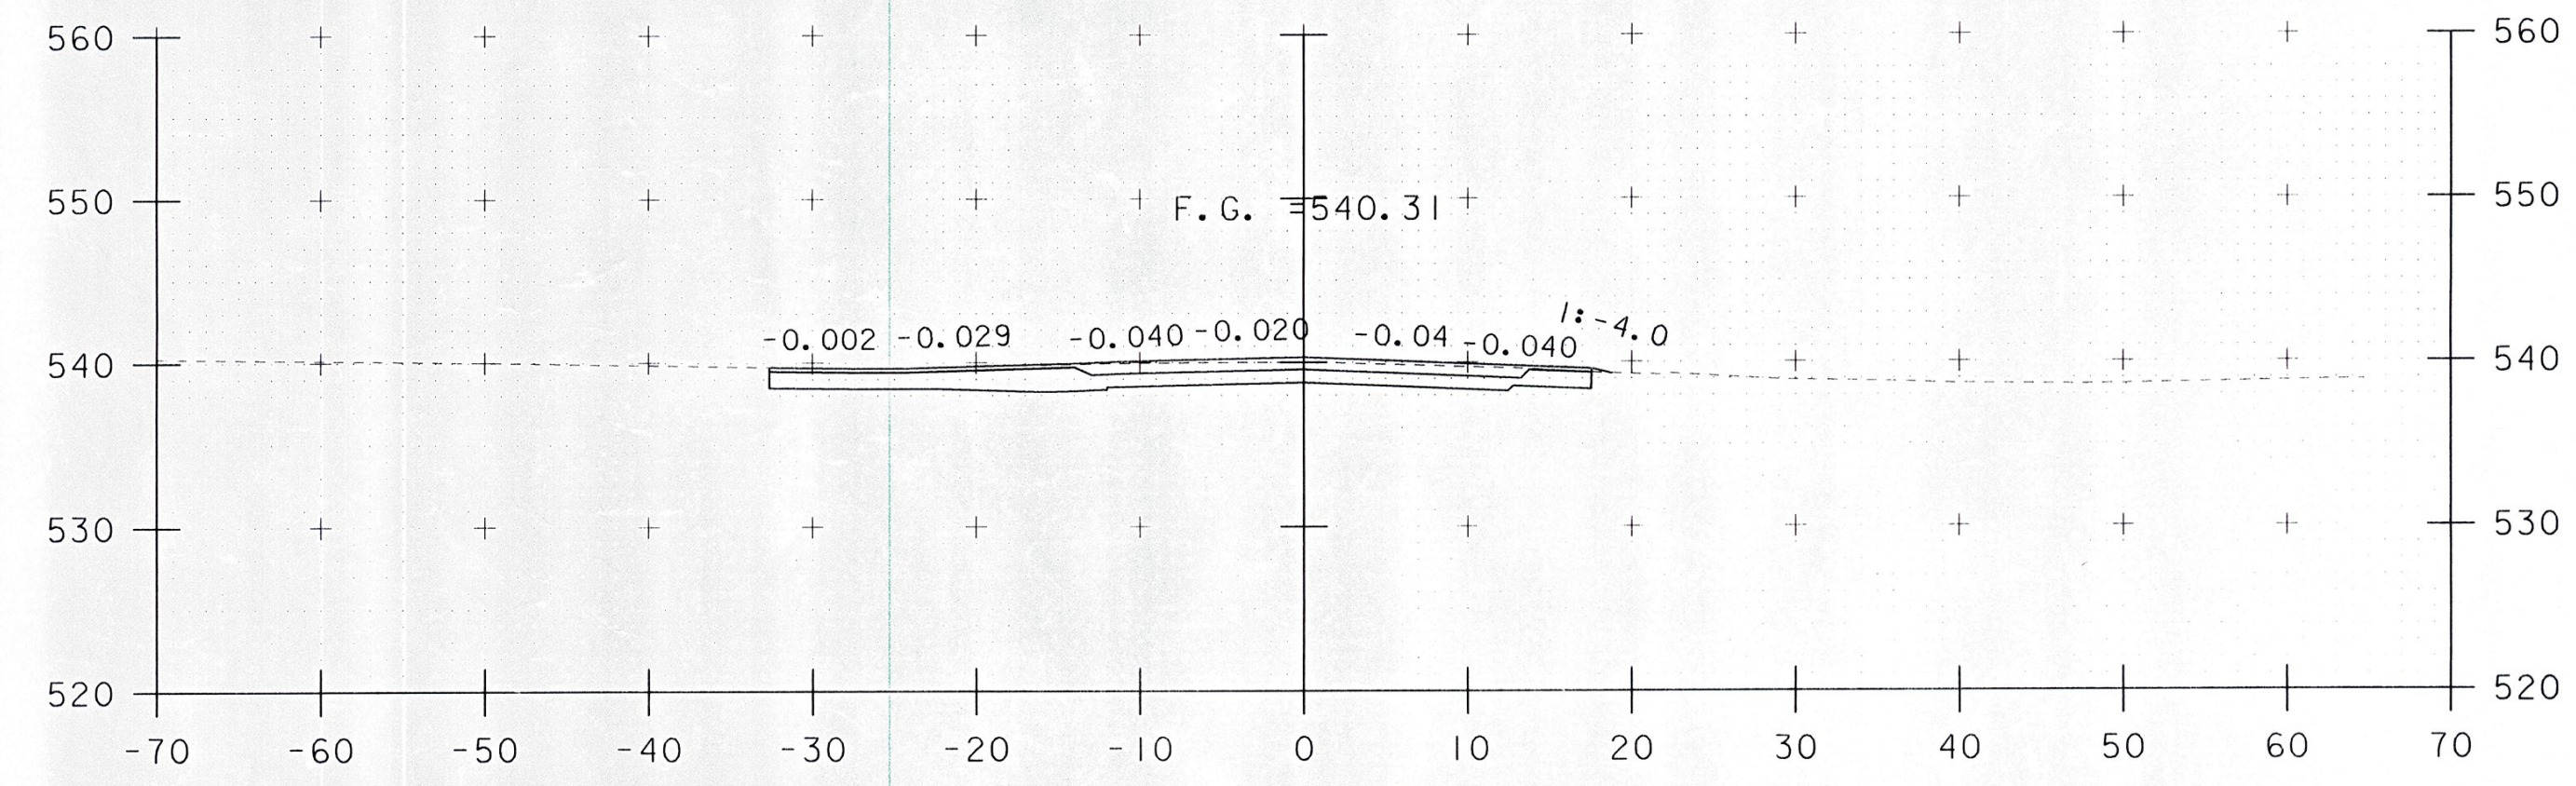

121+70
DRIVE LT & RT

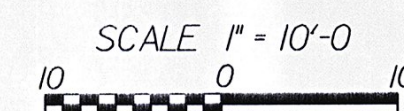

PROJECT NAME:	BETHEL	PLOT DATE:	20-MAY-2011
PROJECT NUMBER:	BRF 022-1(14)	DRAWN BY:	G. ROKES
FILE NAME:	78FIG1\STR\sfig1s.dgn	DESIGNED BY:	S. SCRIBNER
PROJECT LEADER:	M. EVANS-MONGEON	CHECKED BY:	S. SCRIBNER
			SHEET 107 OF 148

STA. 121+00 TO STA. 122+00