


NOTE CB PRECAST CONCRETE CATCH BASIN

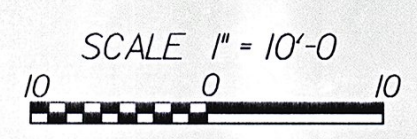

PROJECT NAME:	BETHEL	PLOT DATE:	20-MAY-2011
PROJECT NUMBER:	BRF 022-1(14)	DRAWN BY:	G. ROKES
FILE NAME:	78f161\STR\sf161xs.dgn	CHECKED BY:	S. SCRIBNER
PROJECT LEADER:	M. EVANS-MONGEON	SHEET	109 OF 148
DESIGNED BY:	S. SCRIBNER		
VT 107 CROSS SECTION SHEET 3			

STA. 122+75 TO STA. 123+75