



130+50
END APPROACH

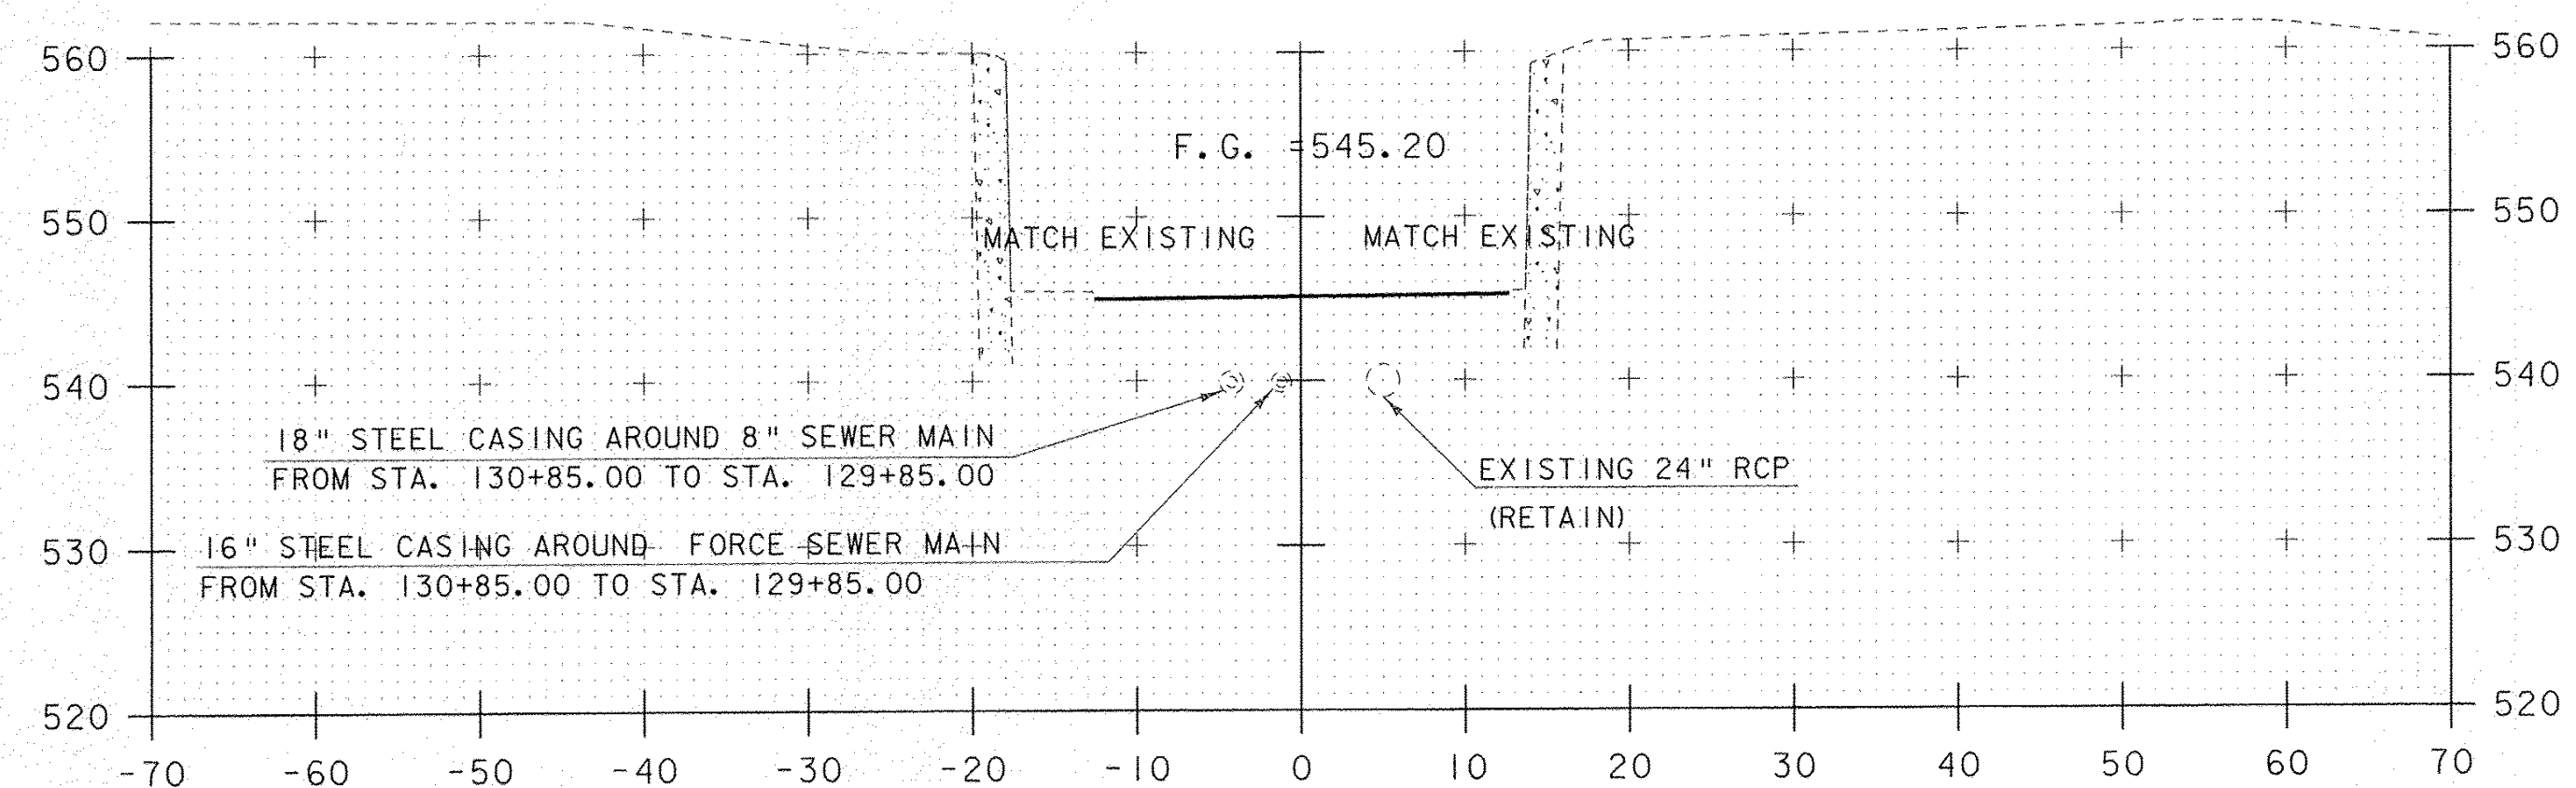

130+25

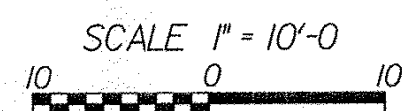

PROJECT NAME: BETHEL
PROJECT NUMBER: BRF 022-1(14)

FILE NAME: 78f161\STR\s161xs.dgn PLOT DATE: 20-MAY-2011
PROJECT LEADER: M. EVANS-MONGEON DRAWN BY: G. ROKES
DESIGNED BY: S. SCRIBNER CHECKED BY: S. SCRIBNER
VT 107 CROSS SECTION SHEET II SHEET 117 OF 148

STA. 130+25 TO STA. 130+50