


- A 58' 00" LT
- D 34'
- F 138' 1"
- T 144' 4"
- L 148'
- E 72'

- A 59' 11"
- B 74'
- C 77' 4"
- T 144' 4"
- L 139' 2"
- E 41' 9"

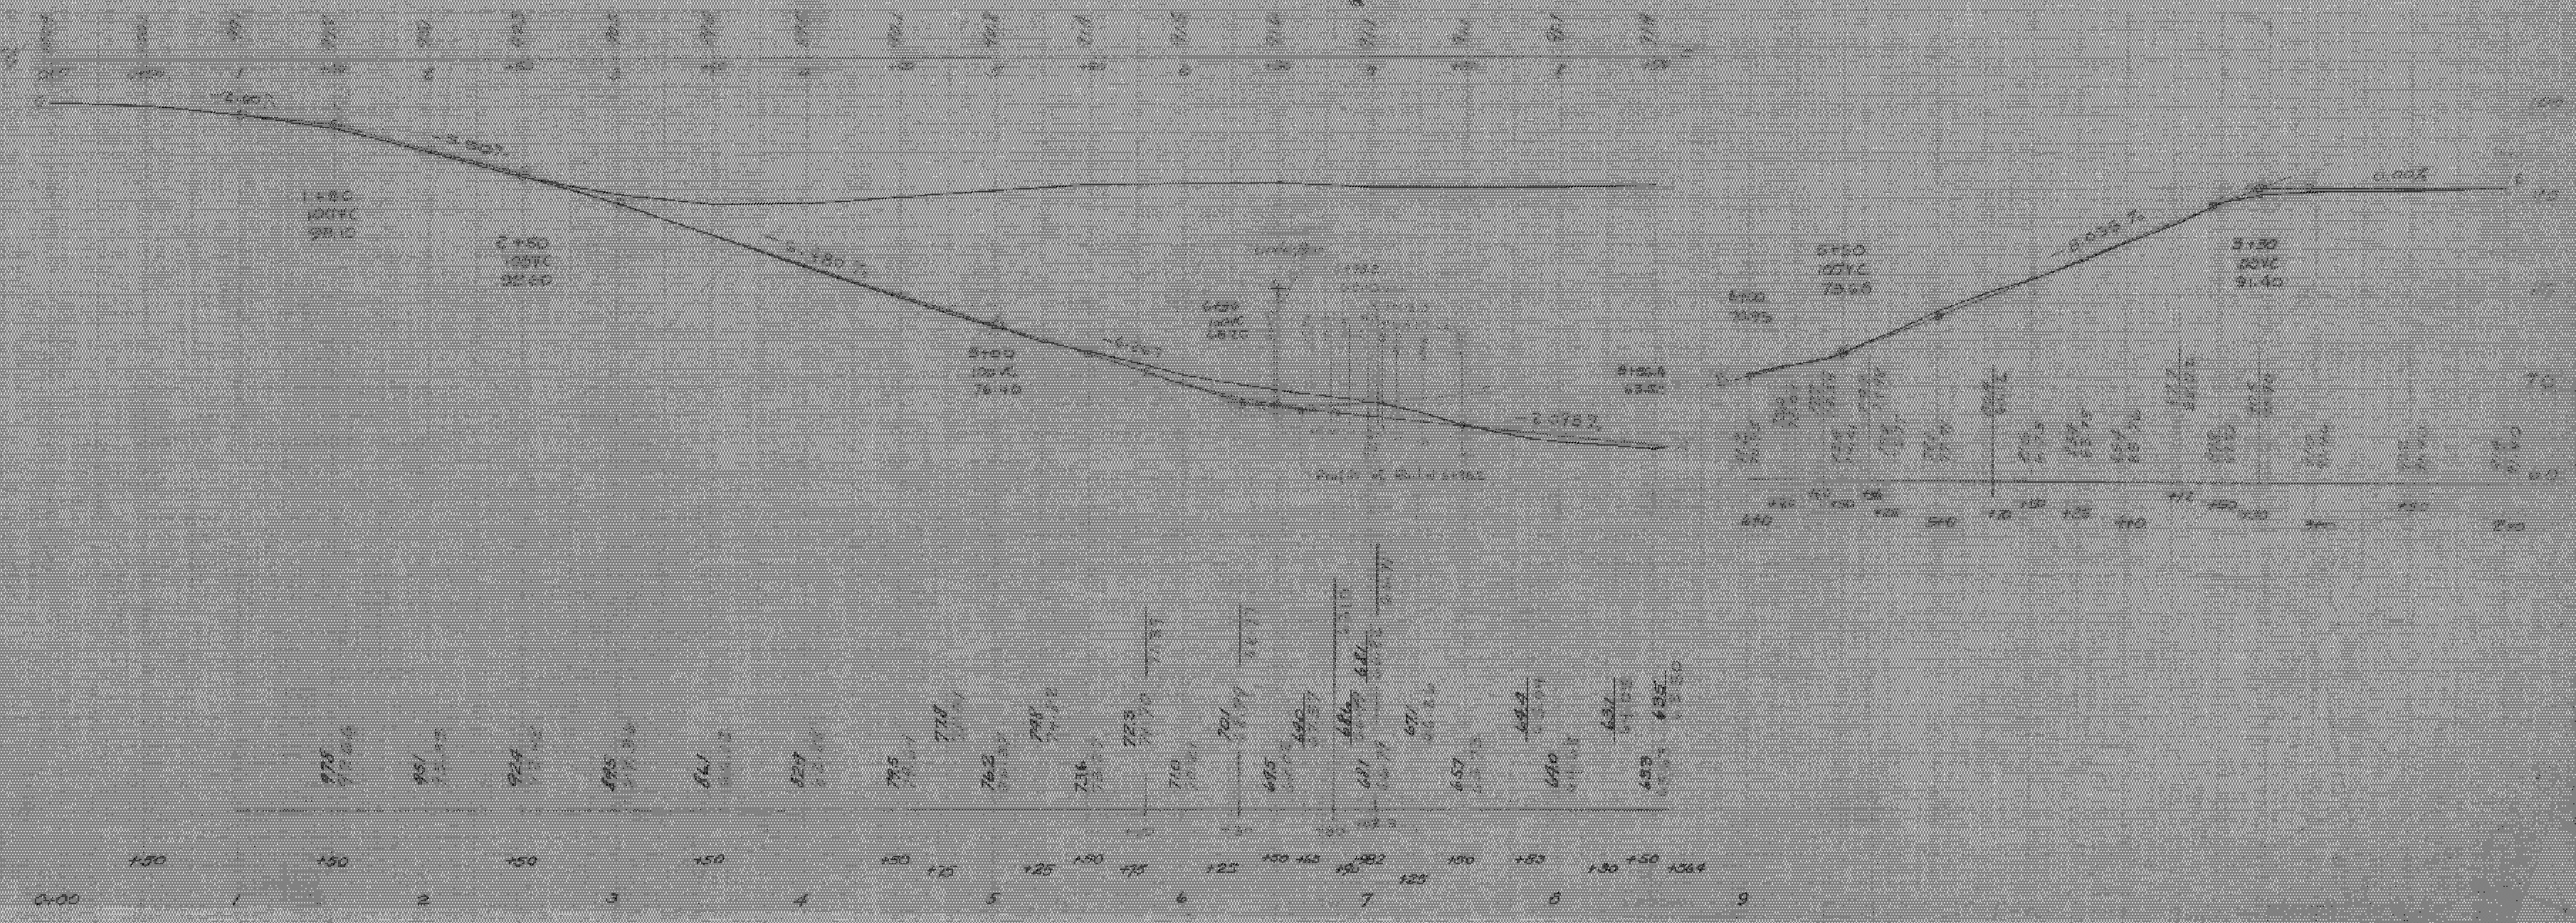

775	957	924	885	841	827	795	765	734	723	710	683	671	657	640	637	625
775	957	924	885	841	827	795	765	734	723	710	683	671	657	640	637	625