


34 1928 18

1928 STRUCTURAL PLAN SHEET 18
 FILE NAME: s78f161plans1928_b.dgn
 PROJECT LEADER: M. EVANS-MONGEON
 REFERENCE ONLY
 SHEET 139 OF 148

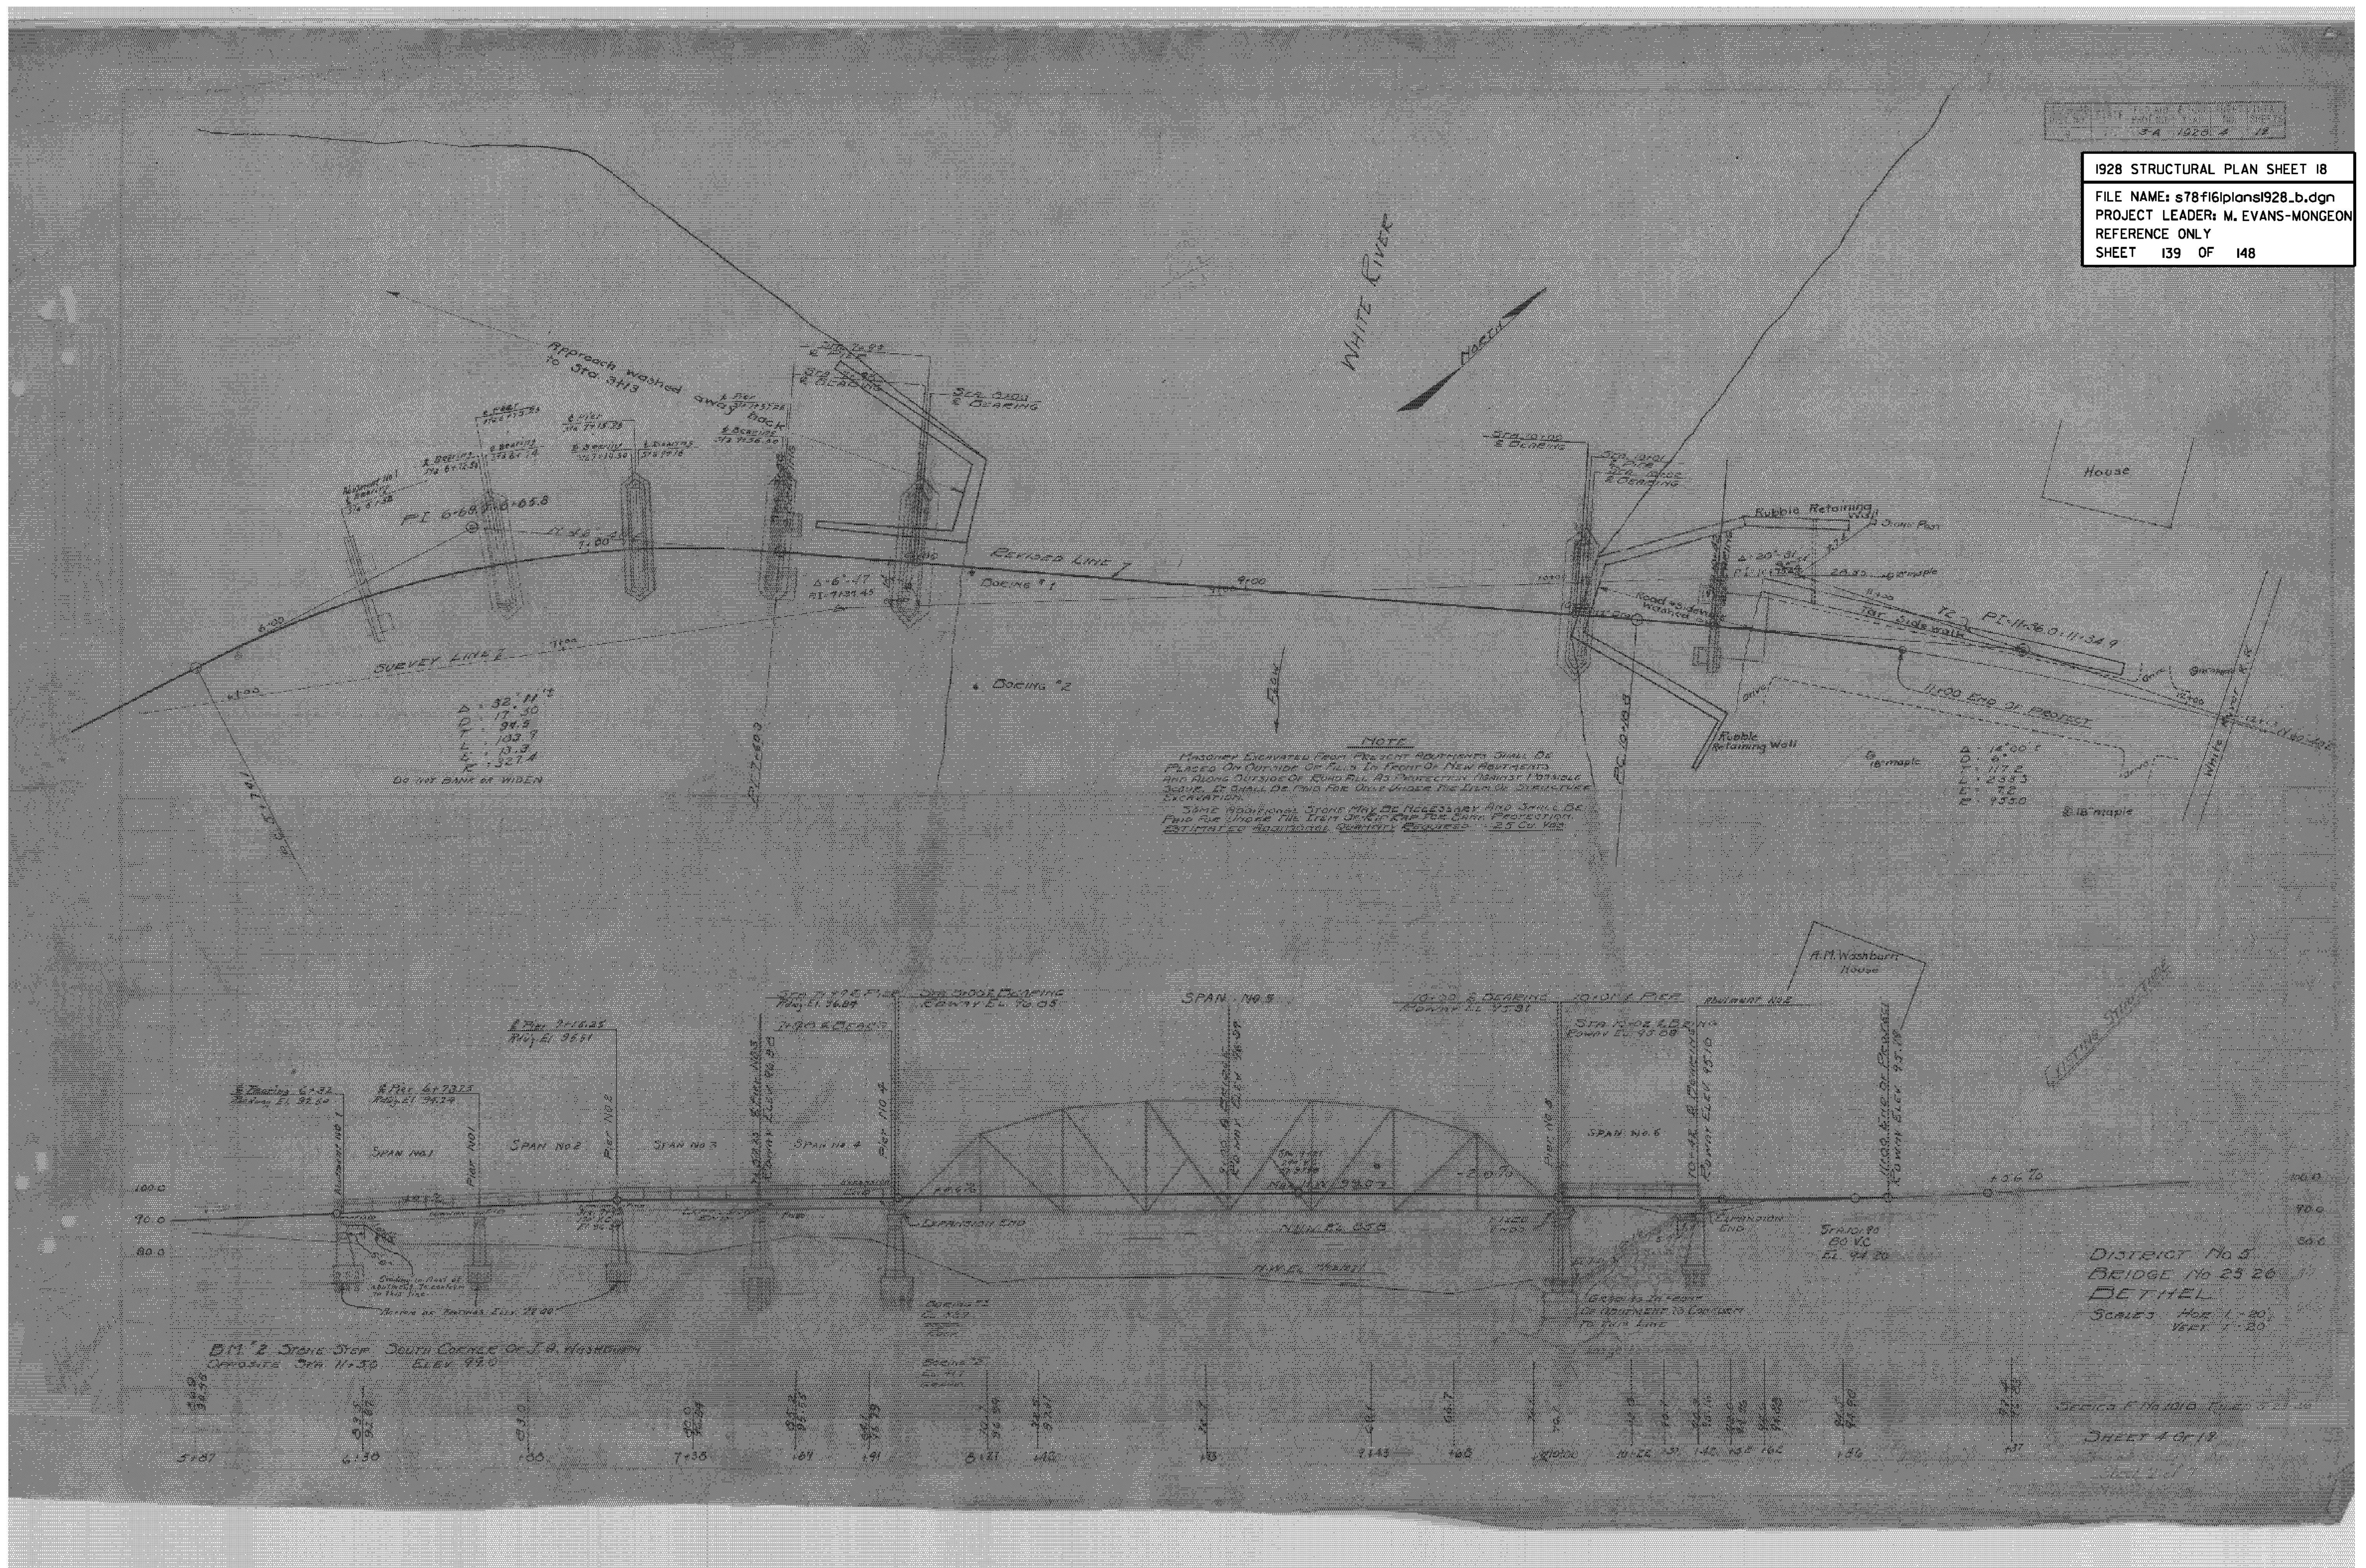

DISTRICT No. 5
 BRIDGE No. 25 26
 BETHEL
 SCALE: HOR. 1"=20'
 VERT. 1"=20'

Sheet 4 of 19