


PLAN OF APPROACH SPANS ON CURVE
 Scale: $\frac{3}{16}'' = 1'-0''$
 All spans to be identical.

Details for non work shall be made to fit the existing fabricated work. Details of fabricated work will be furnished on request.

NOTES:-
 FOR REFERENCE NOTES & SECTIONS A-A, B-B SEE SERIES FRP-3A - SHEET NO. 8

Stations shown are along ϕ of curve & piers and abutments are on radial lines. Painting for new work to be same as required for fabricated work - see Standard Sheet SB-1 Detail S-21.

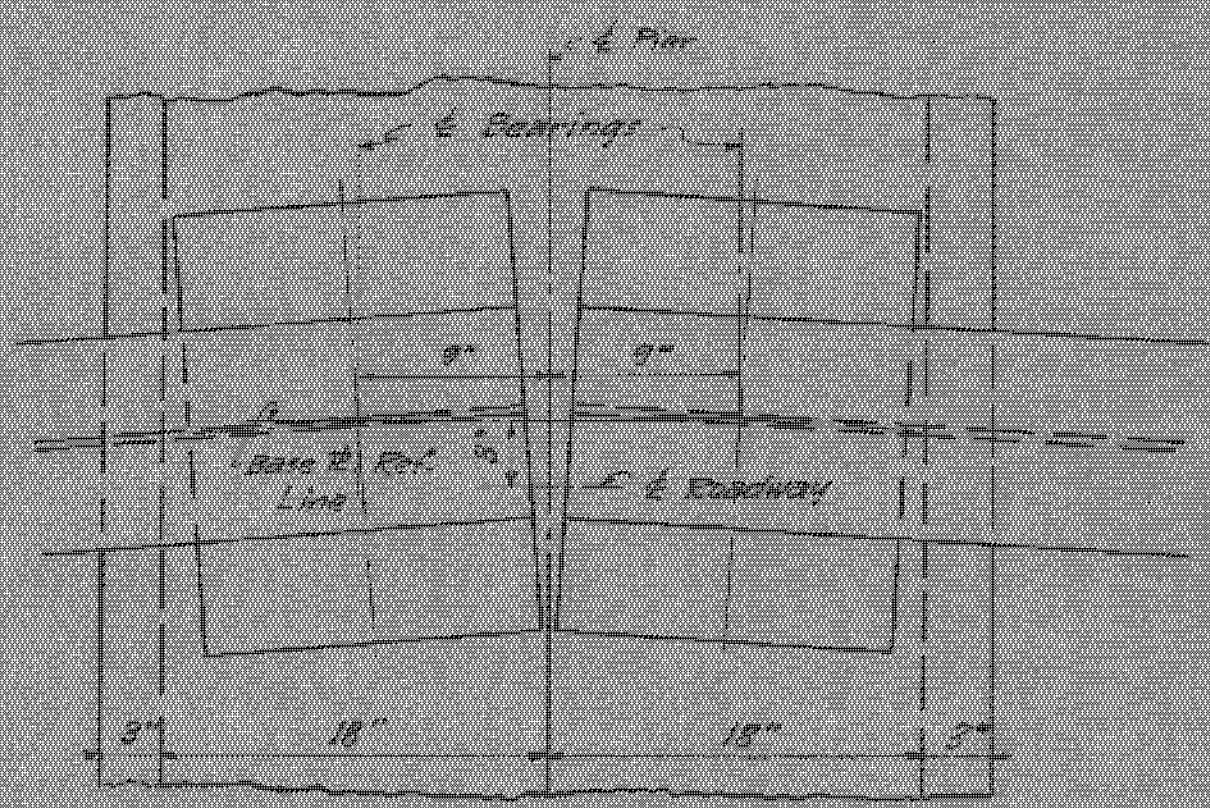

PLAN OF BASE ϕ s
 Scale: $\frac{1}{2}'' = 1'-0''$

PLAN OF APPROACH SPANS 1, 2, 3.
 WATER STREET BRIDGE OVER WHITE RIVER
 BETHEL, VT.

QUANTITIES FOR 3 ROUTINE SPANS

ESTIMATED QUANTITIES	
STRUCTURAL STEEL	72,000 Lbs.
REINFORCING STEEL	16,500 Lbs.
CONCRETE CLASS (1-2-4)	88 Cu Yds.

Designed by S.S.
 Drawn by D.S.
 Traced by J.C. 10-18-38
 Checked by W.F. Danks 11-1-38
 Series FRP No. 3A
 Sheet 7 of 19 Sheets