



SECTION "AA"  
 Scale 1/2" = 1'-0"


FOR DETAIL OF DRAIN SEE SHEET C OF 15.  
 IF IMPOSSIBLE TO BUILD DRAIN PIPE VERTICAL,  
 IT SHALL BE BUILT AS DIRECTED BY THE  
 ENGINEER IN THE FIELD.

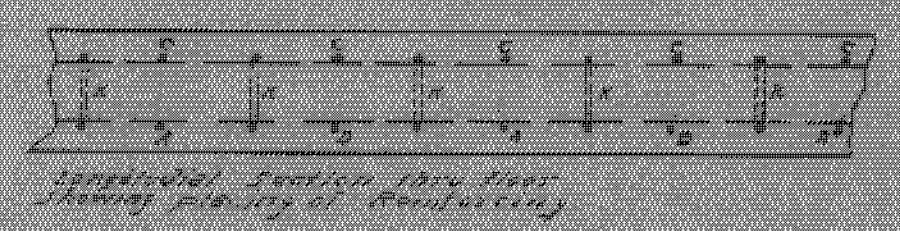

Simplified section showing  
 general position of reinforcement

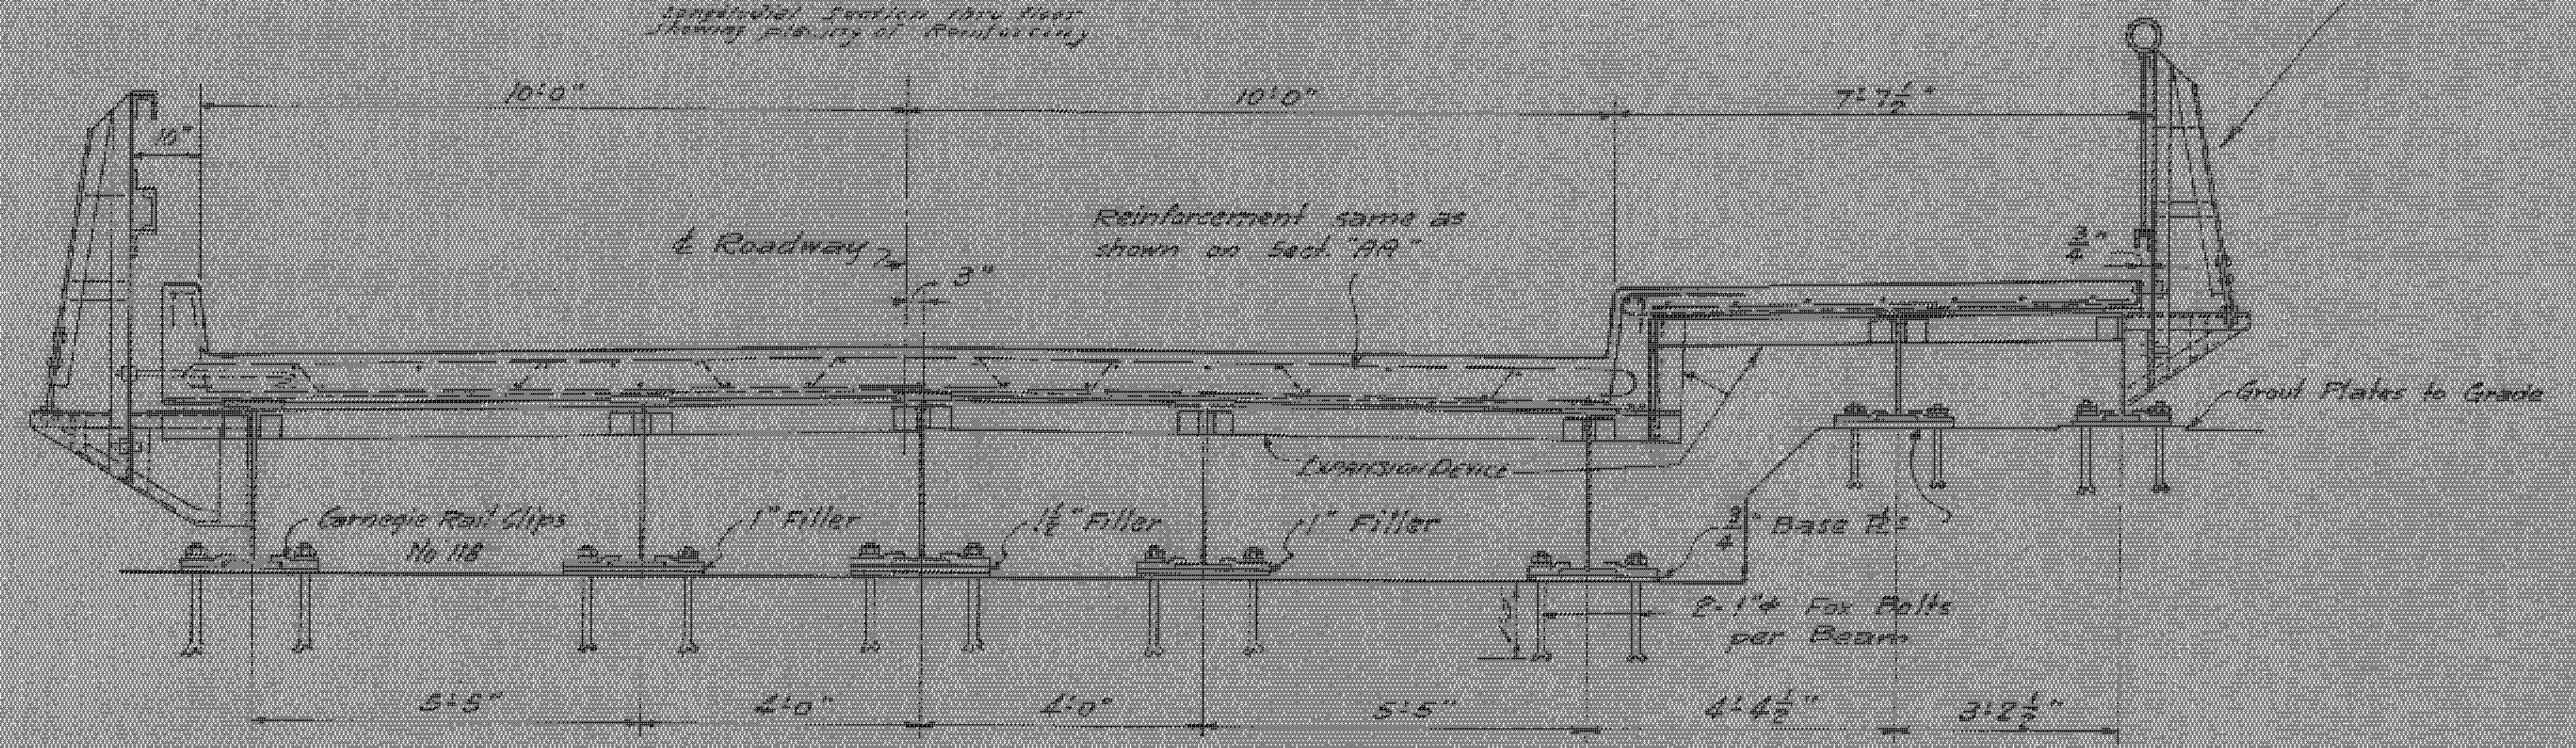

"BB"  
 Scale 1/2" = 1'-0"

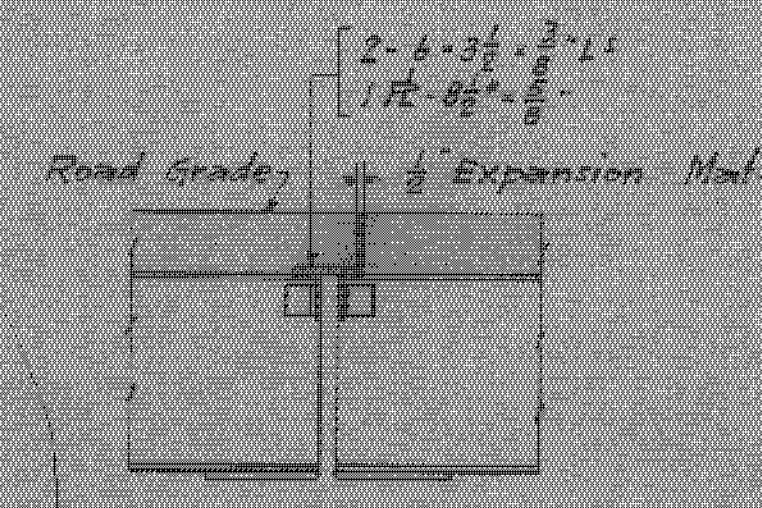

SLAB DETAIL AT PIERS  
 Scale 1/2" = 1'-0"

Similar at Sidewalk

NOTE: FOR DETAIL OF DRAIN SEE SERIES 36-20-16-202 (General Draw #6.)  
 (To be modified in field if necessary.)

References:  
 For further details use following Standard Details and  
 Types shown on Sta. 581: 513, 514, 519, 521, 524, 525, 526, 527, 528, 529,  
 Slab Reinforcement same as for Approach span on Tangent  
 For Plan & Estimated Quantities see Series FRP 39 Sheet No.

FOR THE STRUCTURE

SPANS 1, 2, 3.  
 APPROACH SPAN DETAILS  
 WATER STREET BRIDGE OVER WHITE RIVER  
 BETHEL, VT.

Drawn by: [Signature]  
 Designed by: [Signature]  
 Checked by: [Signature]  
 Series FRP No. 3A  
 Sheet 8 of 19 Sheets