



**ONE REQ'D ~ ROADWAY BEND TOP RAIL 'TA10'**  
(16'-0 3/16" LGTH ALONG LONGEST EDGE)

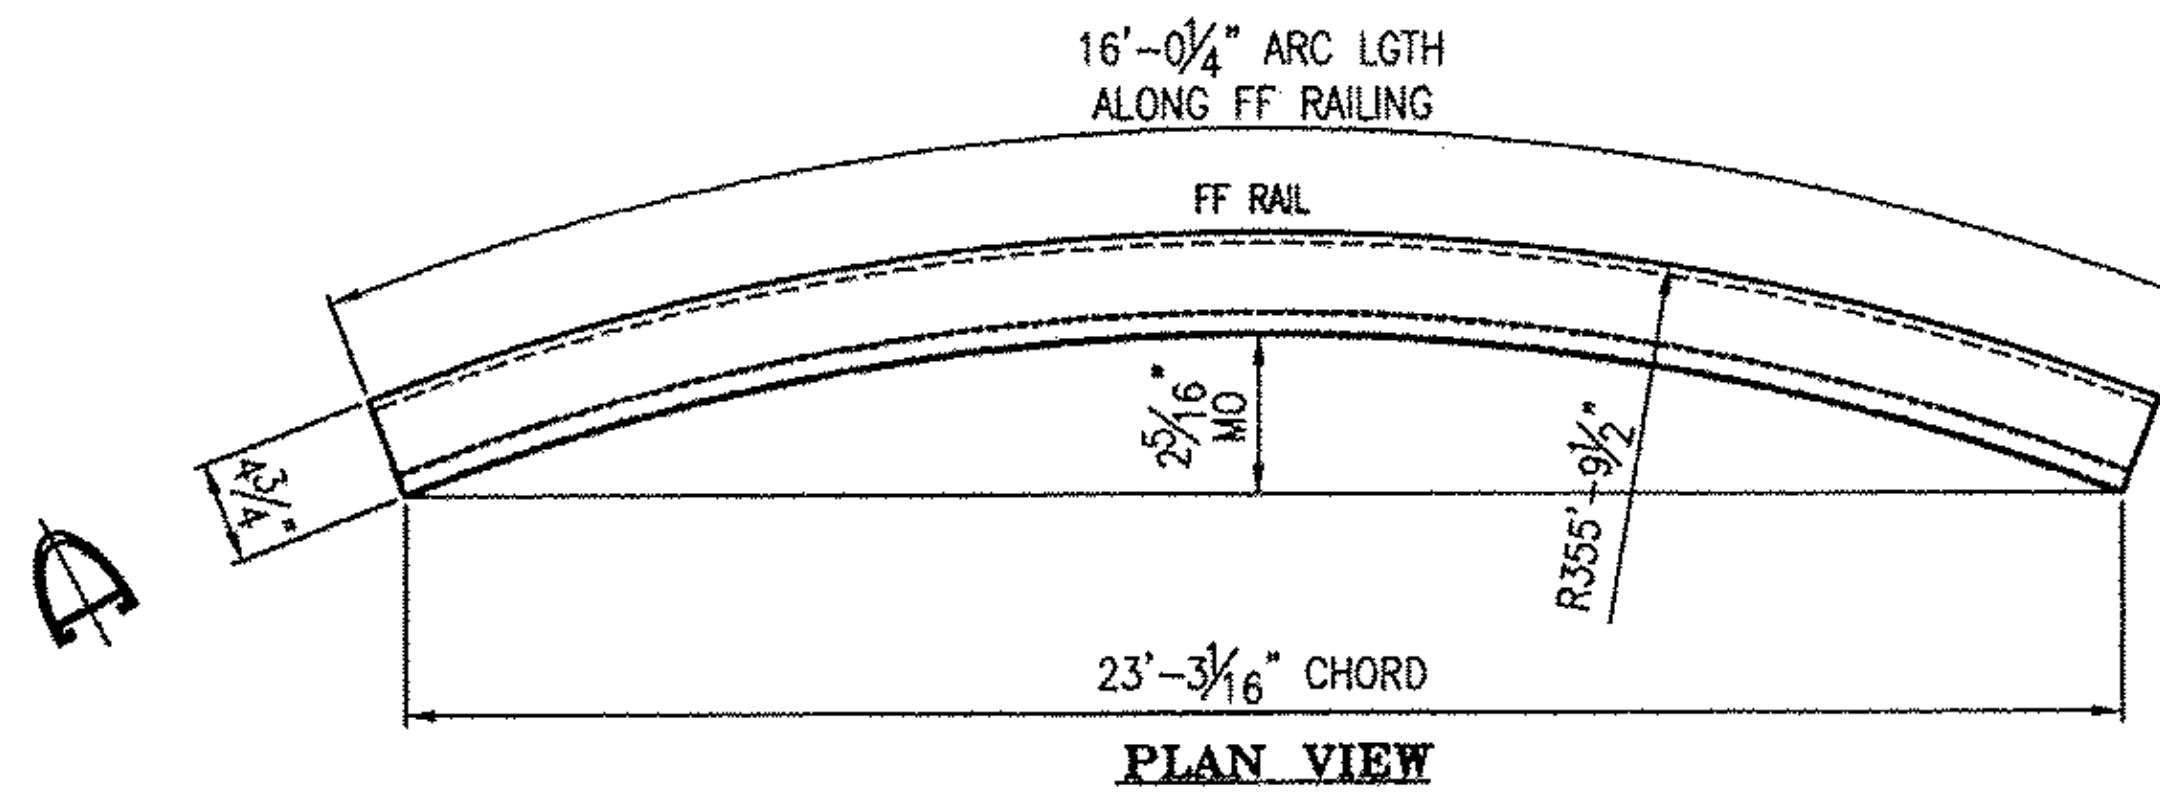

**ONE REQ'D ~ ROADWAY BEND MIDDLE RAIL 'MA10'**  
(16'-0 1/4" LGTH ALONG FF RAIL)

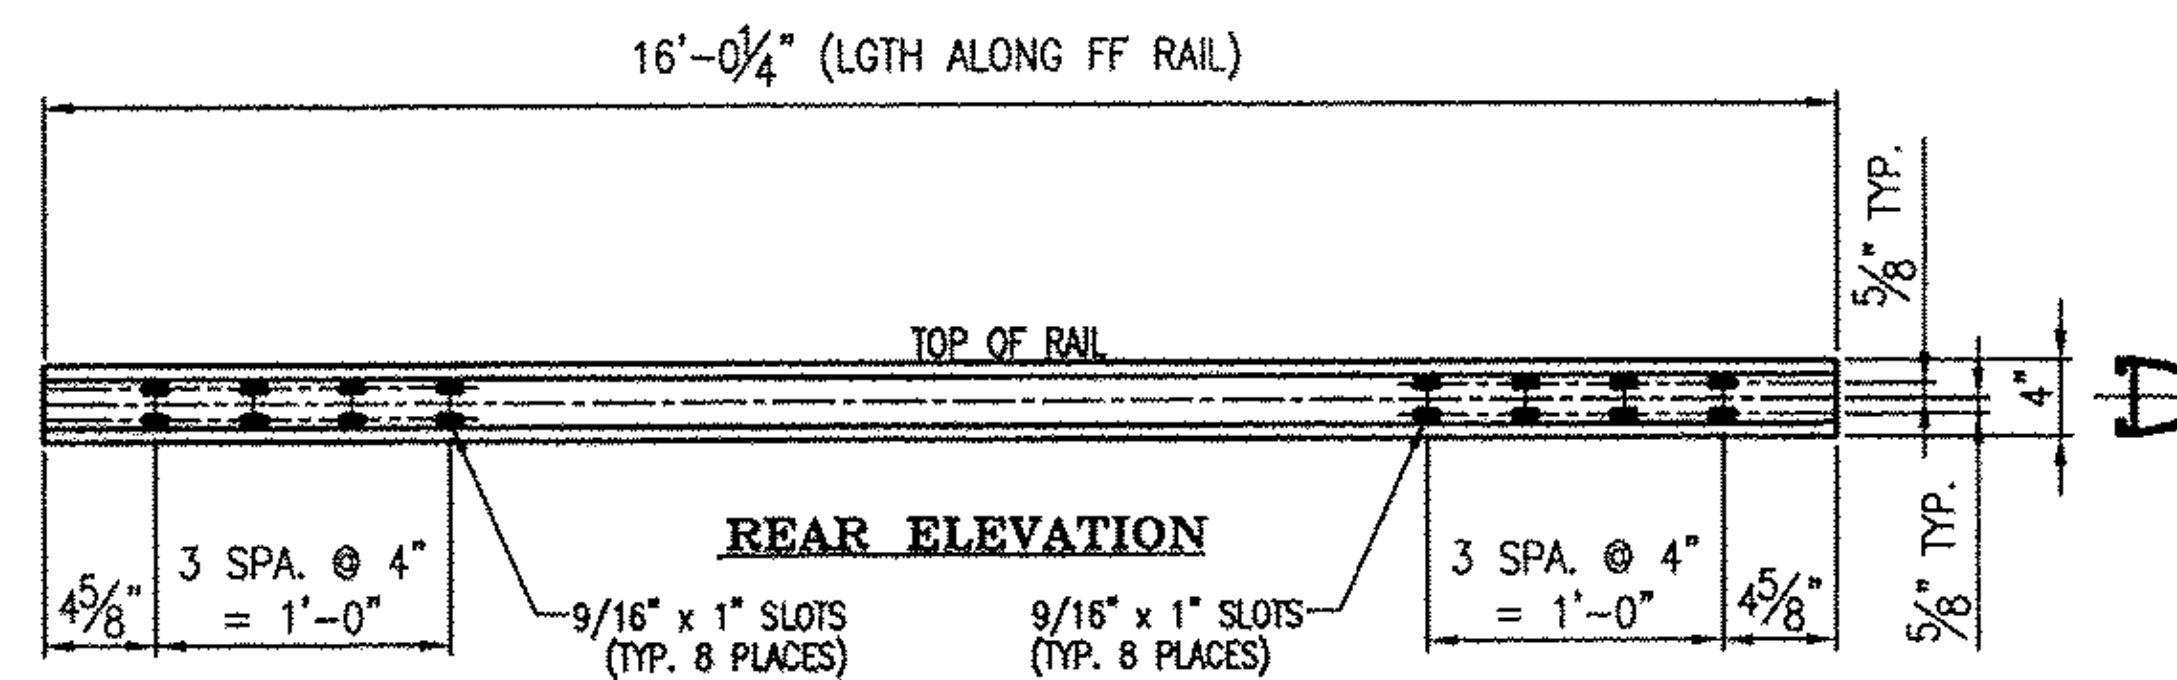

**ONE REQ'D ~ ROADWAY BEND BOTTOM RAIL 'BA10'**  
(16'-0 1/4" LGTH ALONG FF RAIL)

RECEIVED  
OK'D BY WBL OK'D BY SSB

OCT 24 2011  
RESUBMIT \_\_\_\_\_ APPROVED   
BY \_\_\_\_\_ DATE 11/1/2011

BRIDGE No. 15  
PROJECT No. BRF 022-1 (14)  
ITEM No: 525.22

**LB Foster**  
Fabricated Bridge Products  
L.B. FOSTER COMPANY  
1016 GREENTREE RD.  
PITTSBURGH, PA 15220

FOR: F. R. LAFAYETTE, INC.  
VERMONT AGENCY OF TRANSPORTATION  
TOWN OF BETHEL, WINDSOR COUNTY, VT  
3-LINE ALUMINUM BRIDGE RAIL FOR VT ROUTE 7  
(MINOR ARTERIAL)(CURBSIDE) -- RAIL DETAILS

REV.	DESCRIPTION	BY	DATE	CHECK	DATE	DRAWING	REV. NO.

MADE CMS DATE 09/20/11 JOB NO. AR0700  
CHECKED DATE 10/12/11 DRAWING LB7