



PLAN VIEW

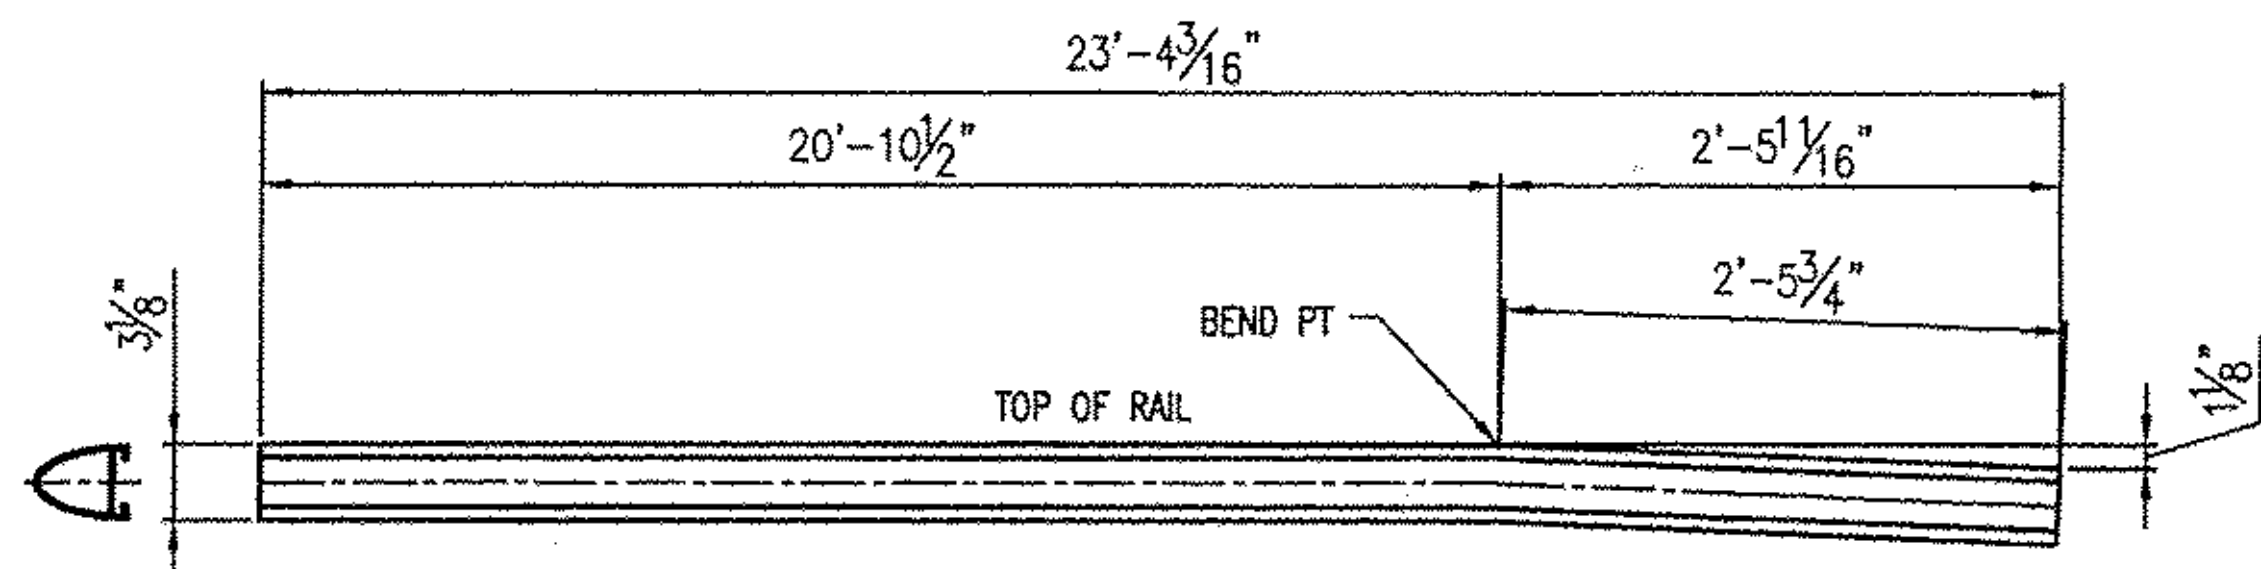


REAR ELEVATION

ONE REQ'D ~ COMPOUND BENT TOP RAIL 'TA11'
(23'-4 1/4" LGTH ALONG LONGEST EDGE)

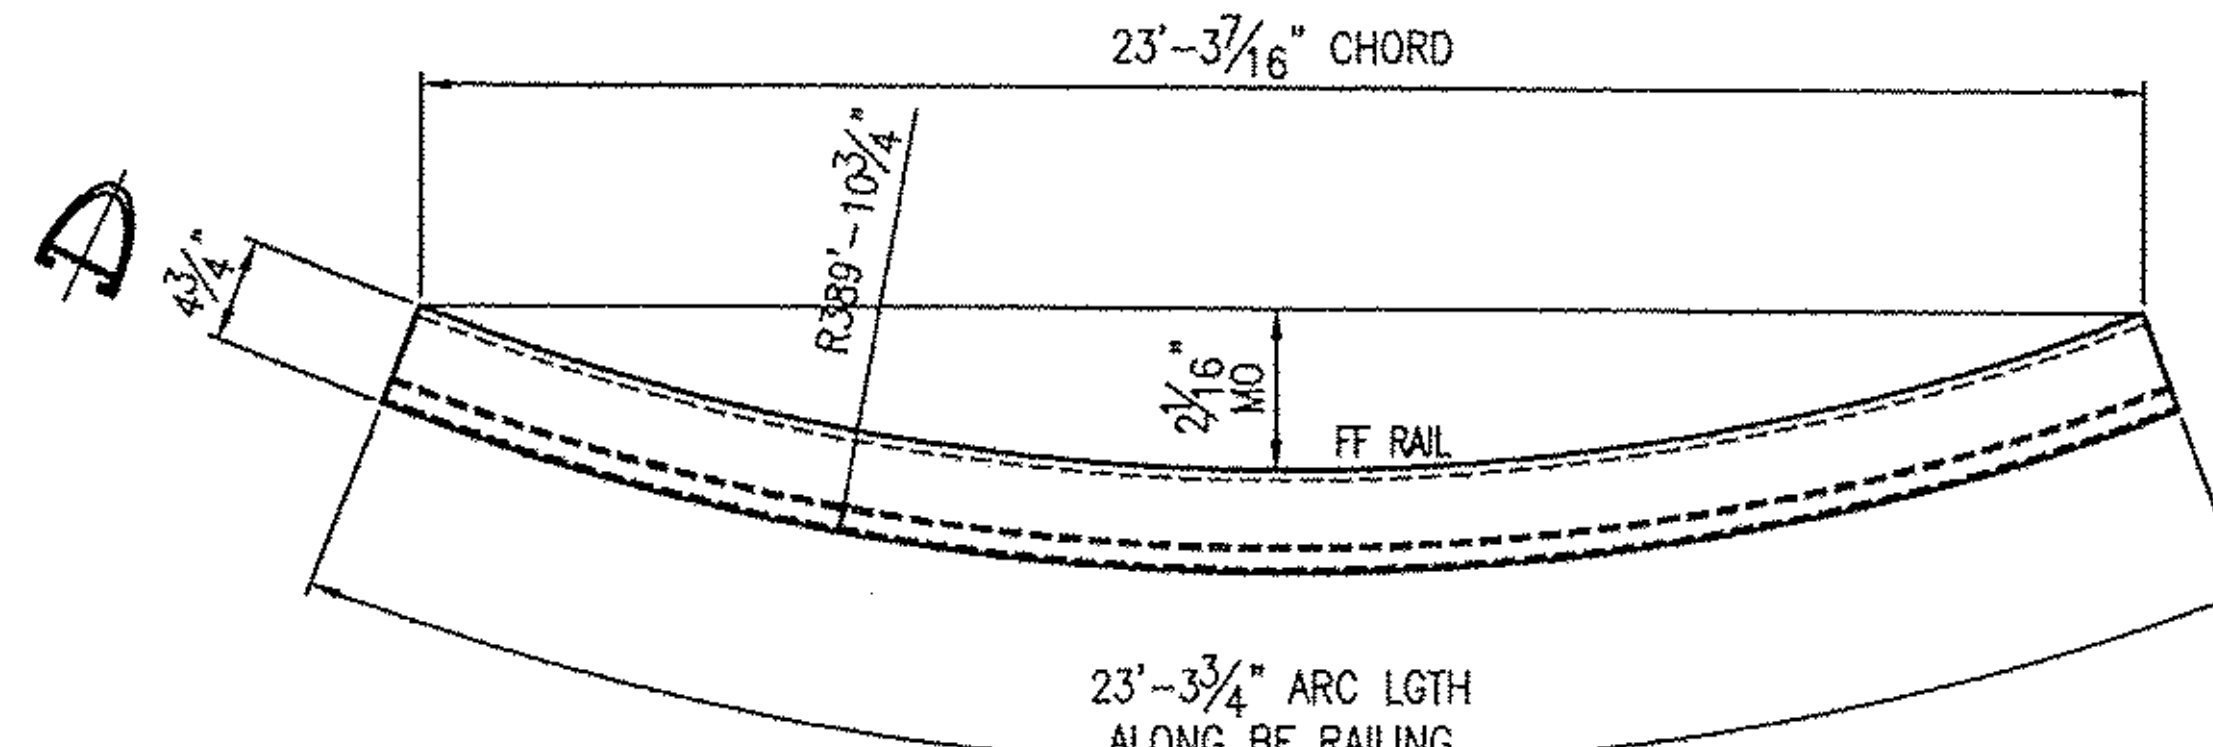


PLAN VIEW

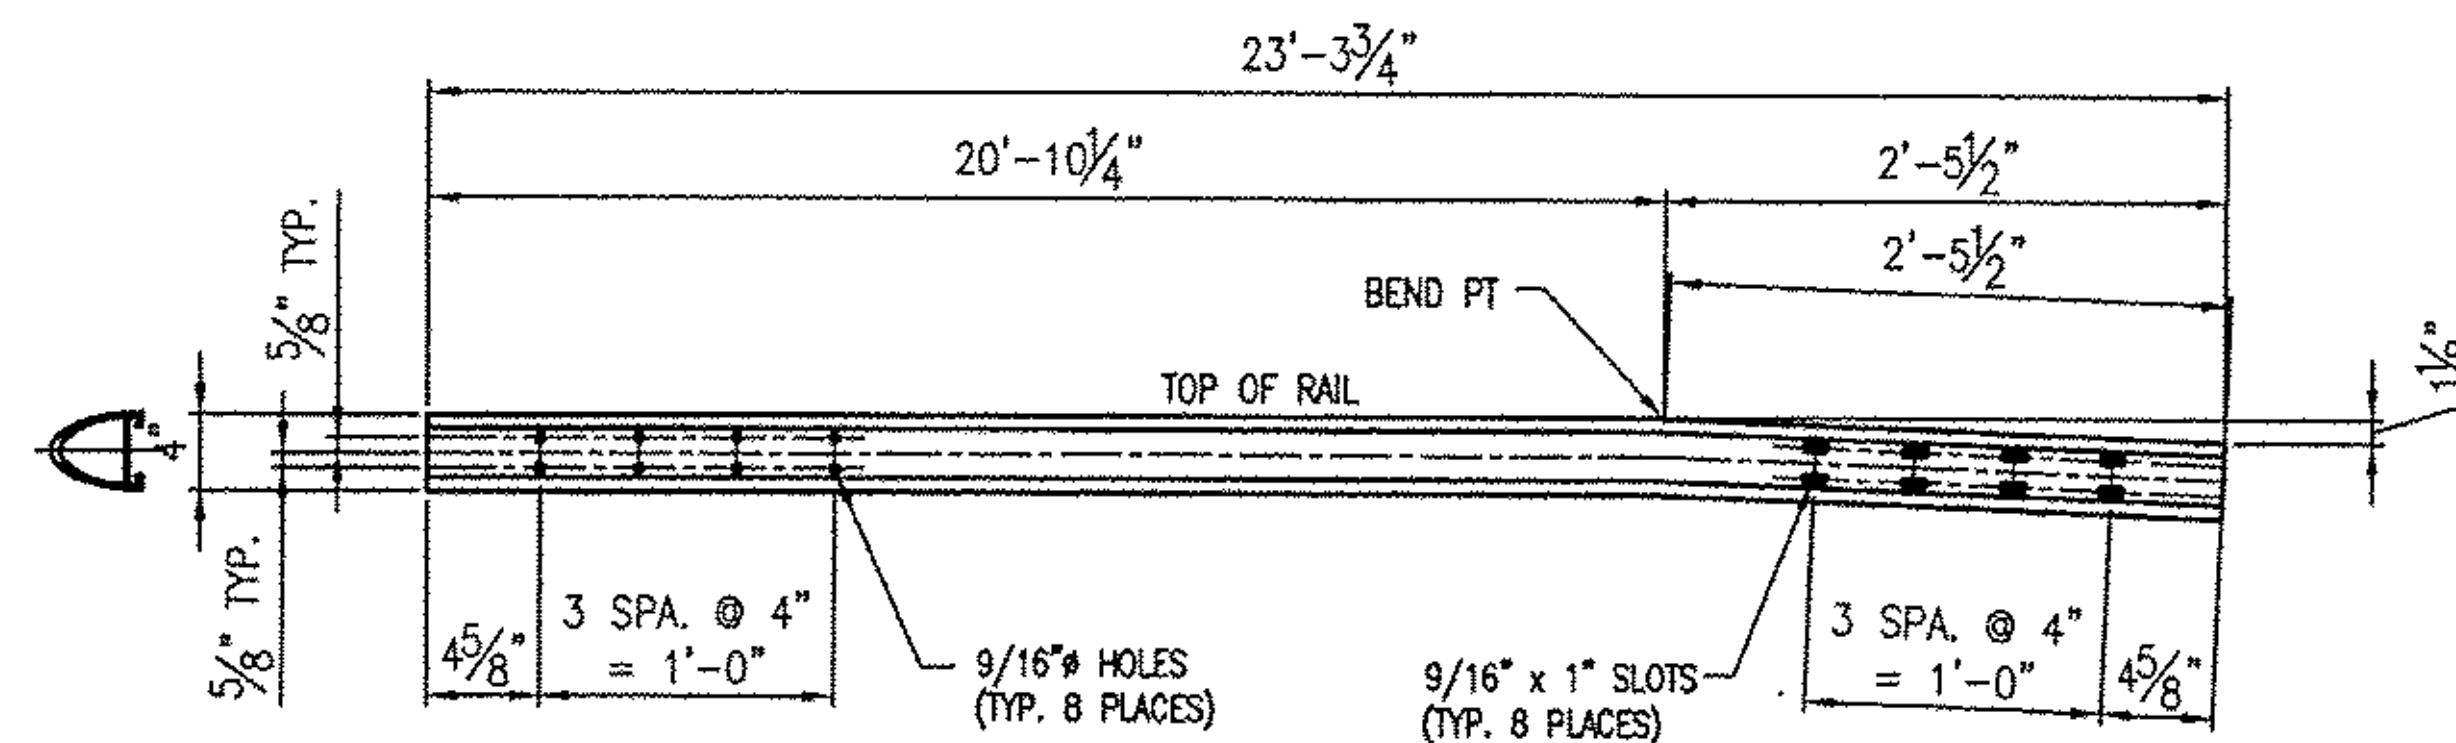


REAR ELEVATION

ONE REQ'D ~ COMPOUND BENT MIDDLE RAIL 'MA11'
(23'-3 3/4" LGTH ALONG LONGEST EDGE)

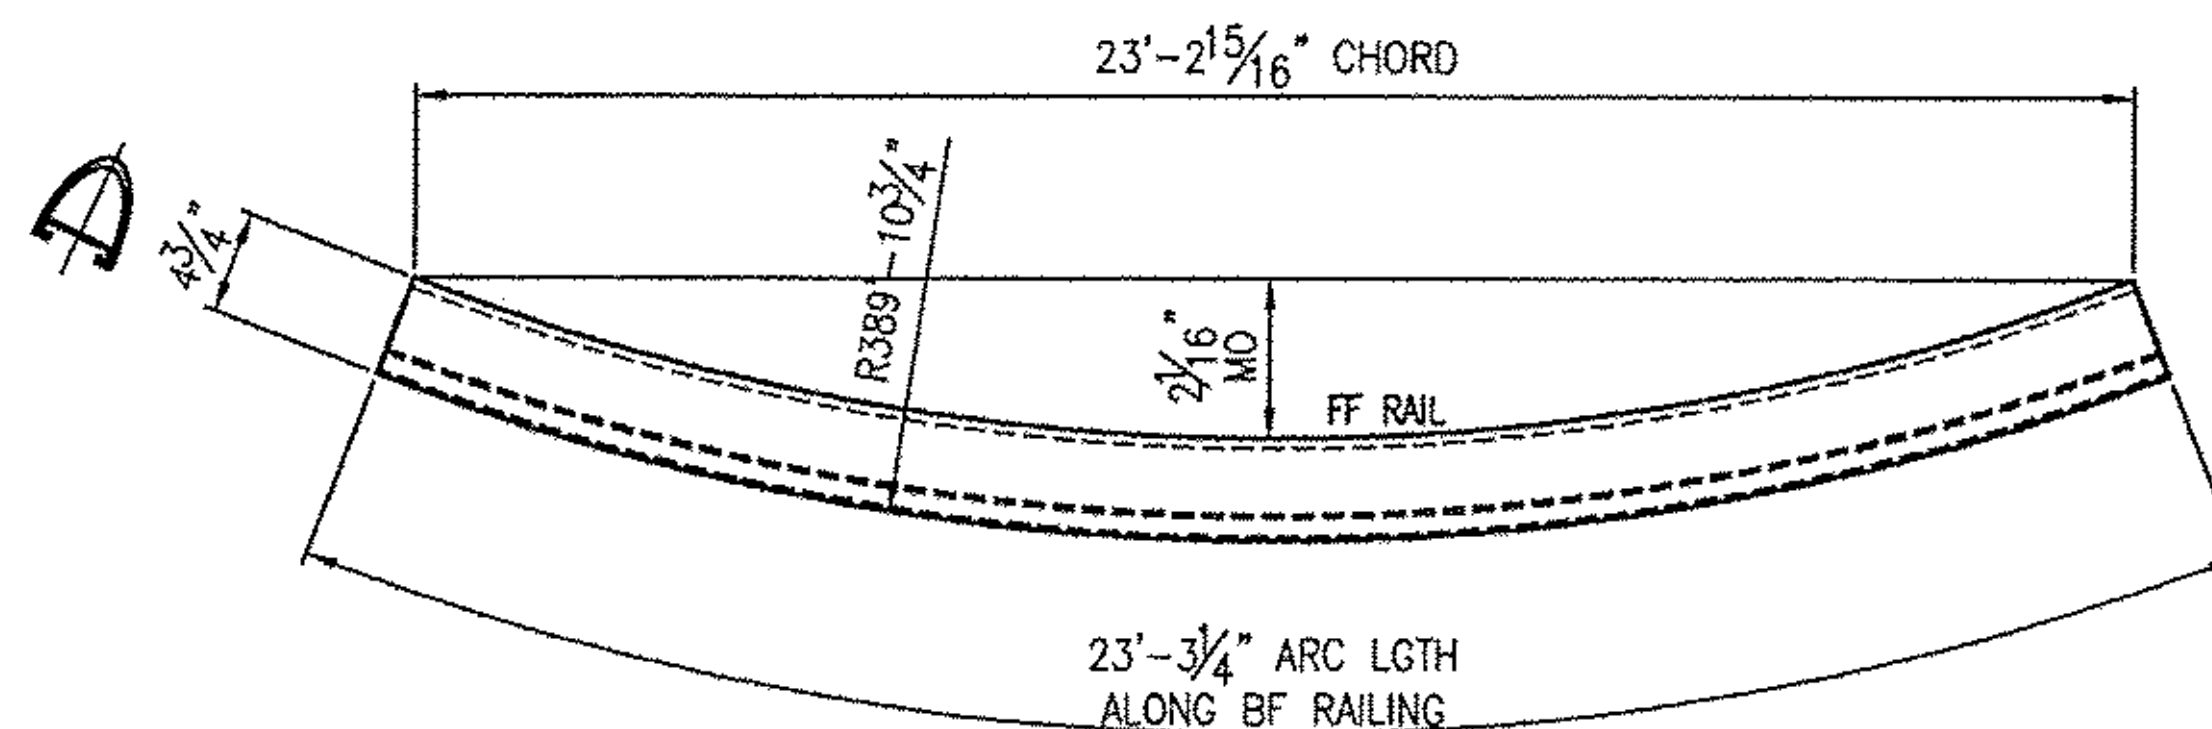


PLAN VIEW

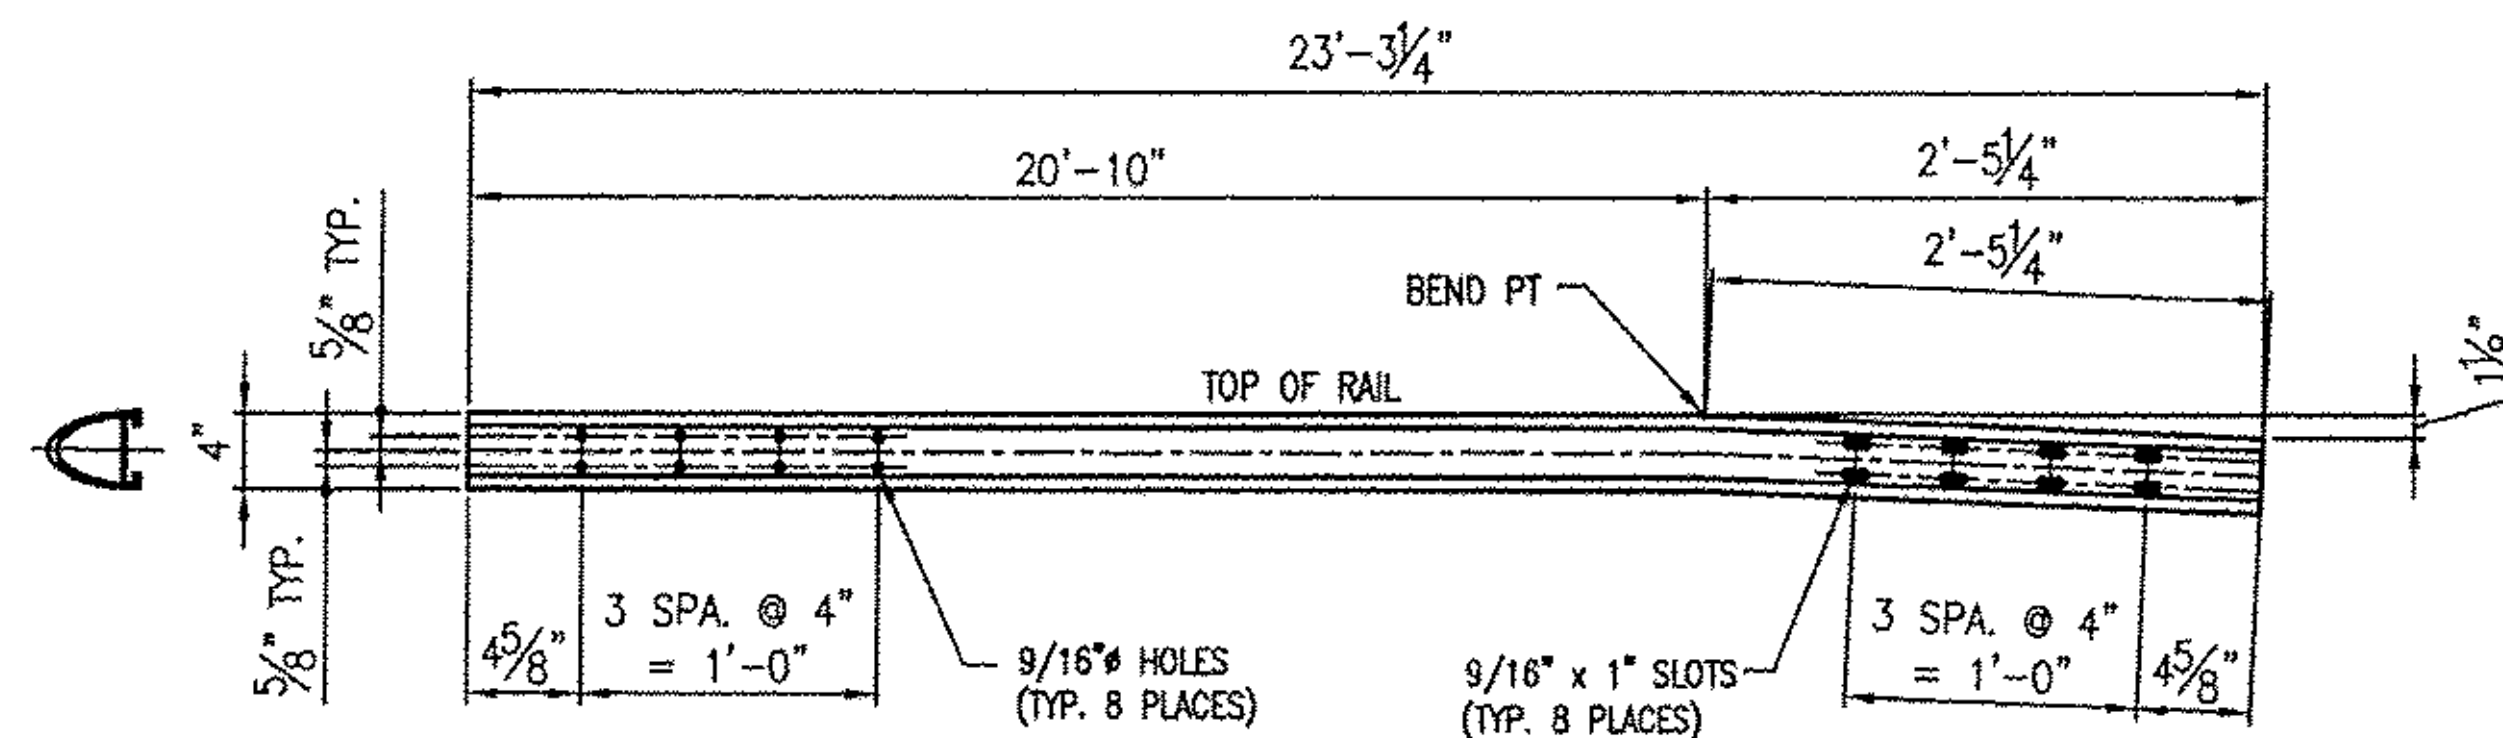

REAR ELEVATION

ONE REQ'D ~ COMPOUND BENT BOTTOM RAIL 'BA11'
(23'-3 1/4" LGTH ALONG LONGEST EDGE)

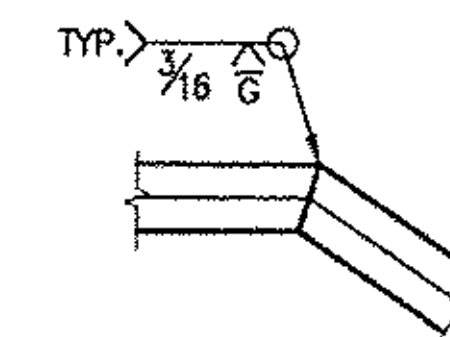

TYPICAL WELD DETAIL
(OPTIONAL IF REQ'D.)

RECEIVED
 CK'D BY WBP CK'D BY SSS
 OCT 24 2011
 RESUBMIT _____ APPROVED
 BY _____ DATE 11/1/2011

BRIDGE No. 15
 PROJECT No. BR 022-1 (14) ITEM No: 525.23

LB Foster L.B. FOSTER COMPANY
 Fabricated Bridge Products 1016 GREENTREE RD.
 PITTSBURGH, PA 15220

FOR: F. R. LAFAYETTE, INC.
 VERMONT AGENCY OF TRANSPORTATION
 TOWN OF BETHEL, WINDSOR COUNTY, VT
 3-LINE ALUMINUM BRIDGE RAIL FOR VT ROUTE 7
 (MINOR ARTERIAL)(SIDEWALK) - RAIL DETAILS

MADE CMS DATE 09/22/11 JOB NO. AR0700

CHECK Dd DATE 10/12/11 DRAWING LB10

REV.	DESCRIPTION	BY	DATE