


SS = SHORT SLOTTED SIDE
LS = LONG SLOTTED SIDE

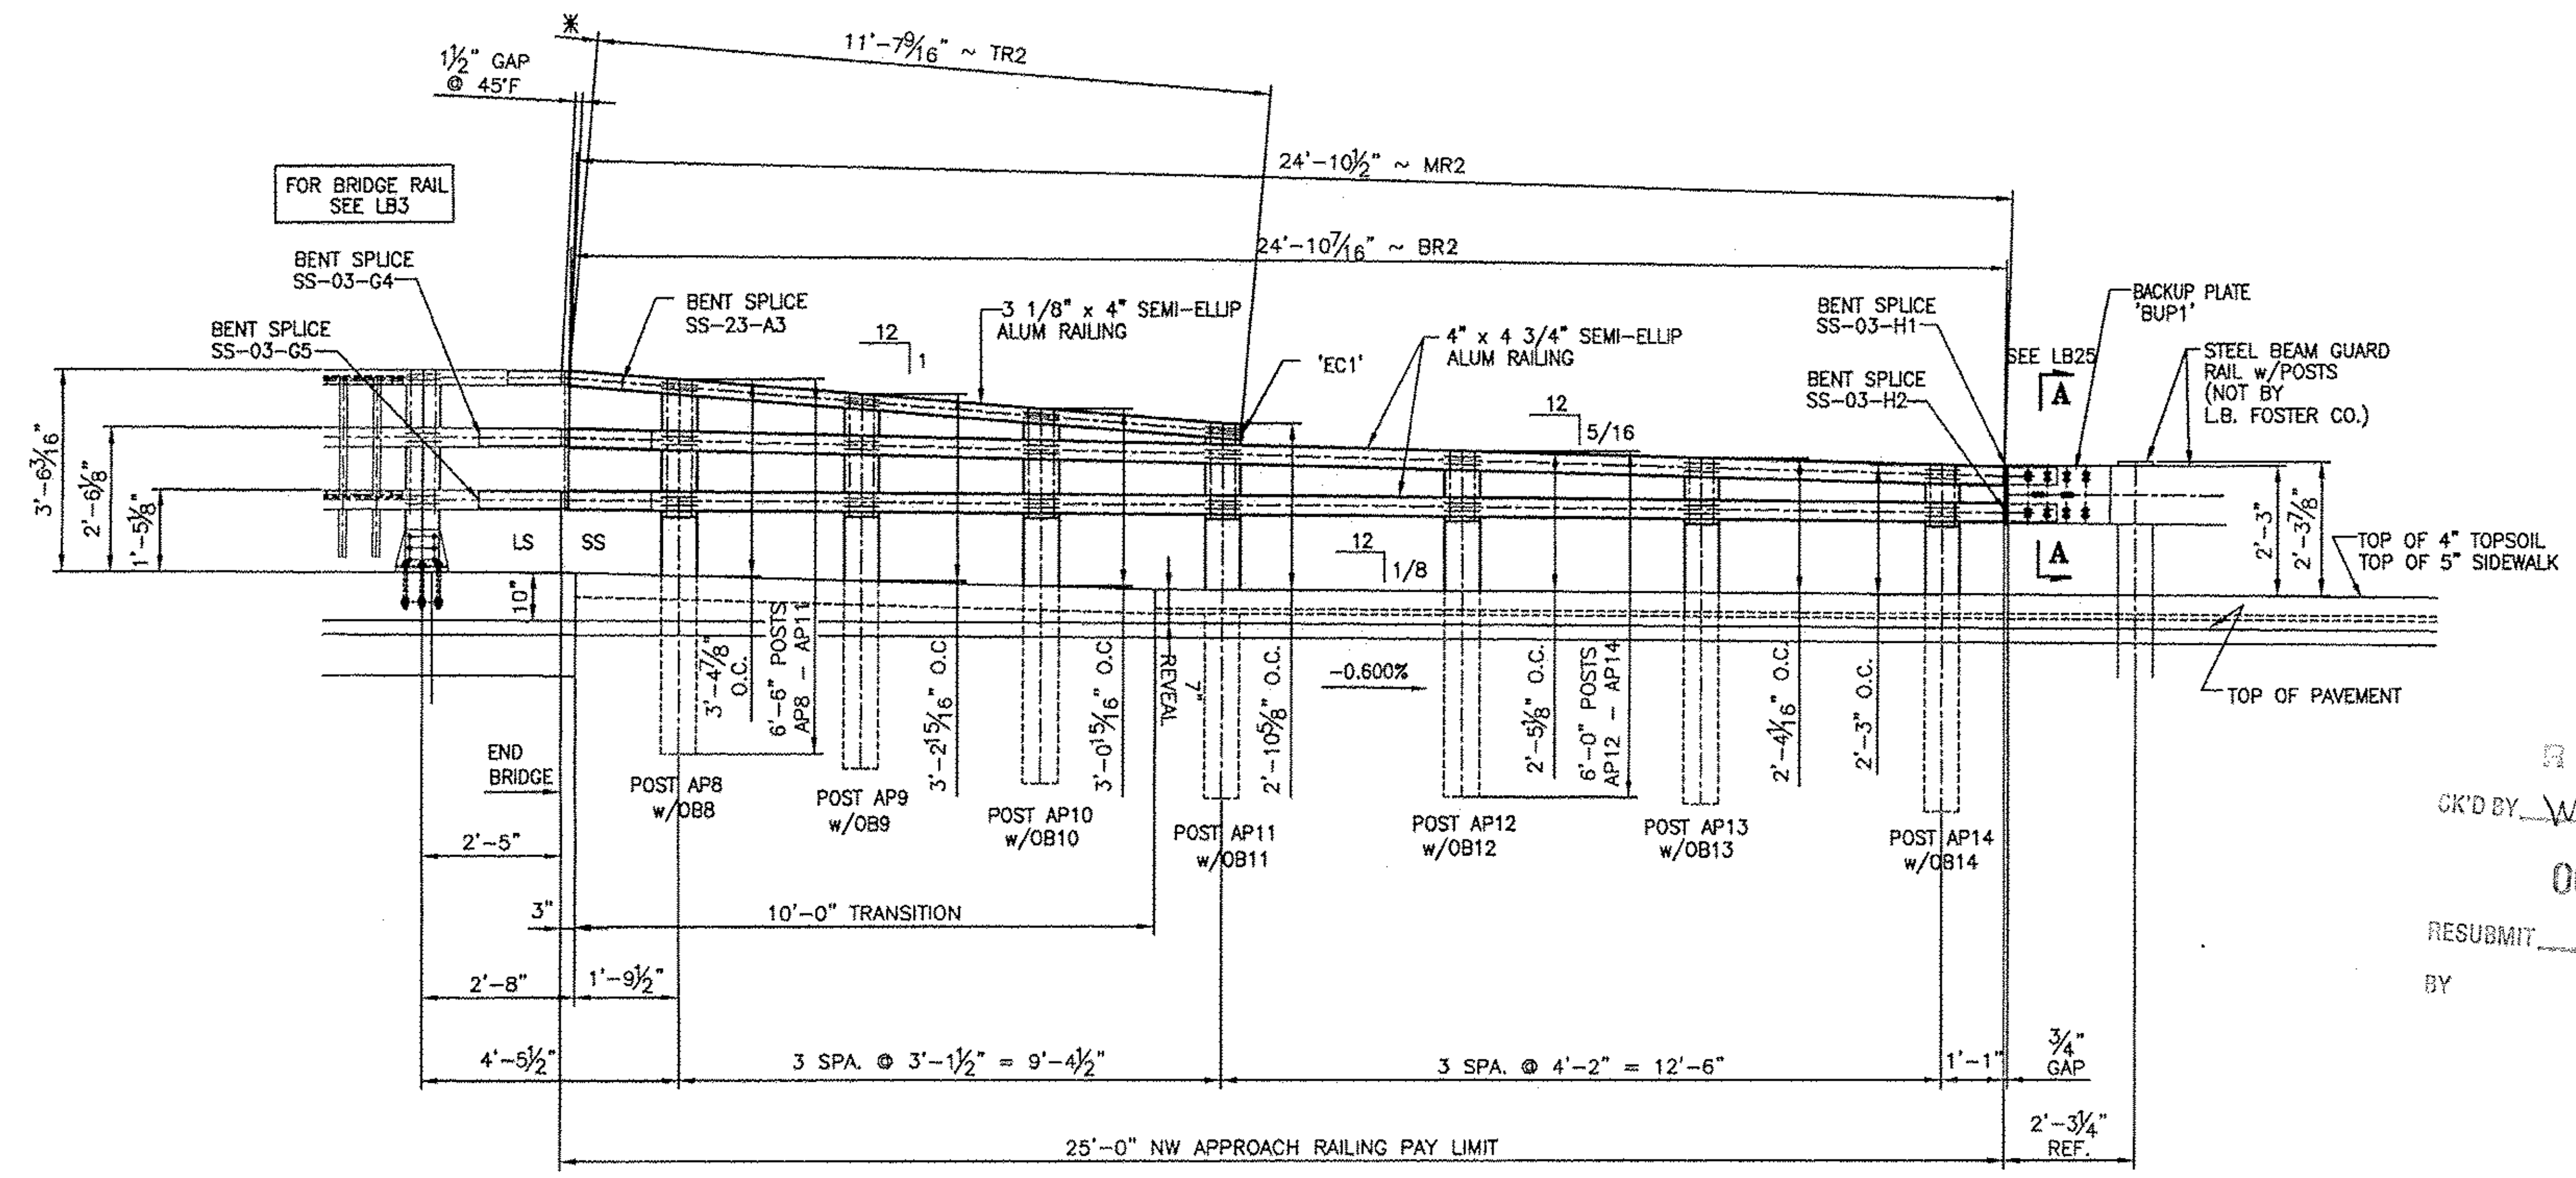

INSIDE ELEVATION ~ NW APPROACH ~ SIDEWALK SIDE

RECEIVED
 CK'D BY WLP OK'D BY SSS
 OCT 24 2011
 RESUBMIT _____ APPROVED
 BY _____ DATE 11/1/2011

- NOTE:
- THIS CONTRACT IS BASED UPON THE CONTRACTOR SETTING AND SPACING THE ANCHOR BOLTS TO THE MEASUREMENTS SHOWN ON THE APPROVED SHOP DRAWINGS. THE L.B. FOSTER CO. WILL NOT BE RESPONSIBLE FOR WORK NECESSITATED BY ANY OTHER SETTING AND SPACING.
 - THIS DRAWING IS NOT TO SCALE.
 - LENGTH OF APPROACH RAILING ON THIS SHEET IS 25 LF PAY LENGTH.
 - POST SPACING IS MEASURED ALONG FF OF RAILING.
 - SPLICE GAP AT SLEEVE = 1 1/2" TYP.
 - RAIL LENGTHS DO NOT INCLUDE GAPS.
 - COMPENSATION FOR VERTICAL CURVE IS INCLUDED IN RAIL LGTHS.

BRIDGE No. 15
 PROJECT No. BRF 022-1 (14)
 ITEM No: 621.74

LB Foster L.B. FOSTER COMPANY
 1016 GREENTREE RD.
 PITTSBURGH, PA 15220

Fabricated Bridge Products

FOR: F. R. LAFAYETTE, INC.
 VERMONT AGENCY OF TRANSPORTATION
 TOWN OF BETHEL, WINDSOR COUNTY, VT
 3-LINE ALUMINUM APPROACH RAIL FOR VT ROUTE 7
 (MINOR ARTERIAL) - SIDEWALK SIDE ELEVATION

MADE	CMS	DATE	09/19/11	JOB NO.	AR0700
CHECK	Dd	DATE	10/13/11	DRAWING	LB14
REV.	DESCRIPTION	BY	DATE	REV. NO.	