


SS = SHORT SLOTTED SIDE  
 LS = LONG SLOTTED SIDE

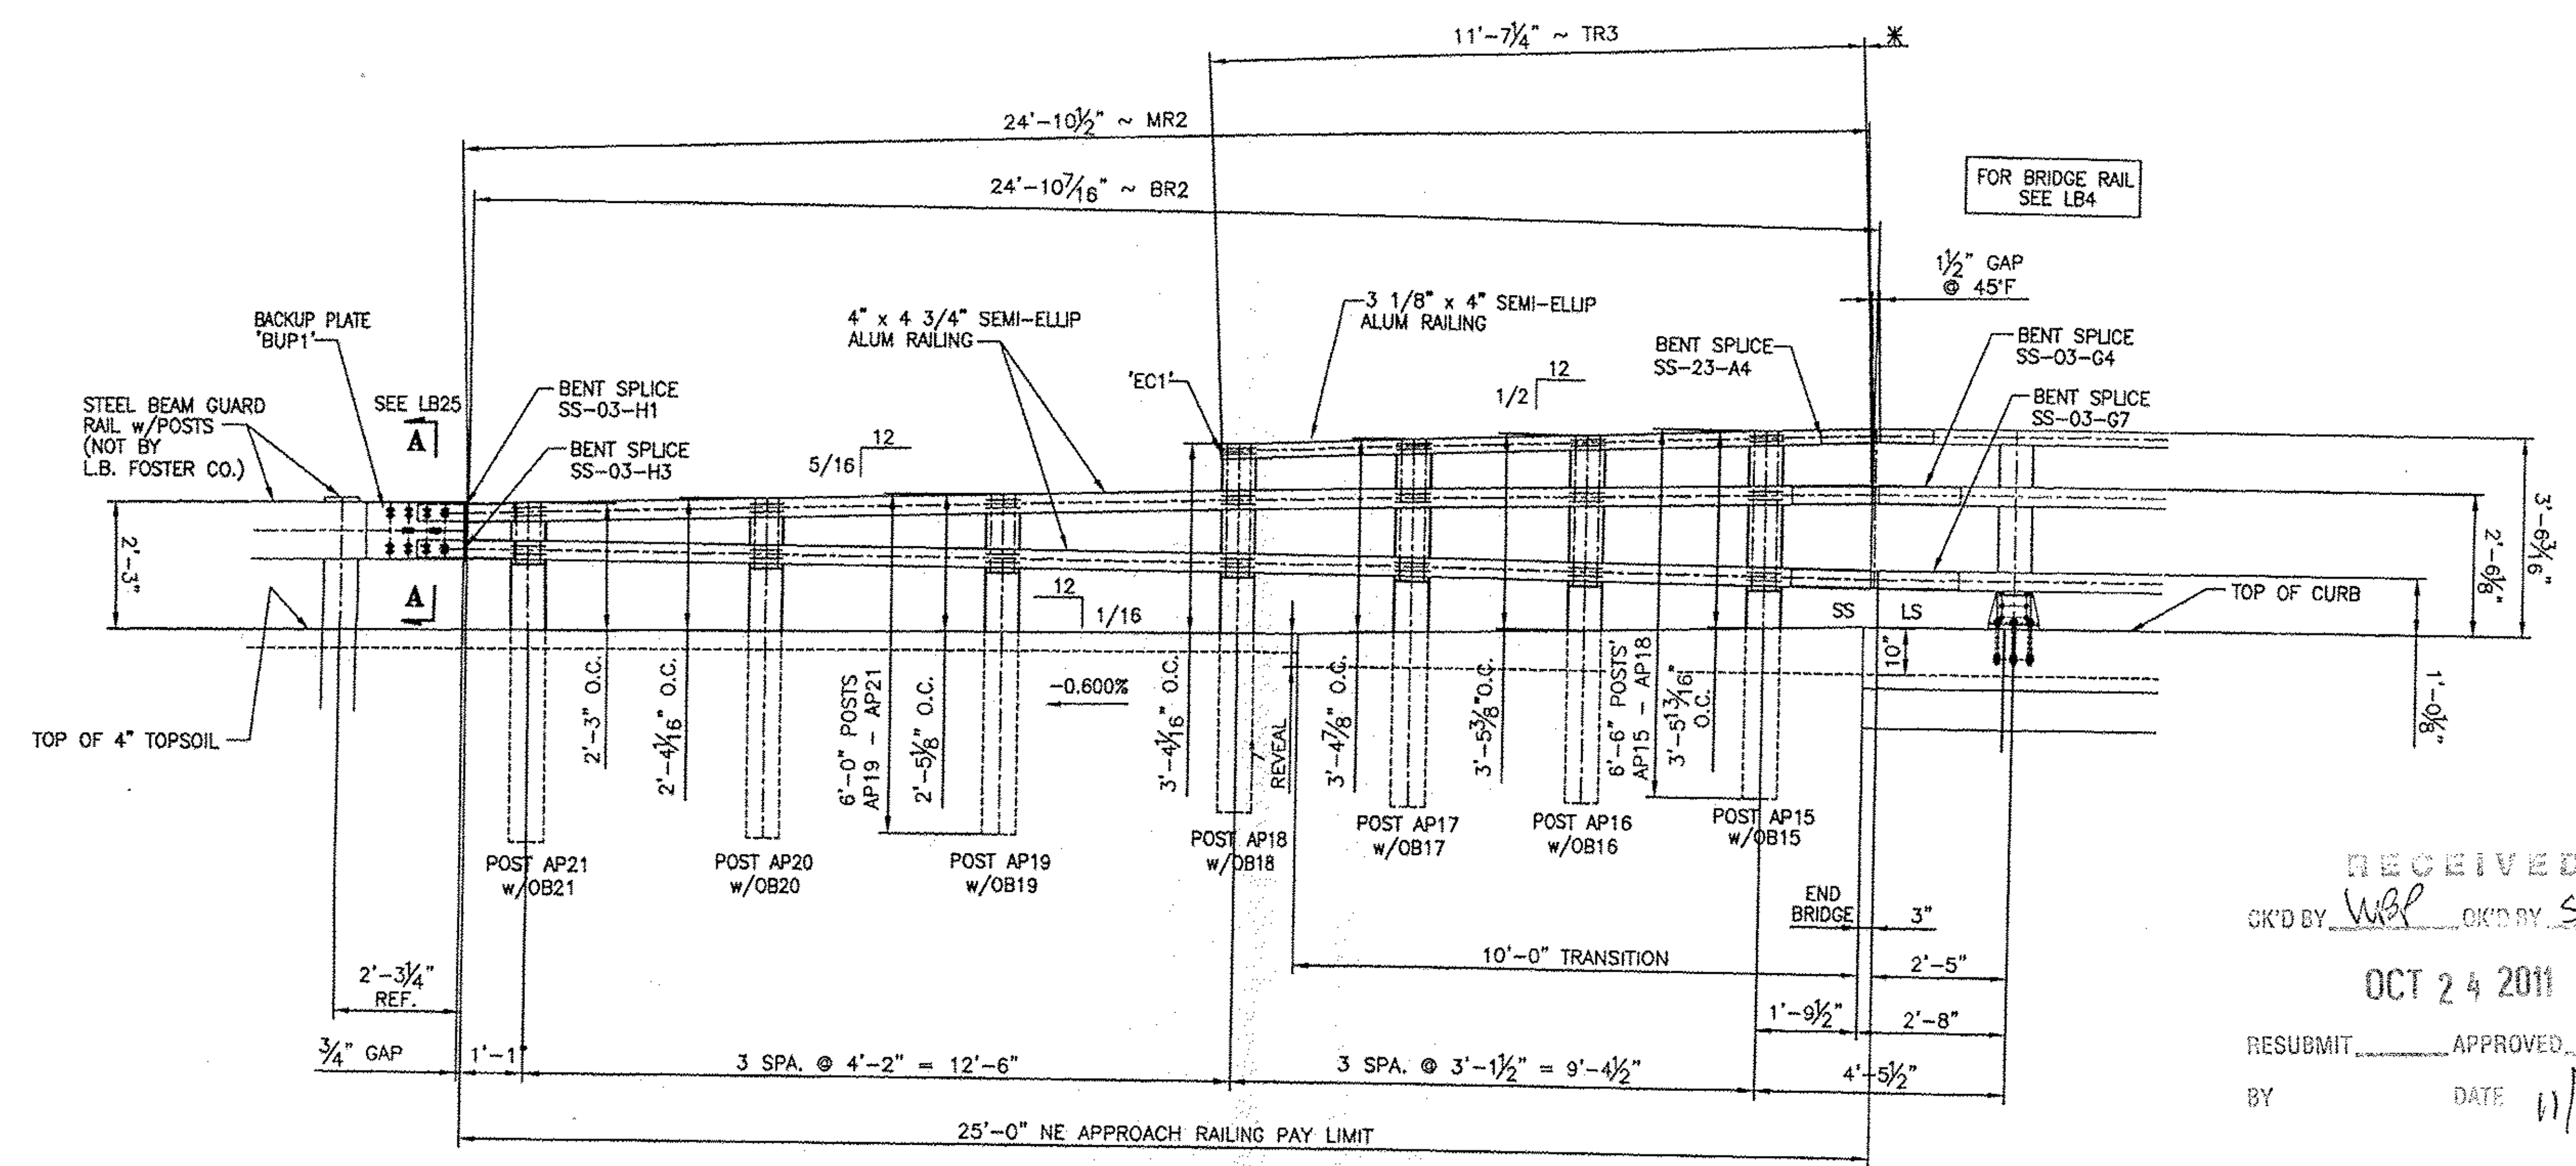

RECEIVED  
 CK'D BY *WBP* CK'D BY *SSS*  
 OCT 24 2011  
 RESUBMIT \_\_\_\_\_ APPROVED   
 BY \_\_\_\_\_ DATE 11/1/2011

INSIDE ELEVATION ~ NE APPROACH ~ CURBSIDE

- NOTE:
- THIS DRAWING IS NOT TO SCALE.
  - LENGTH OF APPROACH RAILING ON THIS SHEET IS 25 LF PAY LENGTH.
  - POST SPACING IS MEASURED ALONG FF OF RAILING.
  - SPLICE GAP AT SLEEVE = 1 1/2" TYP.
  - \* RAIL LENGTHS DO NOT INCLUDE GAPS.
  - COMPENSATION FOR VERTICAL CURVE IS INCLUDED IN RAIL LGTHS.

BRIDGE No. 15  
 PROJECT No. BRF 022-1 (14)  
 ITEM No: 621.74

**LB Foster** L.B. FOSTER COMPANY  
 Fabricated Bridge Products 1016 GREENTREE RD.  
 PITTSBURGH, PA 15220

FOR: F. R. LAFAYETTE, INC.  
 VERMONT AGENCY OF TRANSPORTATION  
 TOWN OF BETHEL, WINDSOR COUNTY, VT  
 3-LINE ALUMINUM APPROACH RAIL FOR VT ROUTE 7  
 (MINOR ARTERIAL) - CURB SIDE ELEVATION

MADE CMS DATE 09/19/11 JOB NO. AR0700  
 CHECK Dd DATE 10/14/11 DRAWING LB15  
 REV. NO.

REV.	DESCRIPTION	BY	DATE