



SS = SHORT SLOTTED SIDE
 LS = LONG SLOTTED SIDE

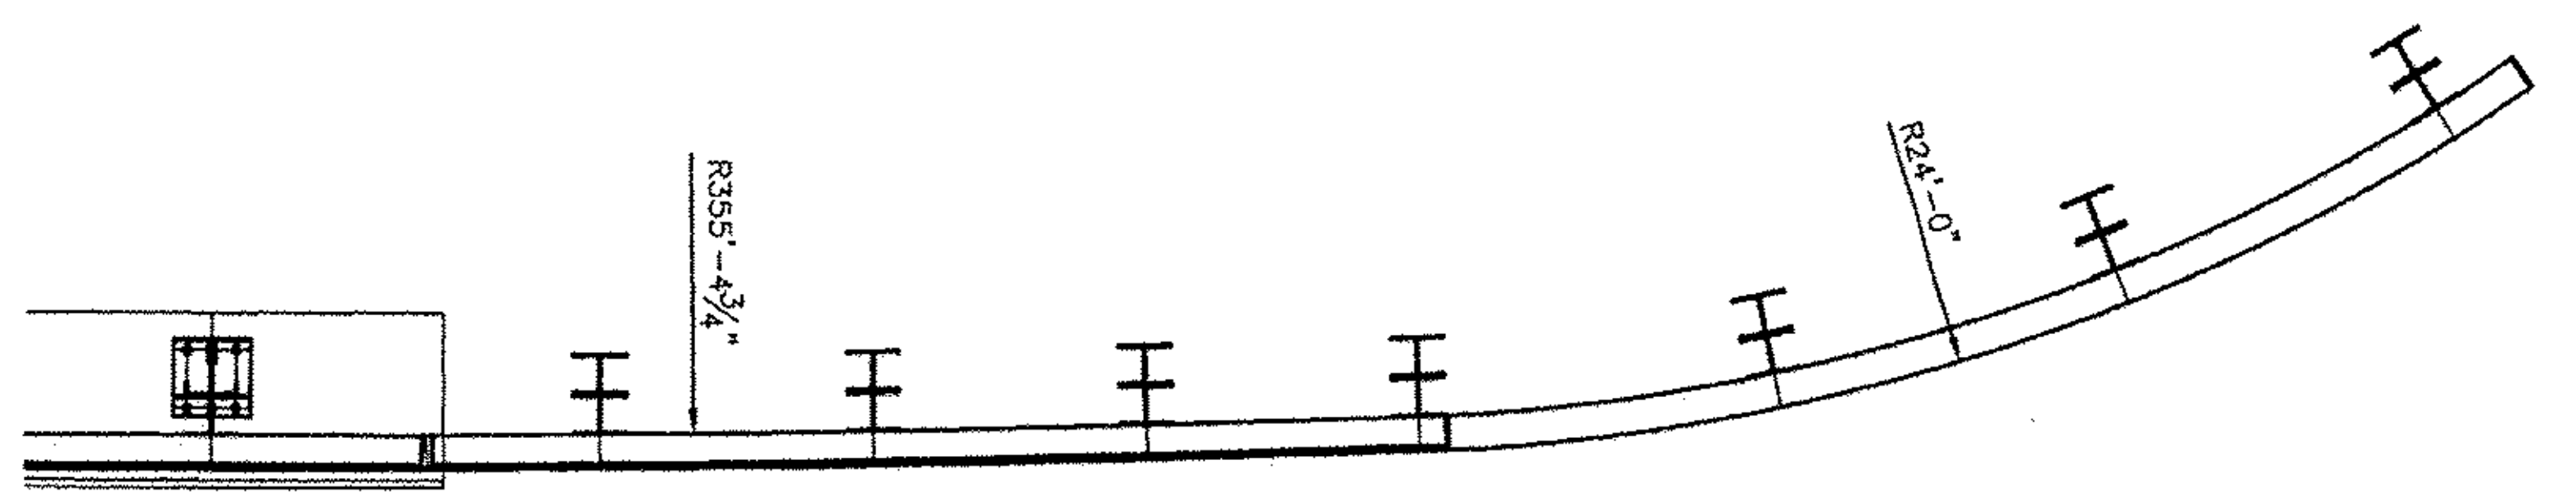

PLAN VIEW

- NOTE:
- THIS DRAWING IS NOT TO SCALE.
 - LENGTH OF APPROACH RAILING ON THIS SHEET IS 25 LF PAY LENGTH.
 - POST SPACING IS MEASURED ALONG FF OF RAILING.
 - SPLICE GAP AT SLEEVE = 1 1/2" TYP.
 - * RAIL LENGTHS DO NOT INCLUDE GAPS.
 - COMPENSATION FOR VERTICAL CURVE IS INCLUDED IN RAIL LGTHS.

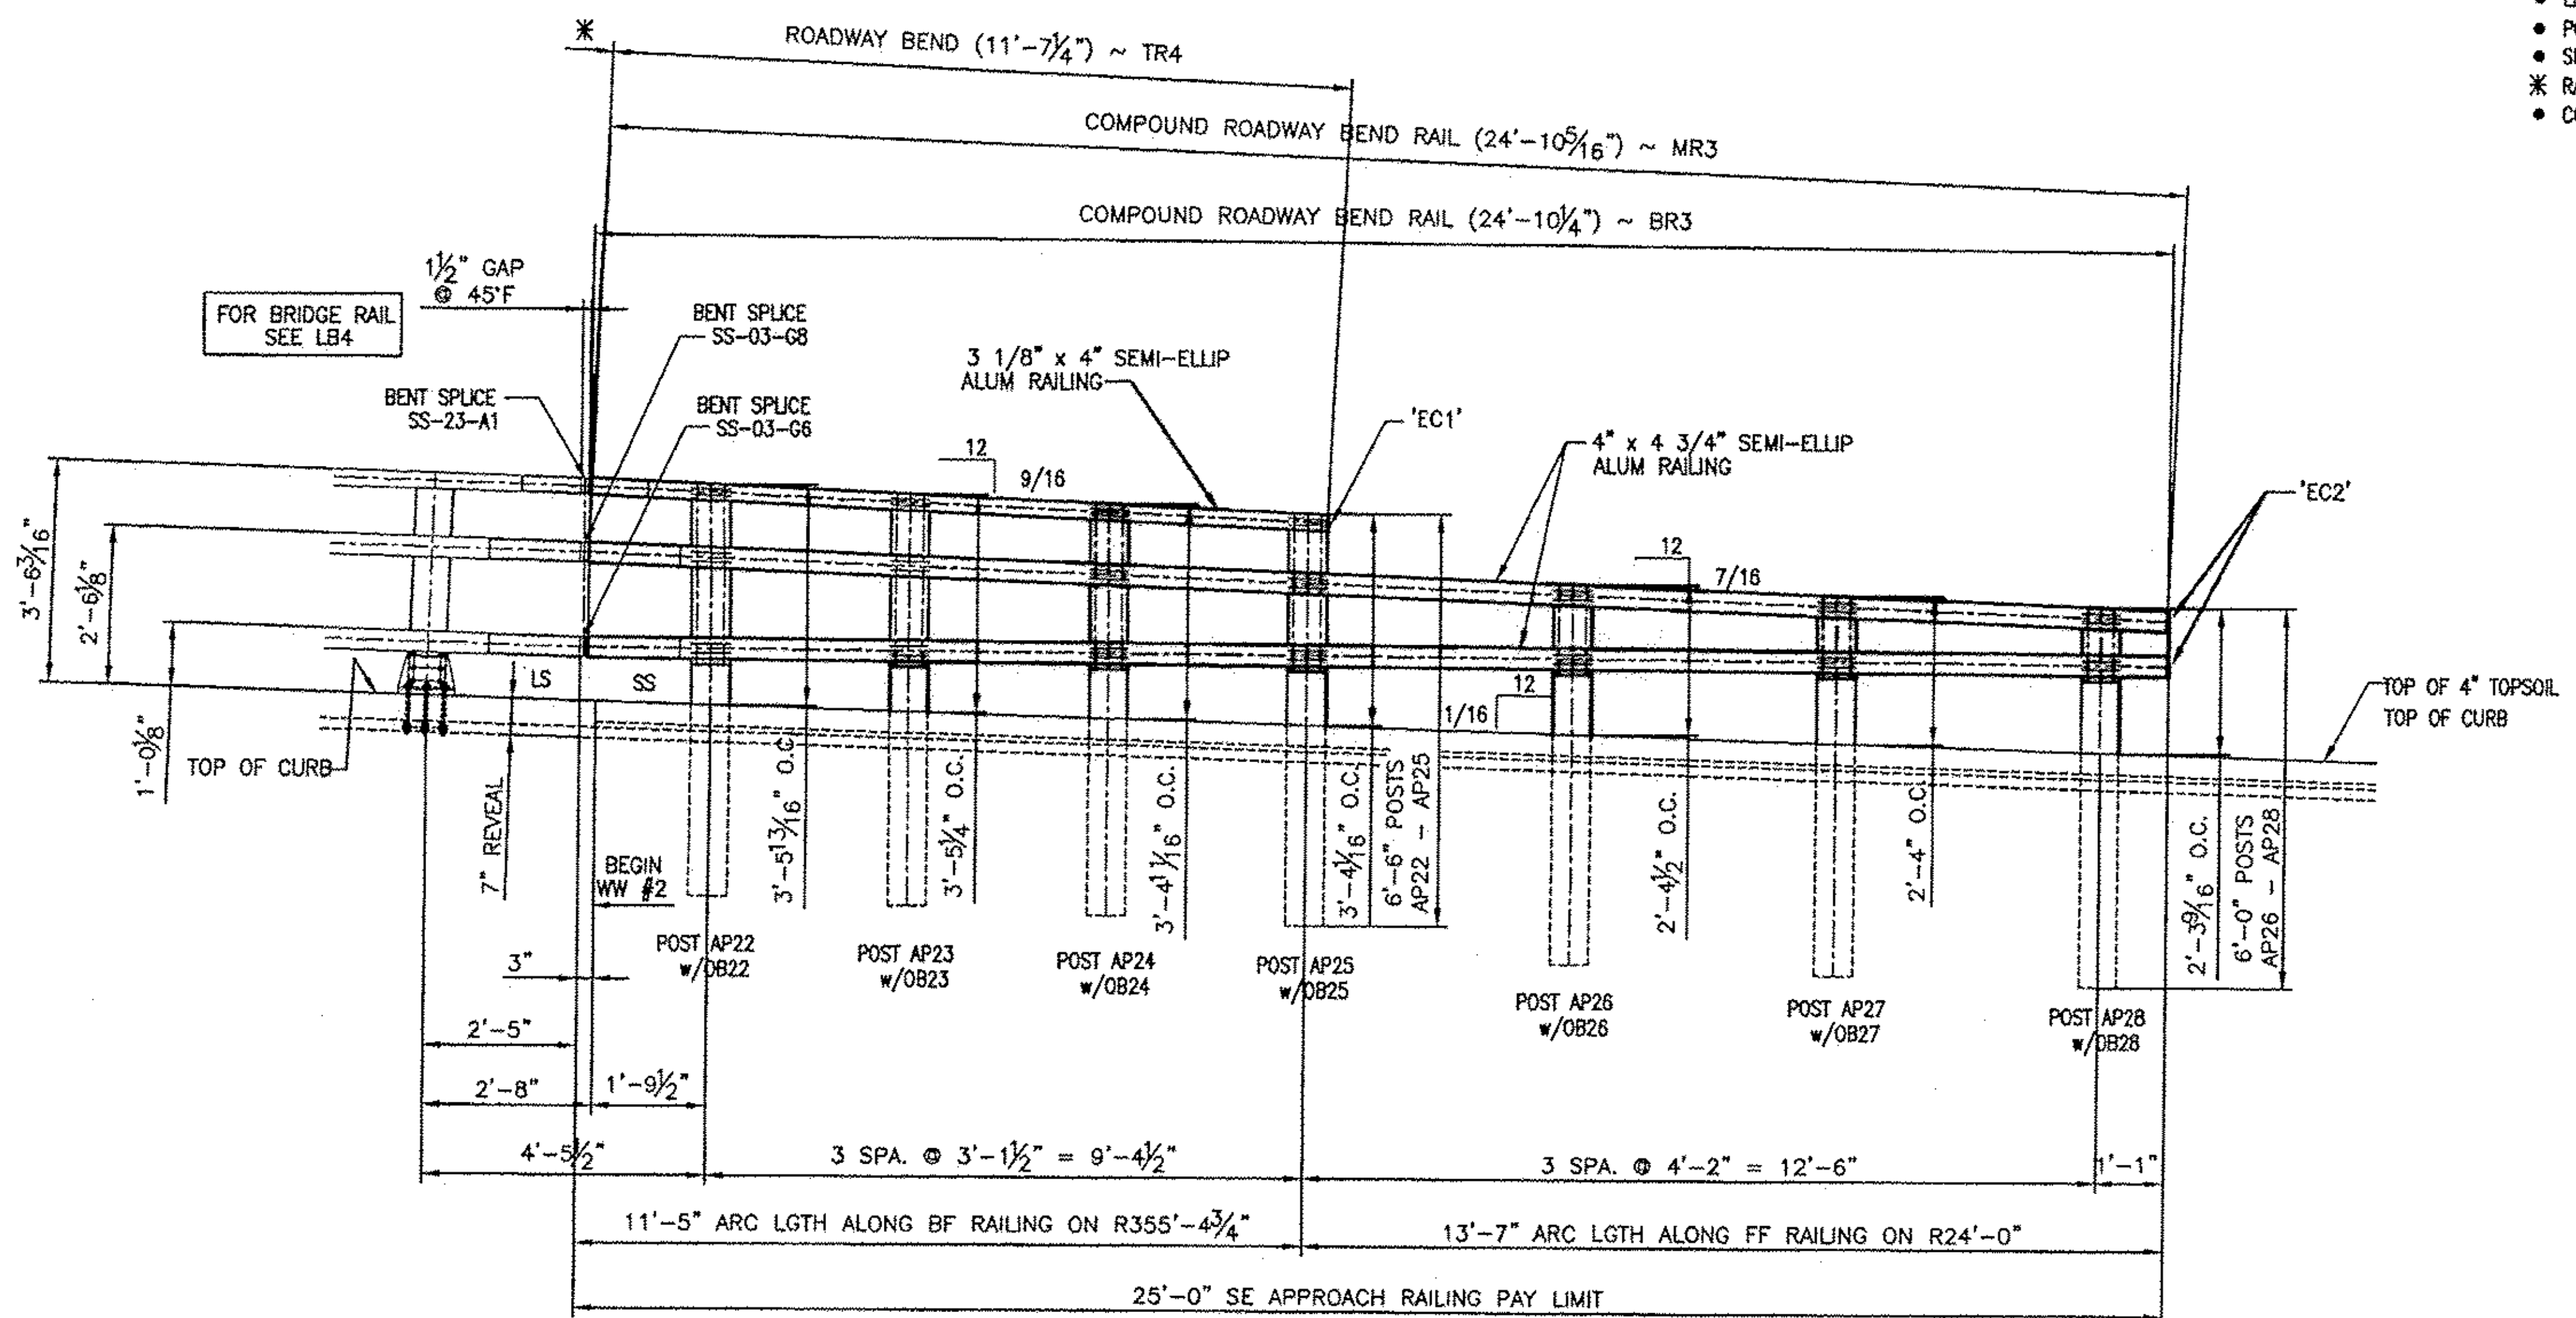

INSIDE ELEVATION ~ SE APPROACH ~ CURBSIDE

RECEIVED
 OK'D BY WBP OK'D BY SSS
 OCT 24 2011
 RESUBMIT _____ APPROVED
 BY _____ DATE 11/1/2011

BRIDGE No. 15
 PROJECT No. BRF 022-1 (14) ITEM No: 621.74

LB Foster L.B. FOSTER COMPANY
 Fabricated Bridge Products 1016 GREENTREE RD.
 PITTSBURGH, PA 15220

FOR: F. R. LAFAYETTE, INC.
 VERMONT AGENCY OF TRANSPORTATION
 TOWN OF BETHEL, WINDSOR COUNTY, VT
 3-LINE ALUMINUM APPROACH RAIL FOR VT ROUTE 7
 (MINOR ARTERIAL) - CURB SIDE ELEVATION

REV.	DESCRIPTION	BY	DATE	CHECK	DATE	DRAWING	REV. NO.

MADE CMS DATE 09/19/11 JOB NO. AR0700

CHECK Dd DATE 10/14/11 DRAWING LB16