



PLAN VIEW

ONE REQ'D. ~ COMPOUND BENT RAIL 'MR3'

(FINISHED LGTH ALONG FF RAIL = 24'-10 5/16" - LONGEST FACE + 4'-0" FOR SHOP BENDING = 28'-10 5/16")

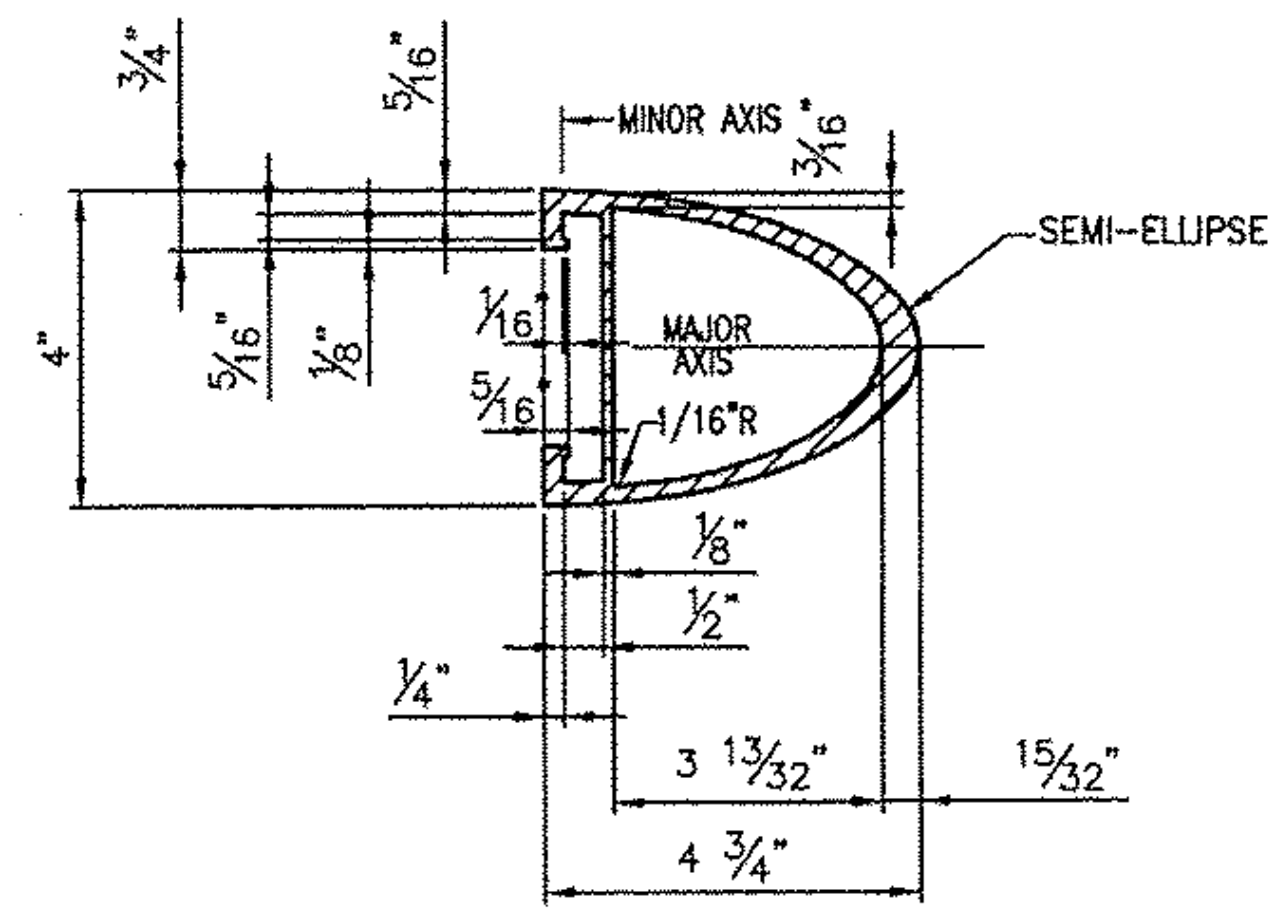

TYPICAL SECTION
(BARRIER RAIL)

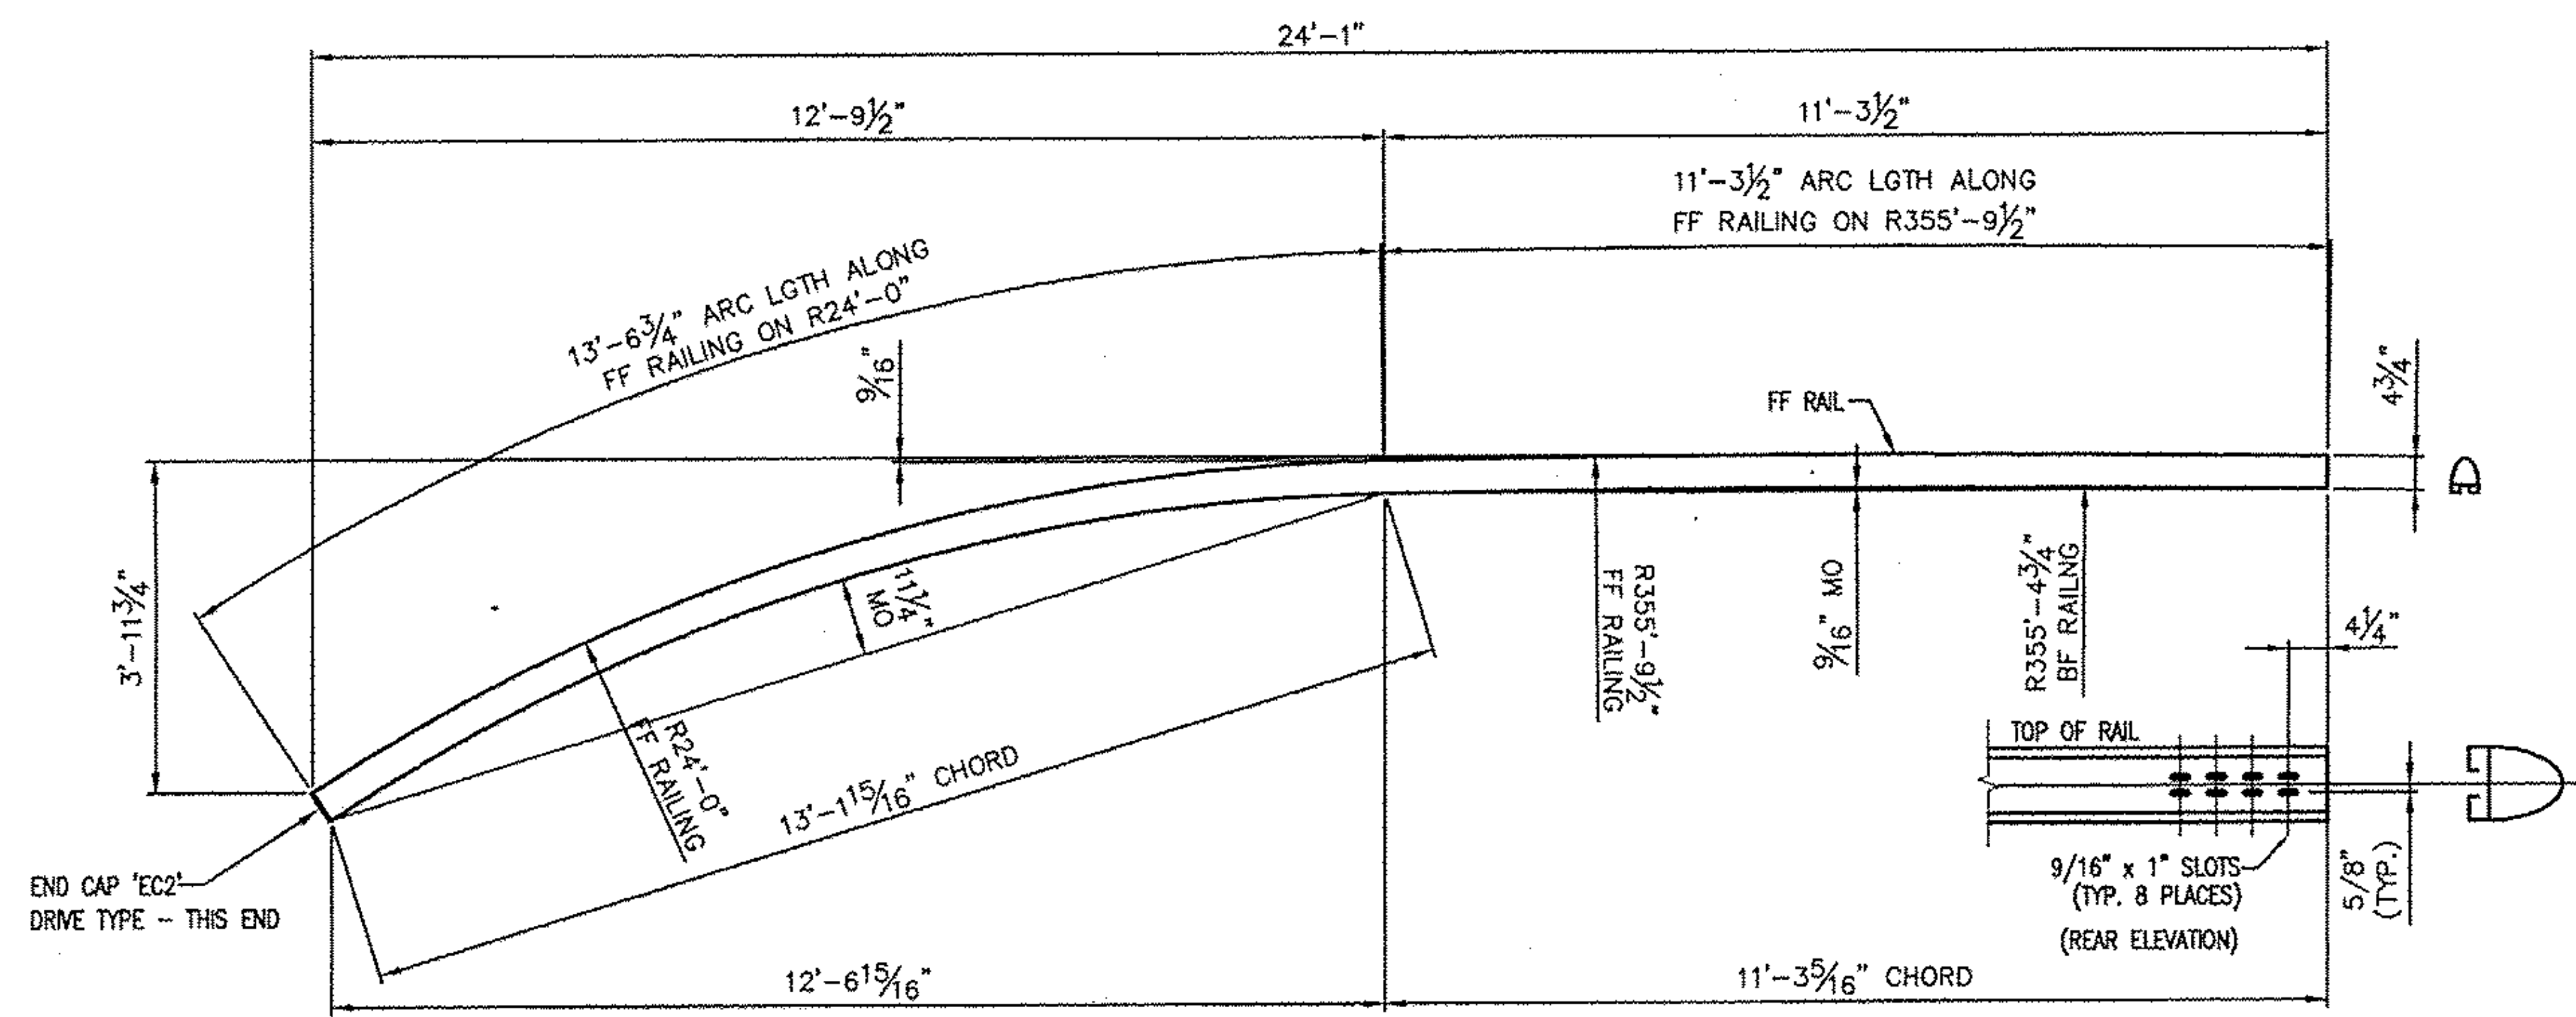

PLAN VIEW

ONE REQ'D. ~ COMPOUND BENT RAIL 'BR3'

(FINISHED LGTH ALONG FF RAIL = 24'-10 1/4" - LONGEST FACE + 4'-0" FOR SHOP BENDING = 28'-10 1/4")

RECEIVED
 CK'D BY WBP CK'D BY SSS
 OCT 24 2011
 RESUBMIT _____ APPROVED
 BY _____ DATE 11/1/2011

BRIDGE No. 15
 PROJECT No. BRF 022-1 (14) ITEM No: 621.74
LB Foster L.B. FOSTER COMPANY
 Fabricated Bridge Products 1016 GREENTREE RD.
 PITTSBURGH, PA 15220

FOR: F. R. LAFAYETTE, INC.
 VERMONT AGENCY OF TRANSPORTATION
 TOWN OF BETHEL, WINDSOR COUNTY, VT
 3-LINE ALUMINUM APPROACH RAIL FOR VT ROUTE 7
 (MINOR ARTERIAL) -- SE APPROACH RAIL DETAILS

MADE CMS DATE 09/22/11 JOB NO. ARO700
 CHECK Dd DATE 10/14/11 DRAWING LB23

REV.	DESCRIPTION	BY	DATE	REV. NO.