




SECTION - A
(@ U2 & U8)

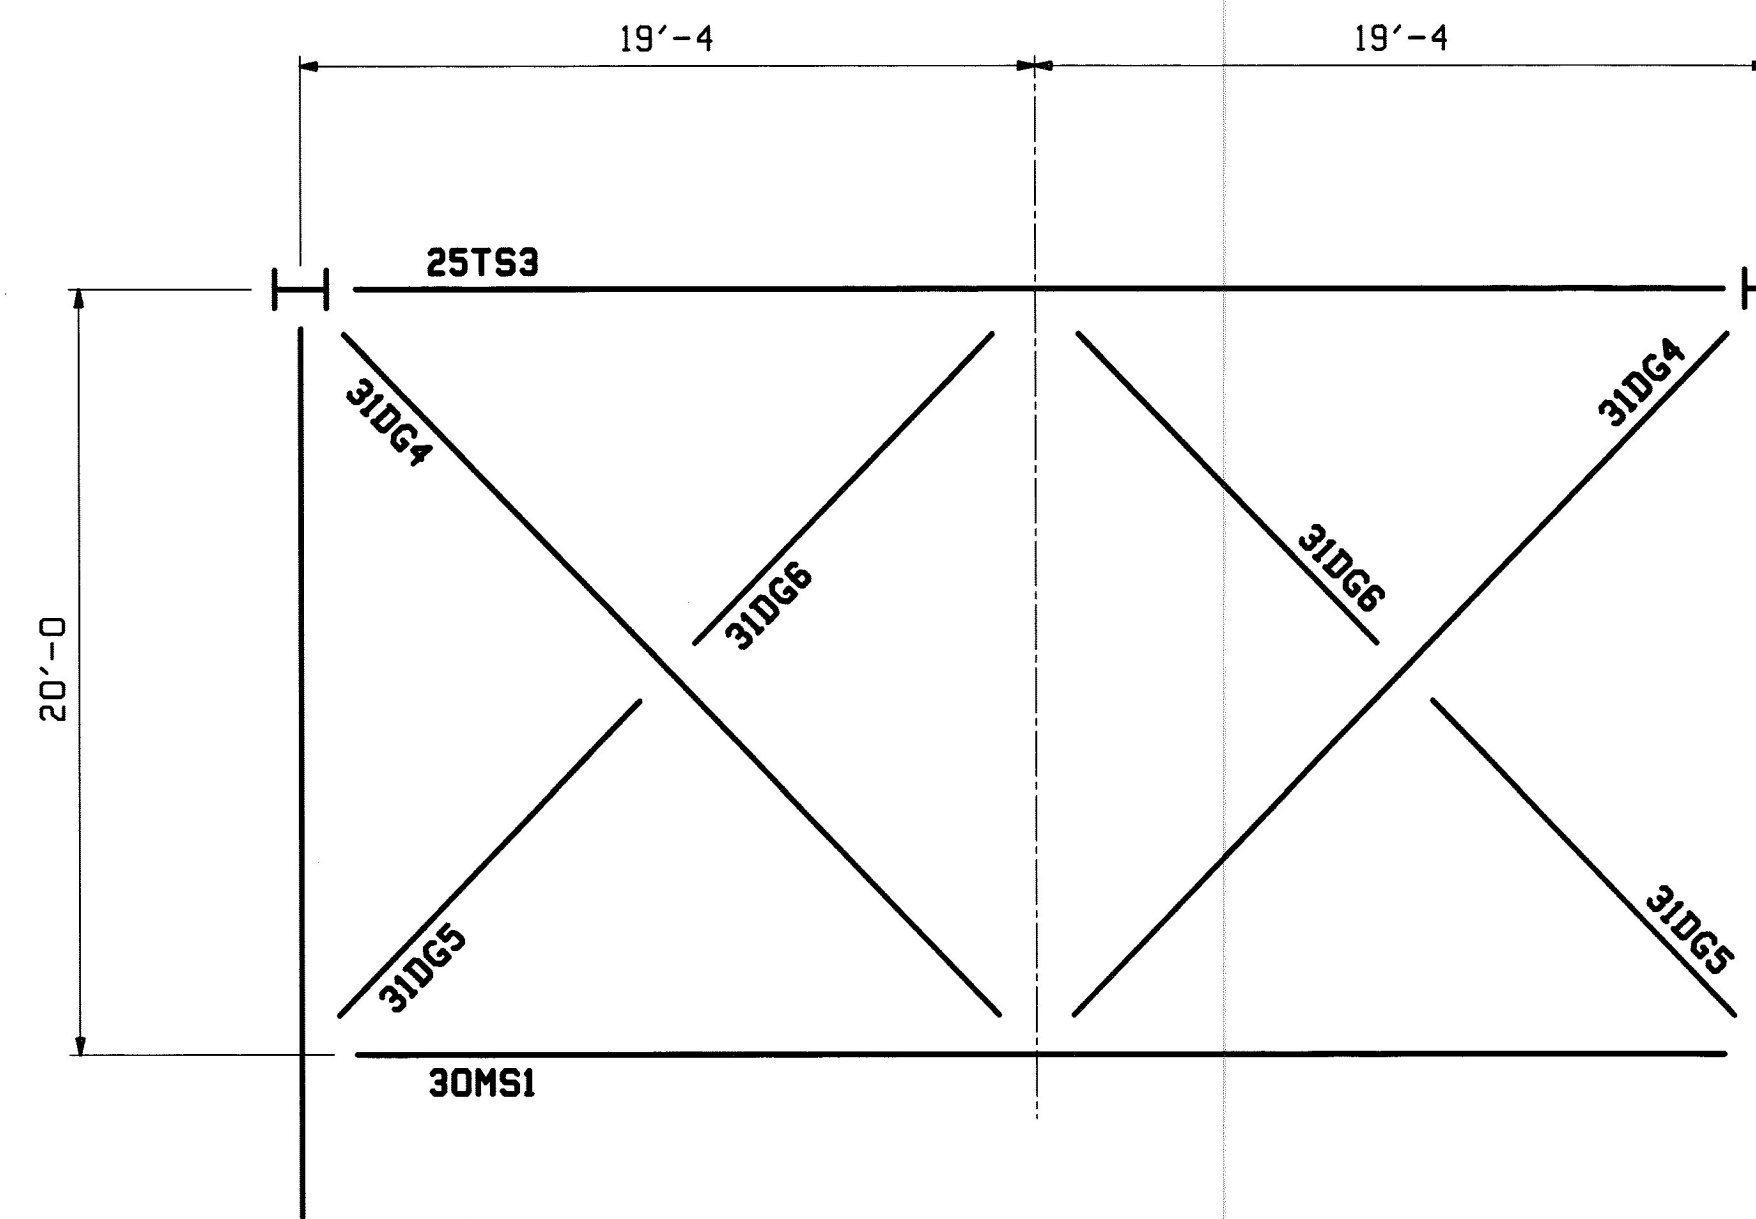

SECTION - B
(@ U3 & U7)

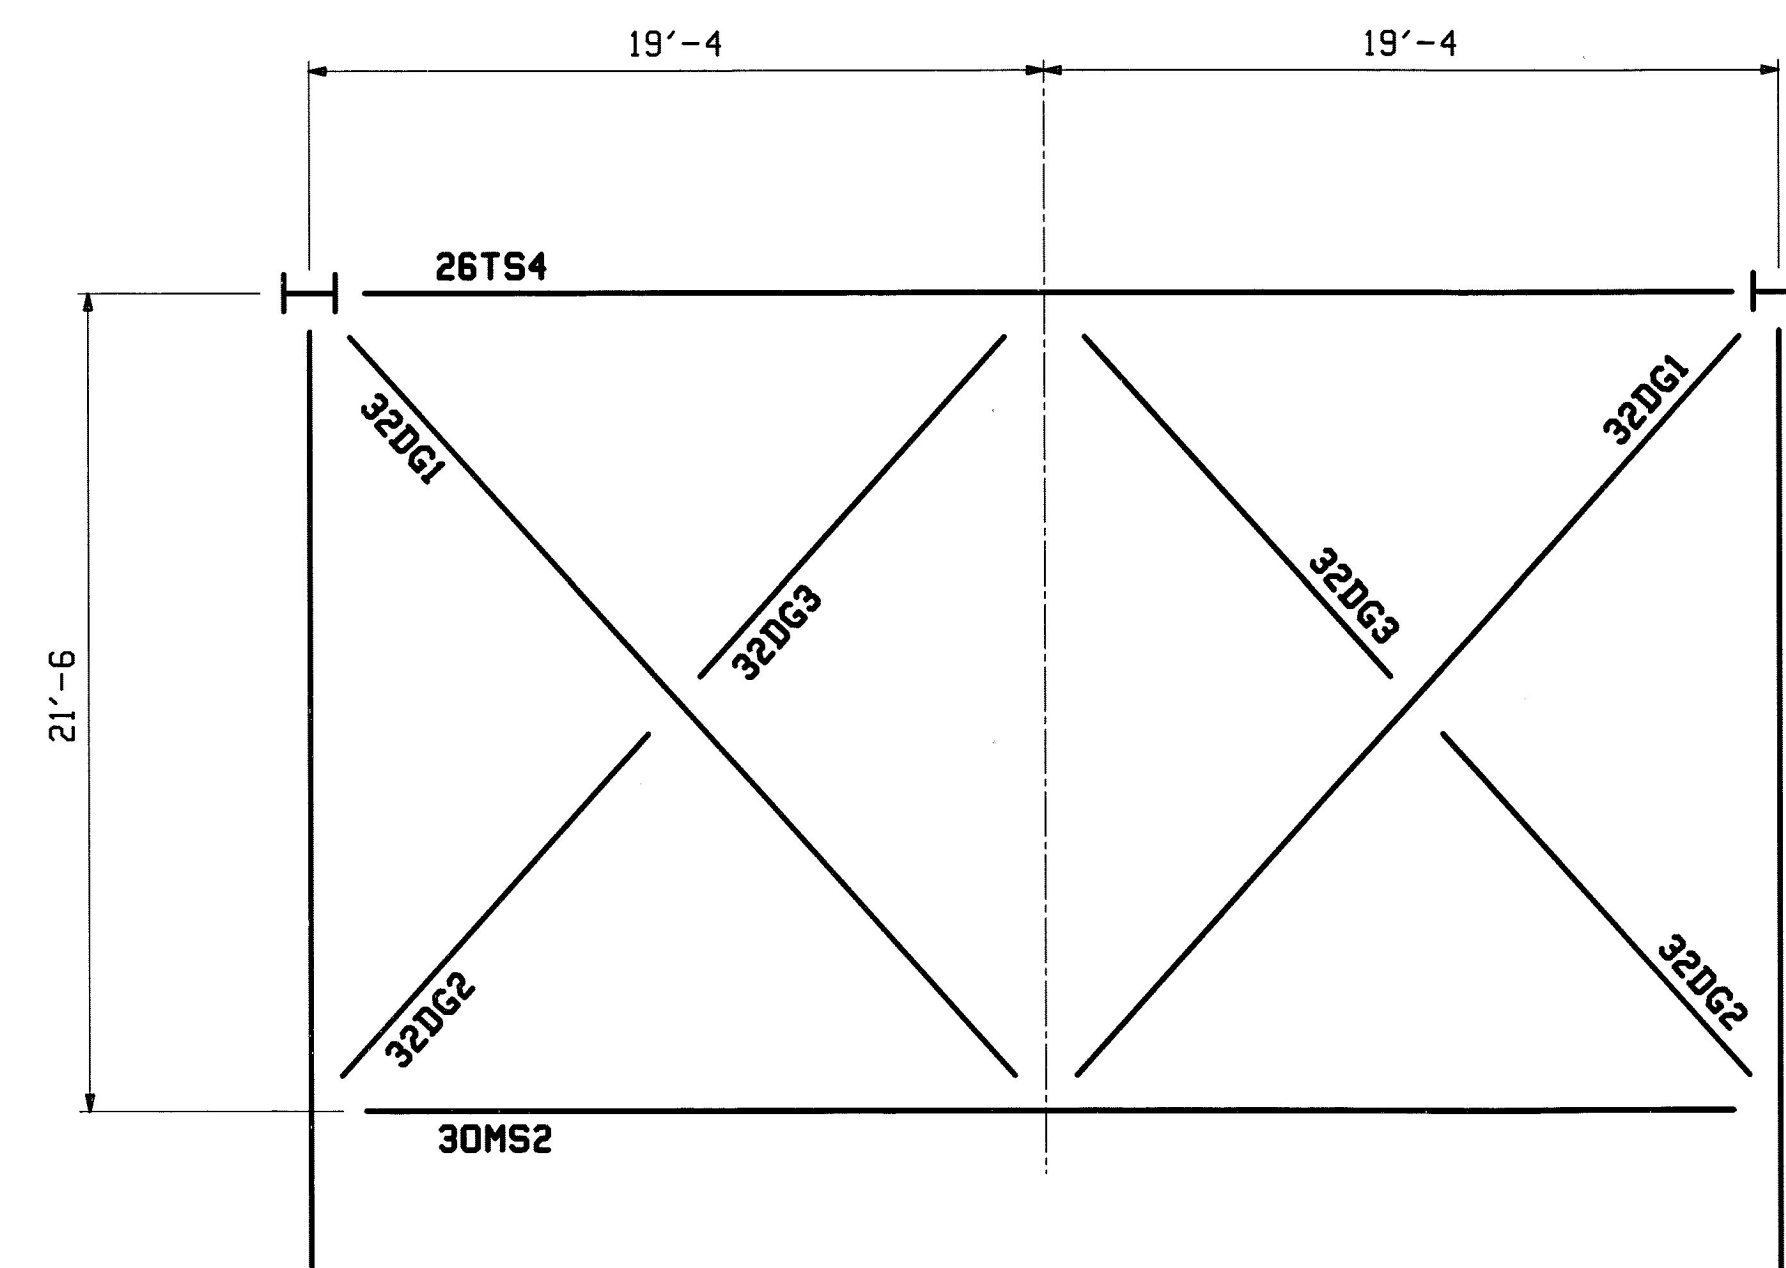

SECTION - C
(@ U4 & U6)

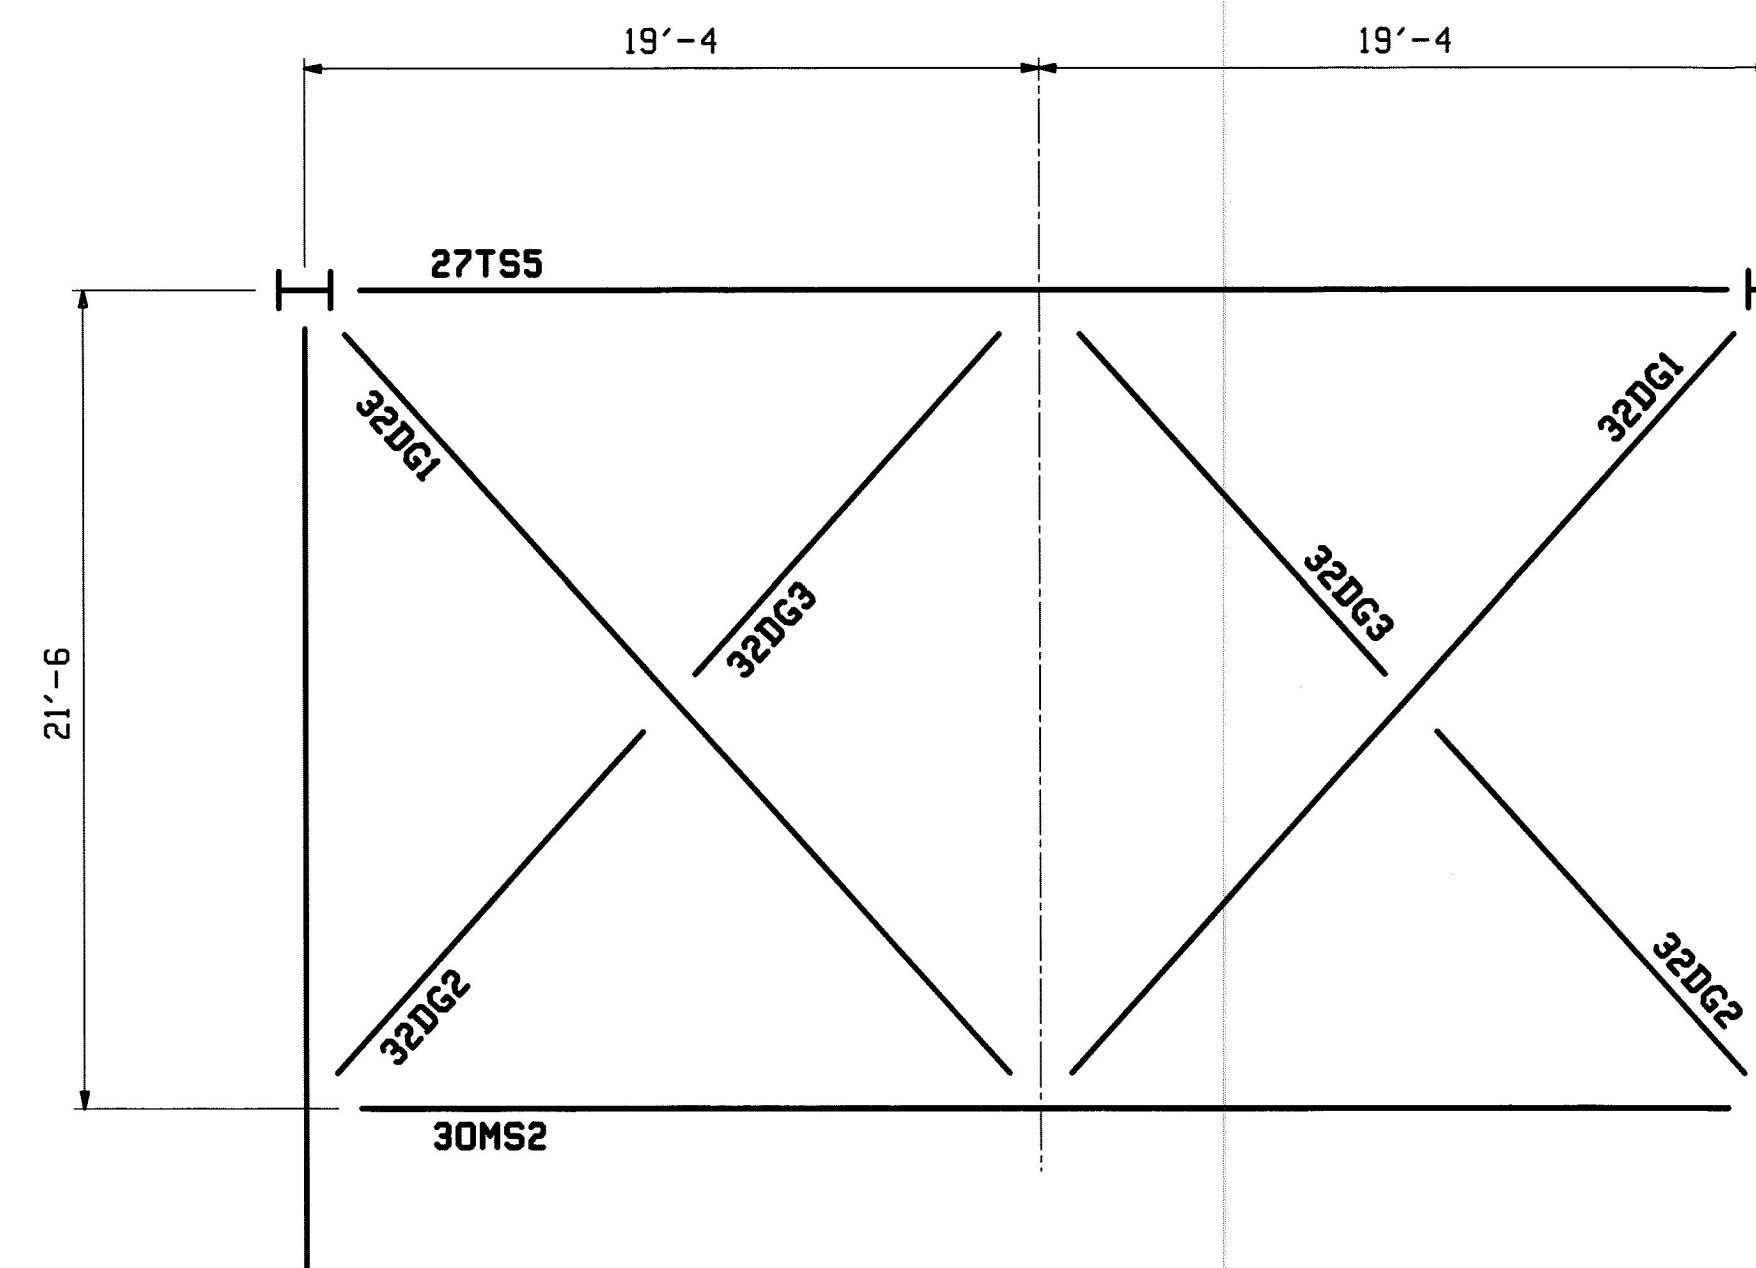

SECTION - D
(@ U5)

Vermont Agency of Transportation
RECEIVED
 CK'D BY M.C.L. OK'D BY S.S.S.
 January 10 2012
 RESUBMIT APPROVED ✓
 BY J. LACROIX DATE 01-12-2012

- NOTES:
 1. REFER TO SHEET GNI FOR GENERAL NOTES.
 2. WORK THIS SHEET WITH SHEETS E1, E2 & E3.

REV.	DATE	REMARKS	DWN	CHK	APVL	SHOP
0						
MATERIAL:		SURFACE PREP. & PRINT:		HOLES:		SHOP BOLTS:
DESCRIPTION: SWAY FRAME FRAMING PLAN						
CASCO BAY STEEL STRUCTURES, INC. 1 WALLACE AVE. PHONE (207) 780-6722 SOUTH PORTLAND, ME 04106 FAX. (207) 780-6726						
STRUCTURE: VT RTE 107 OVER WHITE RIVER			DRAWN:	DATE:		
			EEO	11/02		
			CHKD:	DATE:		
			PCP	11/03		
LOCATION: BETHEL, VT.			JOB NO.	DWG NO.		
PROJ NO. BRF 022-1(14)			498	E4		
CUSTOMER: BECK & BELLUCCI				REV.	△	