



8 ~ GUSSET PLATE ~ X2L4A
 INTERIOR & EXTERIOR GUSSET @ L4 & L6
8 ~ FILL PLATE ~ X2L4B
8 ~ FILL PLATE ~ X2L4C

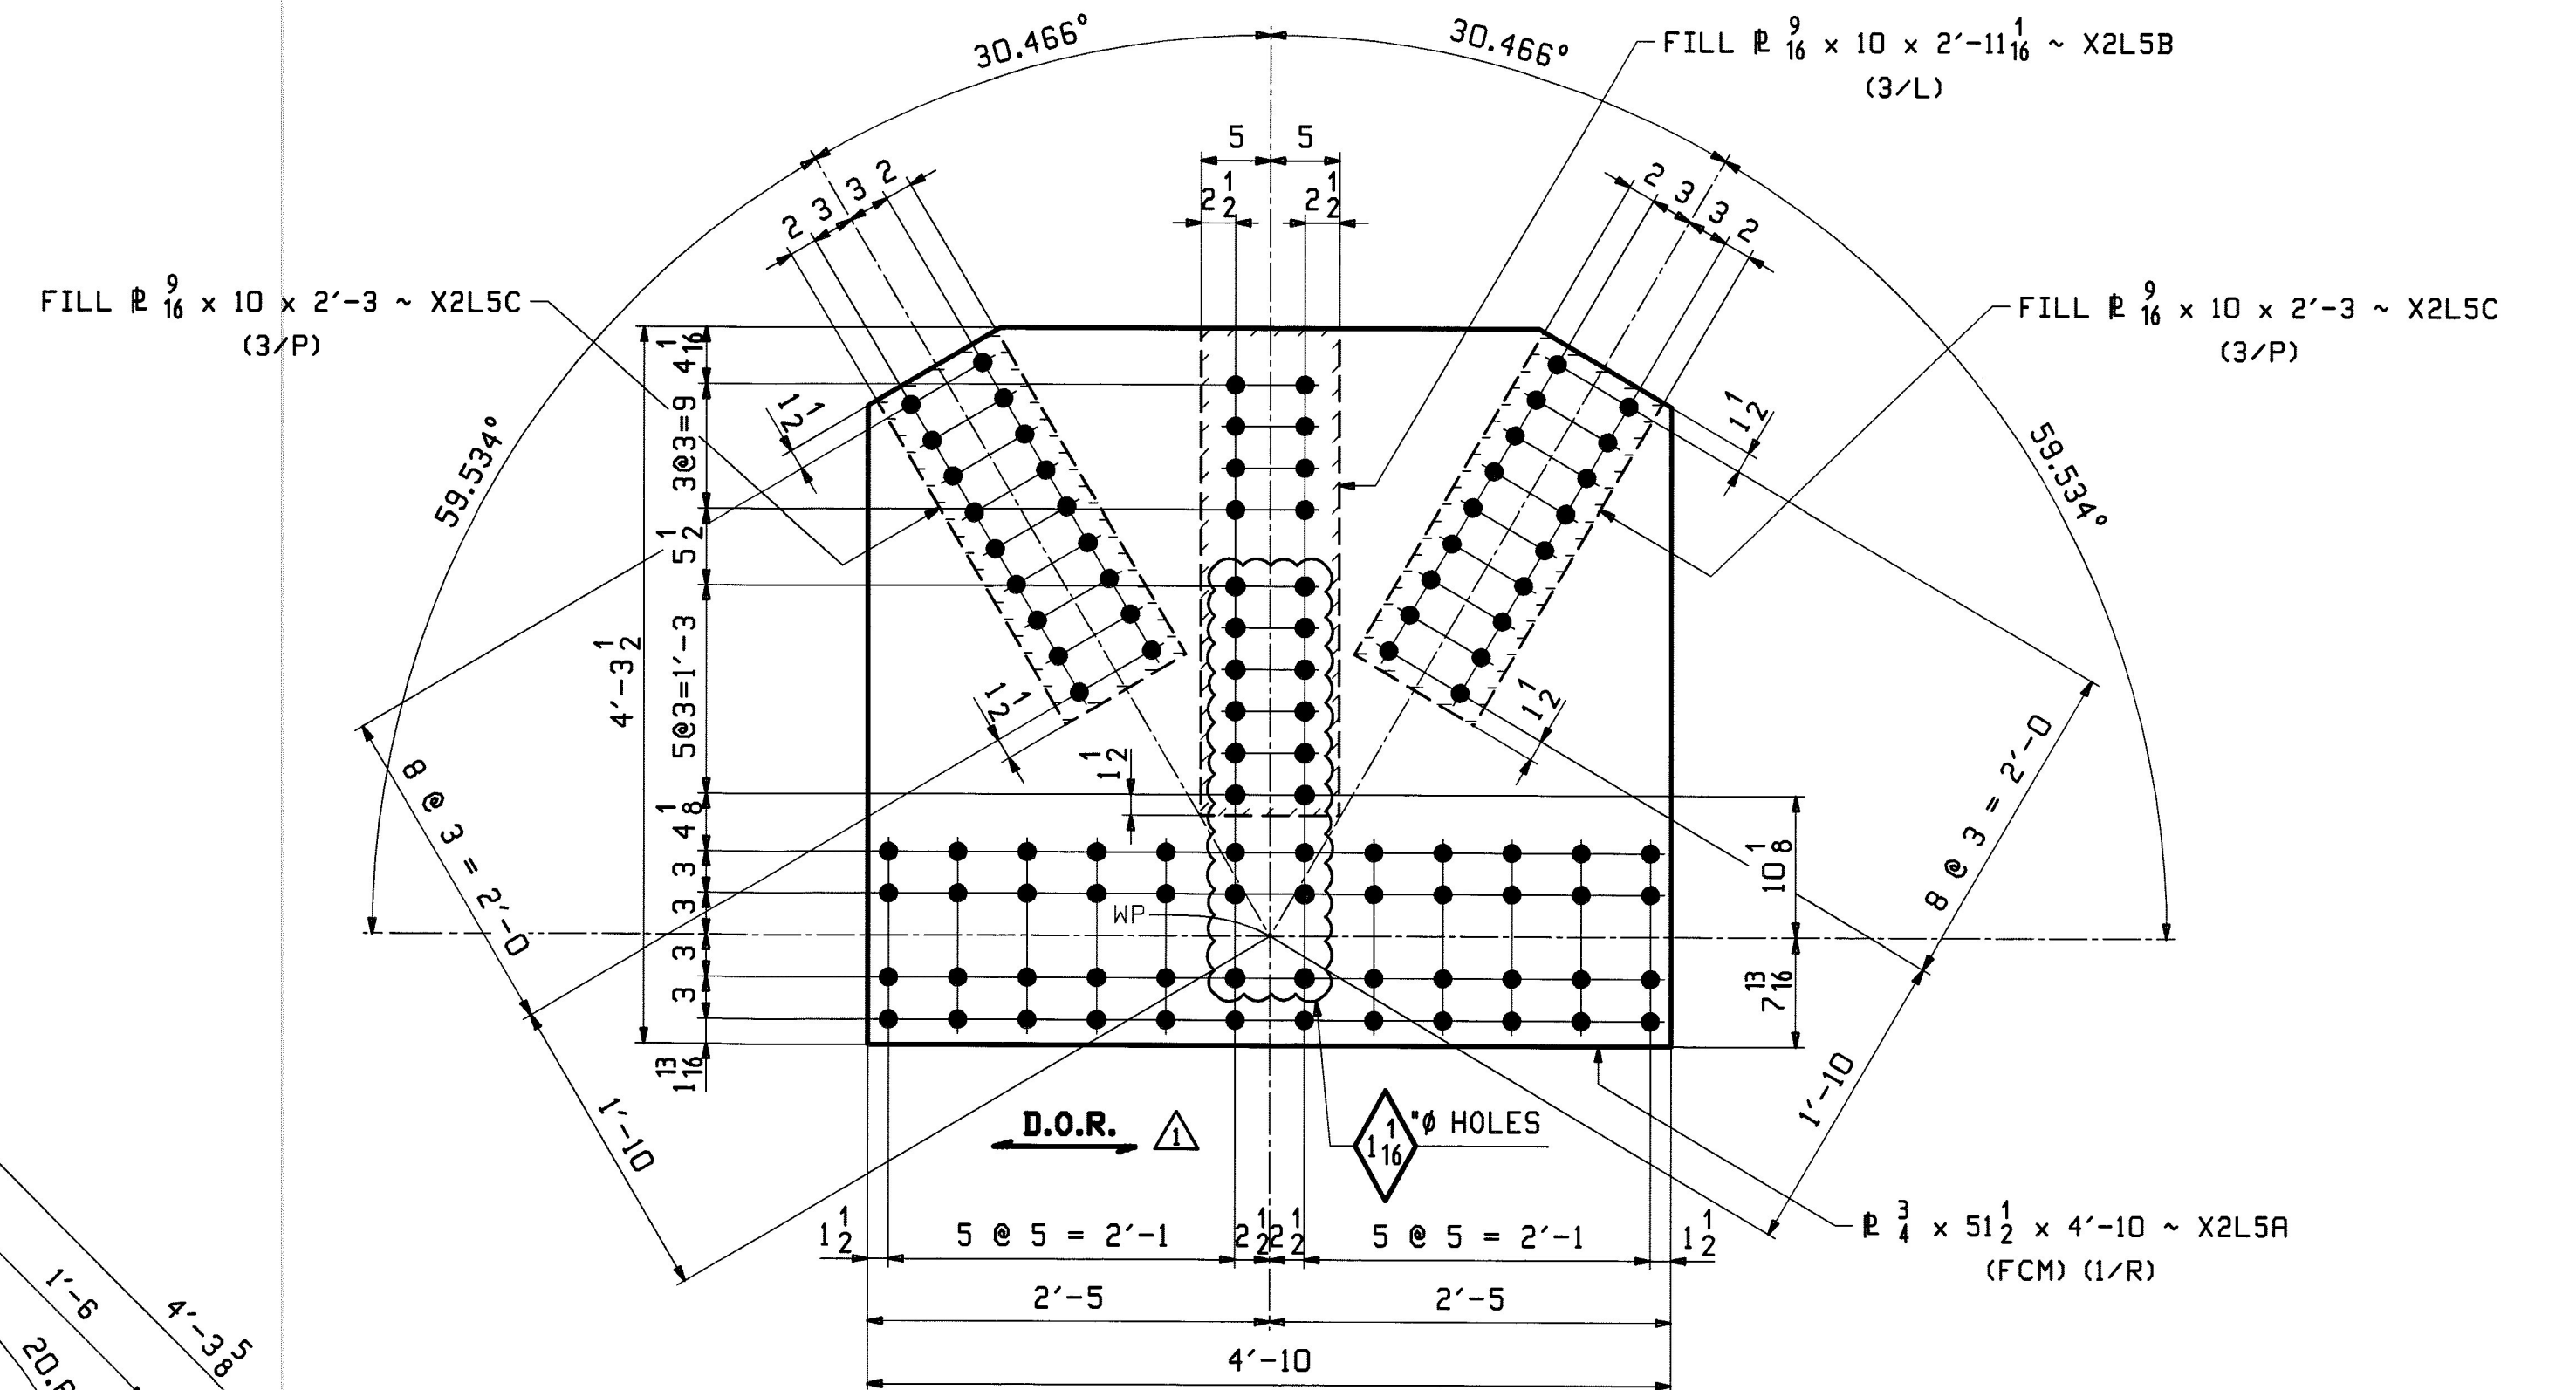

4 ~ GUSSET PLATE ~ X2L5A
 INTERIOR & EXTERIOR GUSSET @ L5
4 ~ FILL PLATE ~ X2L5B
8 ~ FILL PLATE ~ X2L5C

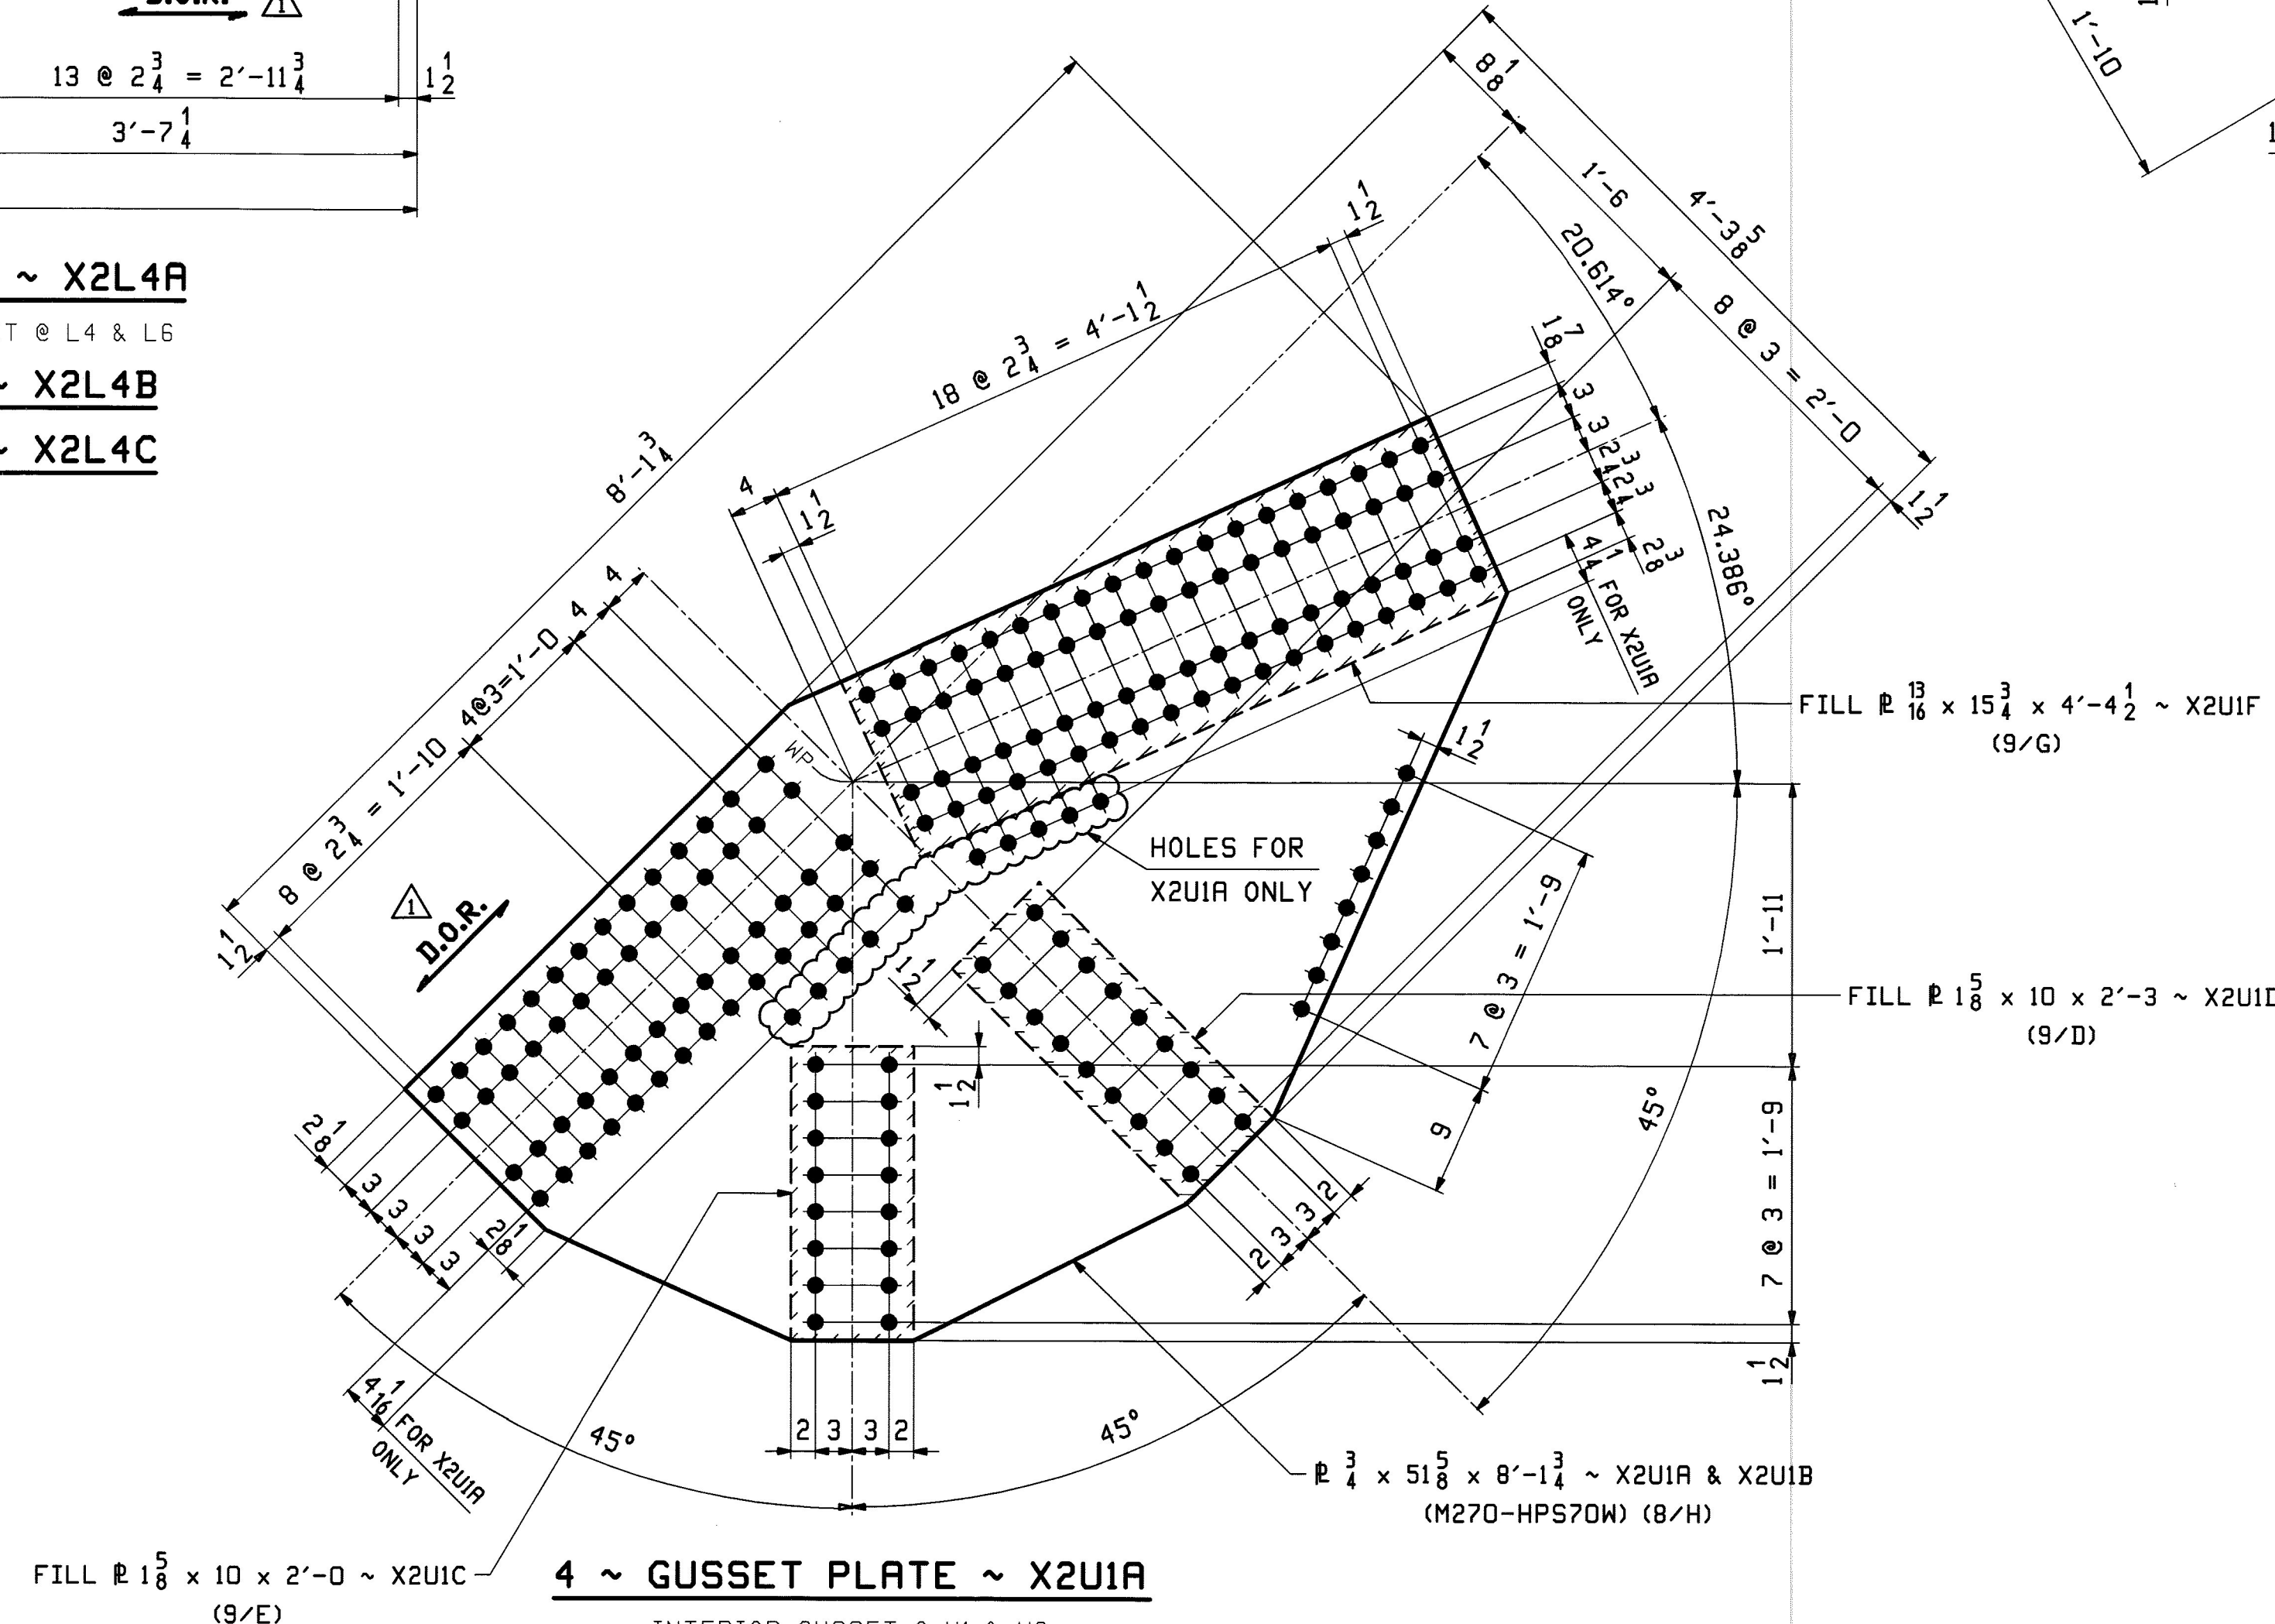

4 ~ GUSSET PLATE ~ X2UIA
 INTERIOR GUSSET @ U1 & U9
4 ~ GUSSET PLATE ~ X2UIB
 EXTERIOR GUSSET @ U1 & U9
8 ~ FILL PLATE ~ X2UIC
8 ~ FILL PLATE ~ X2UID
8 ~ FILL PLATE ~ X2UIF

- NOTES:
 1. FOR GENERAL NOTES SEE SHEET GNI.
 2. FCM - DENOTES FRACTURE CRITICAL MATERIAL.
 3. **D.O.R.** - DENOTES DIRECTION OF ROLLING.

REV.	DATE	REMARKS	DWN	CHK	APVL	SHOP
12/1/11		ADD D.O.R.	EEO	PCP		
MATERIAL:		SURFACE PREP. & PAINT:		HOLES:		SHOP BOLTS:
M270-50 (UN)		HOT-DIP GALV.		15/16" (UN)		NONE
DESCRIPTION: TRUSS STANDARDS						
CASCO BAY STEEL STRUCTURES, INC.						
1 WALLACE AVE.			PHONE (207) 780-6722			
SOUTH PORTLAND, ME 04106			FAX. (207) 780-6726			
STRUCTURE: VT RTE 107 OVER WHITE RIVER					DATE:	
					EEO	10/04
					CHKD:	DATE:
					PCP	10/08
LOCATION: BETHEL, VT.					JOB NO.	DWG NO.
PROJ NO. BRF 022-1(14)					498	X2
CUSTOMER: BECK & BELLUCCI					REV.	A

Vermont Agency of Transportation
RECEIVED
 CK'D BY M.C.L. OK'D BY S.S.S.
 January 10 2012
 RESUBMIT APPROVED
 BY J. LACROIX DATE 01-12-2012

EEO File: Dec 1, 2011 02:02:50 PM