


ABM INFO		BILL OF MATERIAL				JOB NO.	DRAWING NO.	REV.	
PAGE	LINE	MARK	QTY	MARK	MATERIAL	LENGTH	REMARKS	WT	PROCUREMENT NOTES
					FT	INCHES			
		7SIB	1		STRINGER			12457	
		7SIC	1		STRINGER			12457	
		7SID	1		STRINGER			12457	
		7SIE	1		STRINGER			12457	
		7SIF	1		STRINGER			12457	
		7SIG	1		STRINGER			12457	
		7SIH	1		STRINGER			12457	
		7SIJ	1		STRINGER			12457	
1	Y		8	a7	W 24x55	24	8 1/4	M270-50T2	10863
2	Z		16	x5aa	L 4x4x 1/2	1	1 1/2	M270-35	230
2	Z		16	x5ab	L 4x4x 1/2	1	1 1/2	M270-35	230
20	C		880		STUD 7/8"	0	6	2108	1015
21	D		128		7/8" HSB	0	2 1/2	MECH. GALV. F436	103
21	X		128		7/8" HSB	0	2 1/2	MECH. GALV. F436	9
21	Y		128		LOAD IND. WASH FOR 7/8" HSB	0	2 1/2	MECH. GALV. F436	9
		7SSB	1		STRINGER			12457	
		7SSC	1		STRINGER			12457	
		7SSD	1		STRINGER			12457	
		7SSE	1		STRINGER			12457	
		7SSF	1		STRINGER			12457	
		7SSG	1		STRINGER			12457	
		7SSH	1		STRINGER			12457	
		7SSJ	1		STRINGER			12457	
1	Y		8	b7	W 24x55	24	8 1/4	M270-50T2	10863
2	Z		16	x5aa	L 4x4x 1/2	1	1 1/2	M270-35	230
2	Z		16	x5ab	L 4x4x 1/2	1	1 1/2	M270-35	230
20	C		880		STUD 7/8"	0	6	2108	1015
21	D		128		7/8" HSB	0	2 1/2	MECH. GALV. F436	103
21	X		128		7/8" HSB	0	2 1/2	MECH. GALV. F436	9
21	Y		128		LOAD IND. WASH FOR 7/8" HSB	0	2 1/2	MECH. GALV. F436	9

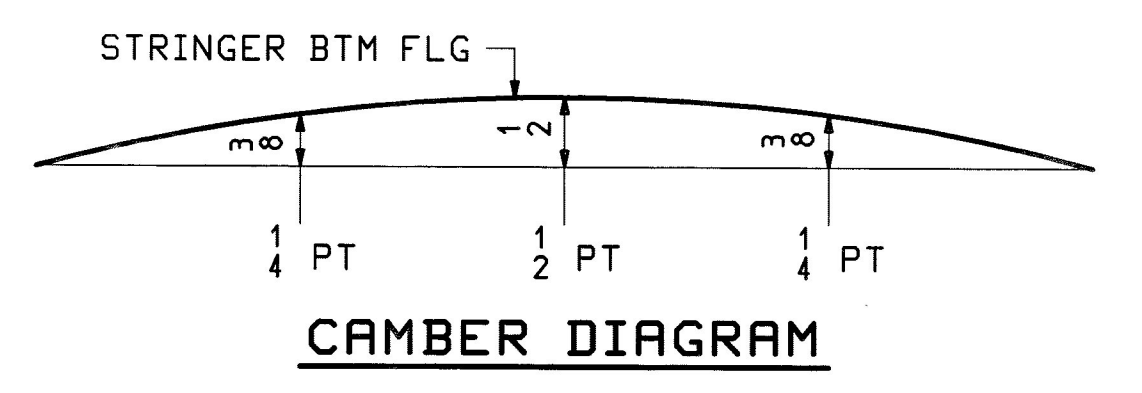

- NOTES:
- MILL CAMBER UP.
 - FOR GENERAL NOTES SEE DWG. GNI.
 - FOR STANDARD DETAILS SEE DWG. X5.
 - ALL BOLTS SHALL BE FULLY TORQUED (UN).
 - EACH BOLT SHALL HAVE 1-HARD FLAT WASHER & 1-LOAD INDICATOR WASHER.
 - T2 DENOTES MATERIAL SUBJECT TO CHARTY V-NOTCH TESTING

Vermont Agency of Transportation
RECEIVED
CK'D BY M.C.L. OK'D BY S.S.S.
January 10 2012
RESUBMIT APPROVED ✓
BY J. LACROIX DATE 01-12-2012

REV.	DATE	REMARKS	DWN	CHK	APVL	SHOP
1	1/03/12	APPROVAL COMMENTS	EEO	PCP	JAN 9 2012	
0					NOV 18 2011	

MATERIAL: M270-50 (UN) SURFACE PREP. & PAINT: HOT-DIP GALV. HOLES: 15/16" (UN) SHOP BOLTS: 7/8" (UN)

DESCRIPTION: STRINGERS

CASCO BAY STEEL STRUCTURES, INC.
1 WALLACE AVE. PHONE (207) 780-6722
SOUTH PORTLAND, ME 04106 FAX. (207) 780-6726

STRUCTURE: VT RTE 107 OVER WHITE RIVER DRAWN: TJB DATE: 10/15
CHKD: PCP DATE: 10/21

LOCATION: BETHEL, VT. JOB NO. 498 DWG NO. 7
PROJ NO. BRF 022-1(14) REV. 1
CUSTOMER: BECK & BELLUCCI