



ONE ~ MID CHORD ~ 15MC5W (M34 - M4 WEST) **ONE ~ MID CHORD ~ 15MC10W** (M67 - M6 WEST)
ONE ~ MID CHORD ~ 15MC5E (M34 - M4 EAST) **ONE ~ MID CHORD ~ 15MC10E** (M67 - M6 EAST)

ALL ALIKE EXCEPT FOR MARK

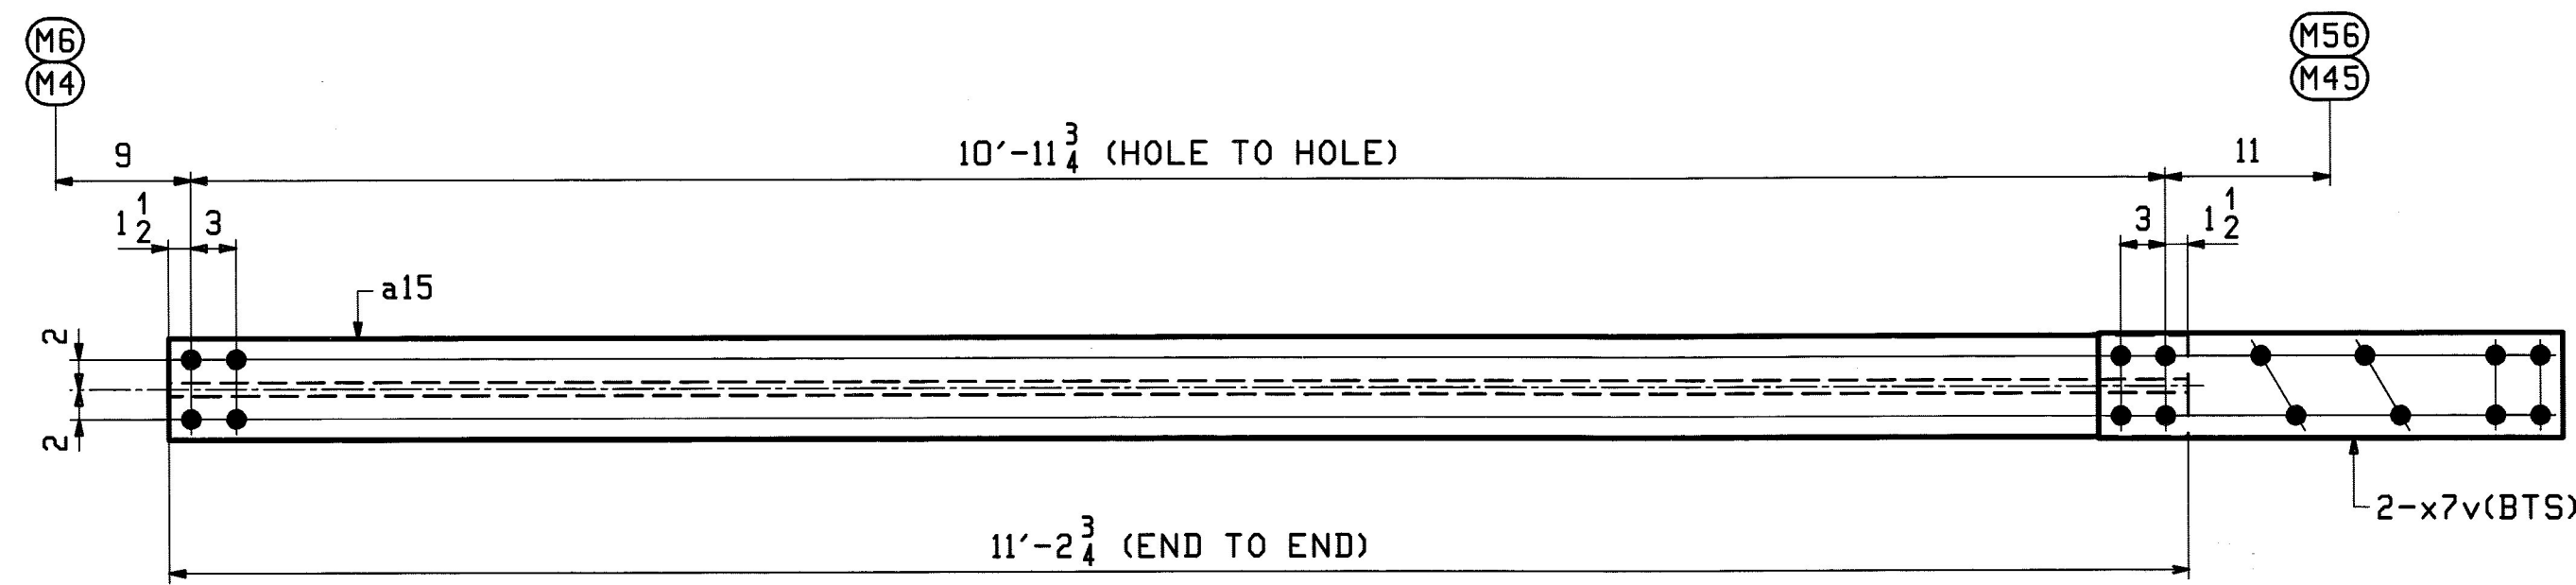


ONE ~ MID CHORD ~ 15MC6W (M4 - M45 WEST) **ONE ~ MID CHORD ~ 15MC9W** (M6 - M56 WEST)
ONE ~ MID CHORD ~ 15MC6E (M4 - M45 EAST) **ONE ~ MID CHORD ~ 15MC9E** (M6 - M56 EAST)

ALL ALIKE EXCEPT FOR MARK

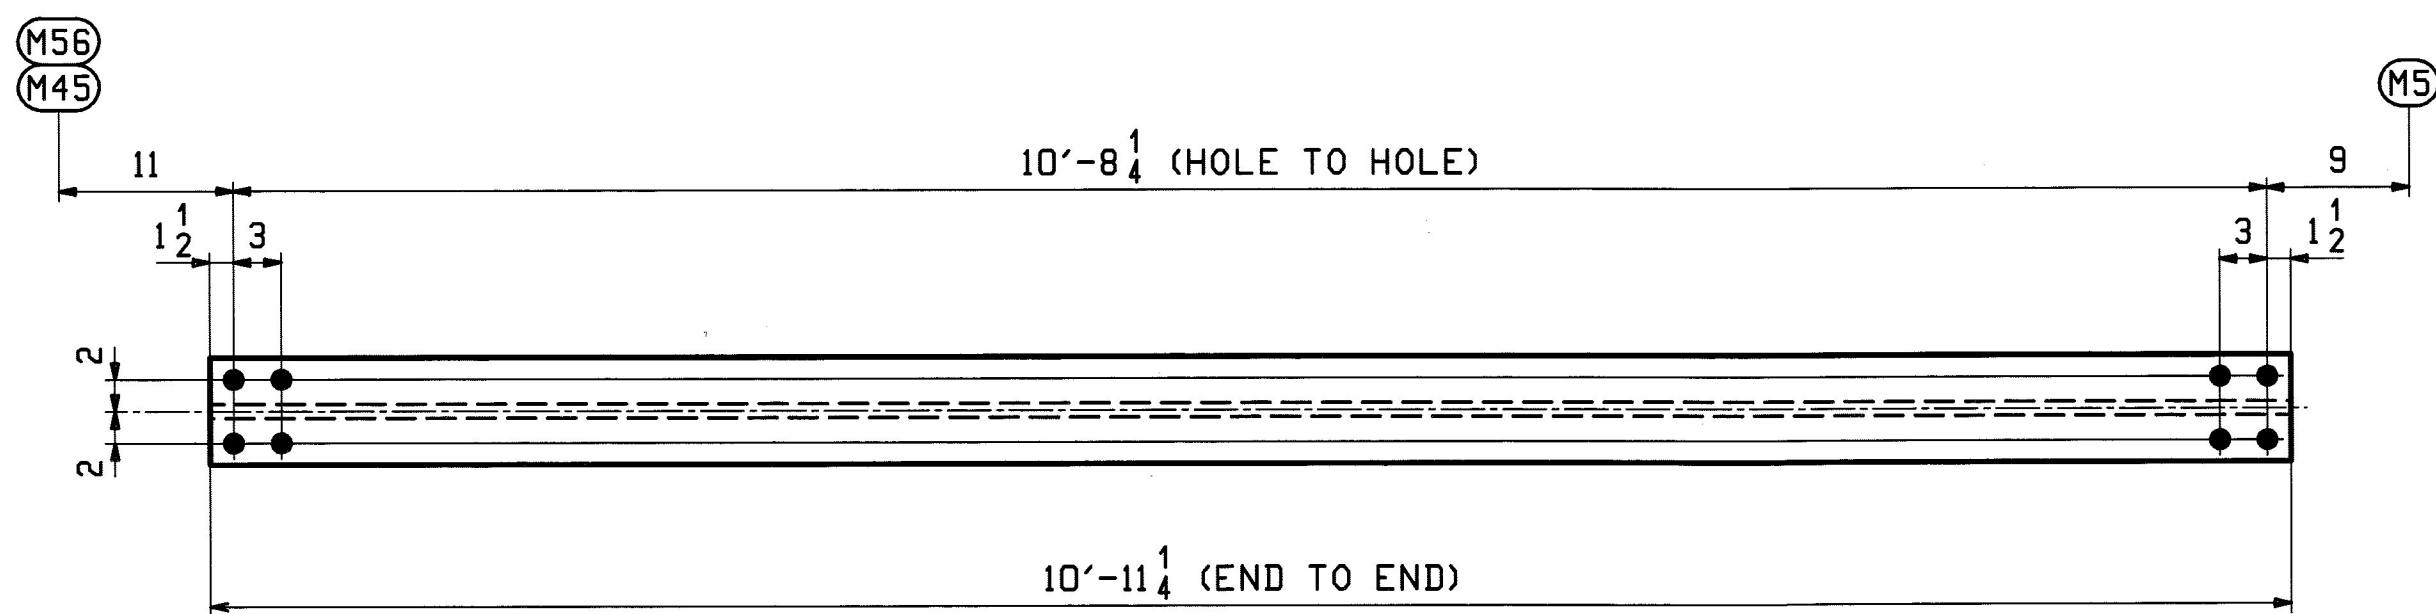

ONE ~ MID CHORD ~ 15MC8W (M56 - M5 WEST) **ONE ~ MID CHORD ~ 15MC8E** (M56 - M5 EAST)
ONE ~ MID CHORD ~ 15MC7E (M45 - M5 EAST)

ALL ALIKE EXCEPT FOR MARK

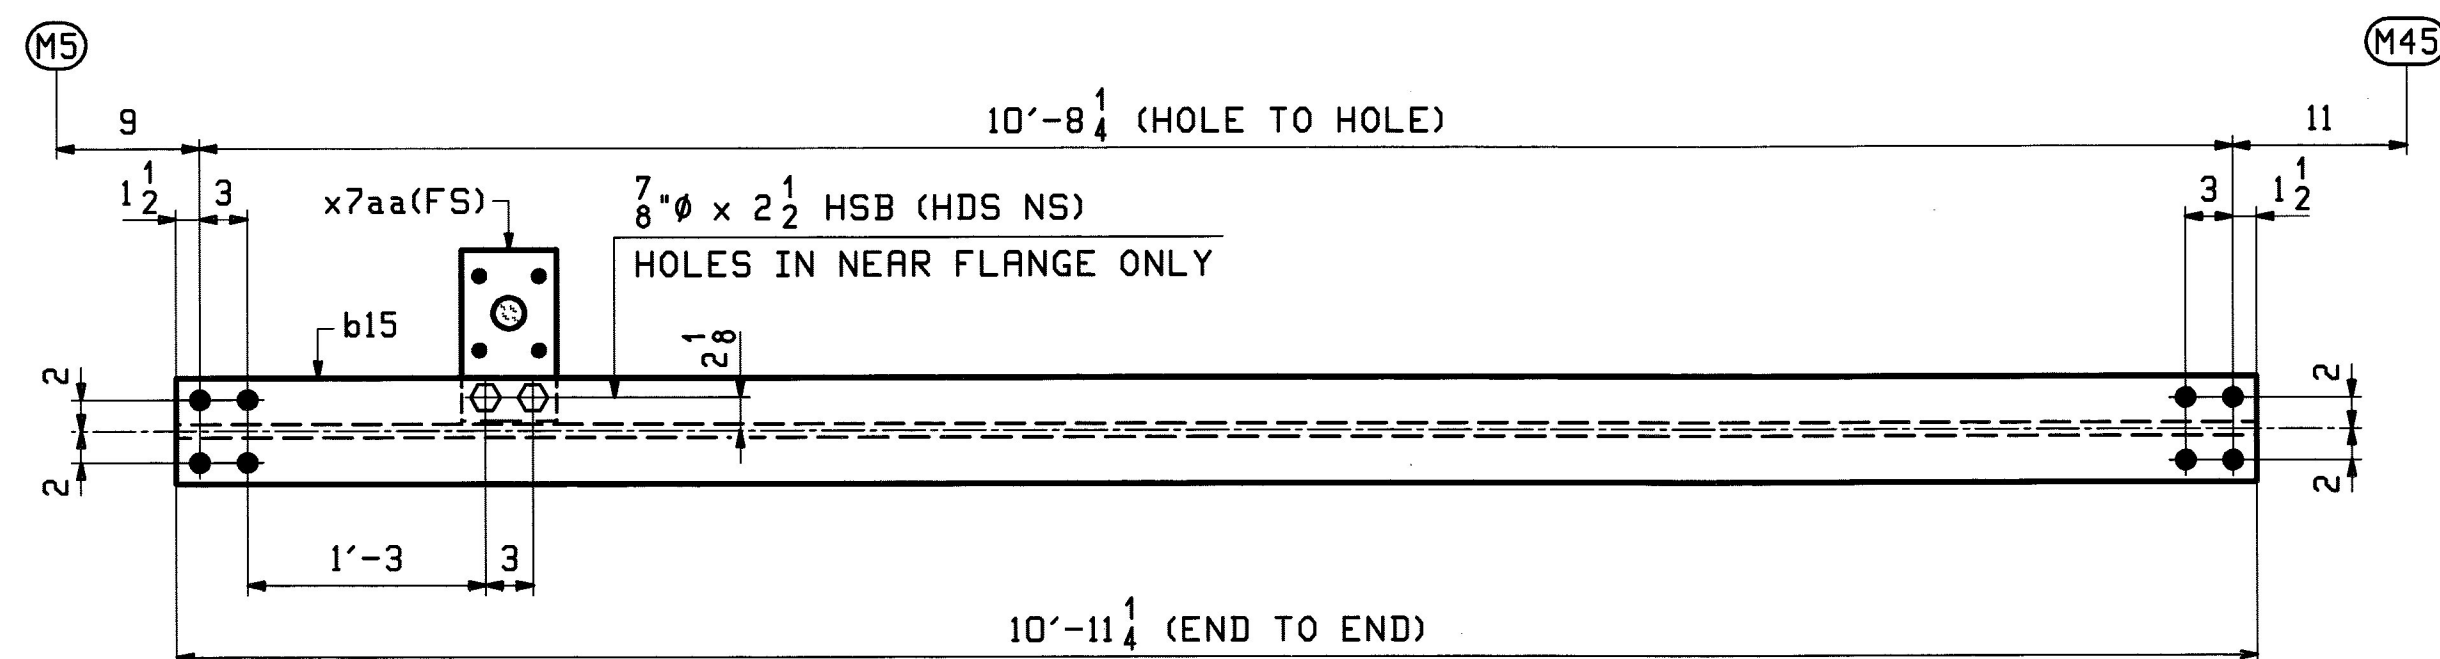

ONE ~ MID CHORD ~ 15MC7W (M5 - M45 WEST)

ABM INFO		SHIP		BILL OF MATERIAL				JOB NO.		DRAWING NO.		REV.
PRGE	LINE	MARK	QTY	MARK	MATERIAL	LENGTH FT INCHES		REMARKS	WT	PROCUREMENT NOTES		
								498		15		
4	H	15MC5W	1		W 14x30	11	4 11/16		342			
4	H	15MC5E	1		W 14x30	11	4 11/16		342			
4	H	15MC10W	1		W 14x30	11	4 11/16		342			
4	H	15MC10E	1		W 14x30	11	4 11/16		342			
		15MC6W	1		MID CHORD				398			
4	J		1	a15	W 14x30	11	2 3/4		337			
5	L		2	x7v	PL 1/2x7	2	7		62			
		15MC6E	1		MID CHORD				398			
4	J		1	a15	W 14x30	11	2 3/4		337			
5	L		2	x7v	PL 1/2x7	2	7		62			
		15MC9W	1		MID CHORD				398			
4	J		1	a15	W 14x30	11	2 3/4		337			
5	L		2	x7v	PL 1/2x7	2	7		62			
		15MC9E	1		MID CHORD				398			
4	J		1	a15	W 14x30	11	2 3/4		337			
5	L		2	x7v	PL 1/2x7	2	7		62			
		15MC7W	1		MID CHORD				339			
4	K		1	b15	W 14x30	10	11 1/4		328			
5	P		1	x7aa	PL 1/2x6	0	10 7/8		9			
21	D		2		7/8 HSB	0	2 1/2	MECH. GALV. F436	.14			
21	X		2		7/8 HSB			MECH. GALV. F436	.14			
21	Y		2		LORD IND. 7 WASH FOR 8 HSB			MECH. GALV. F436	.14			
4	K	15MC7E	1		W 14x30	10	11 1/4		328			
4	K	15MC8W	1		W 14x30	10	11 1/4		328			
4	K	15MC8E	1		W 14x30	10	11 1/4		328			

△
 △
- NOTES:
- FOR GENERAL NOTES SEE SHEET GNI.
 - HOLES IN BOTH FLANGES ARE ALIKE, U.N. △

Vermont Agency of Transportation
RECEIVED
 CK'D BY M.C.L. OK'D BY S.S.S.
 January 10 2012
 RESUBMIT APPROVED ✓
 BY J. LACROIX DATE 01-12-2012

1/03/12	APPROVAL COMMENTS	EEO	PCP	REV 9 2011		
0				NOV 18 2011		
REV.	DATE	REMARKS	DWN	CHK	APVL	SHOP
		MATERIAL: M270-50				SHOP BOLTS: NONE
		SURFACE PREP. & PAINT: HOT-DIP GALV.				
		HOLES: 15/16 (UN)				
DESCRIPTION: MID CHORDS						
CASCO BAY STEEL STRUCTURES, INC. 1 WALLACE AVE. PHONE (207) 780-6722 SOUTH PORTLAND, ME 04106 FAX. (207) 780-6726						
STRUCTURE: VT RTE 107 OVER WHITE RIVER		DRAWN: EEO	DATE: 10/11			
		CHKD: PCP	DATE: 11/11			
LOCATION: BETHEL, VT.		JOB NO. 498	DWG NO. 15			
PROJ NO. BRP 022-1(14)						
CUSTOMER: BECK & BELLUCCI						

PCP 1/11/12 10:52 AM 1/11/12 10:52 AM