
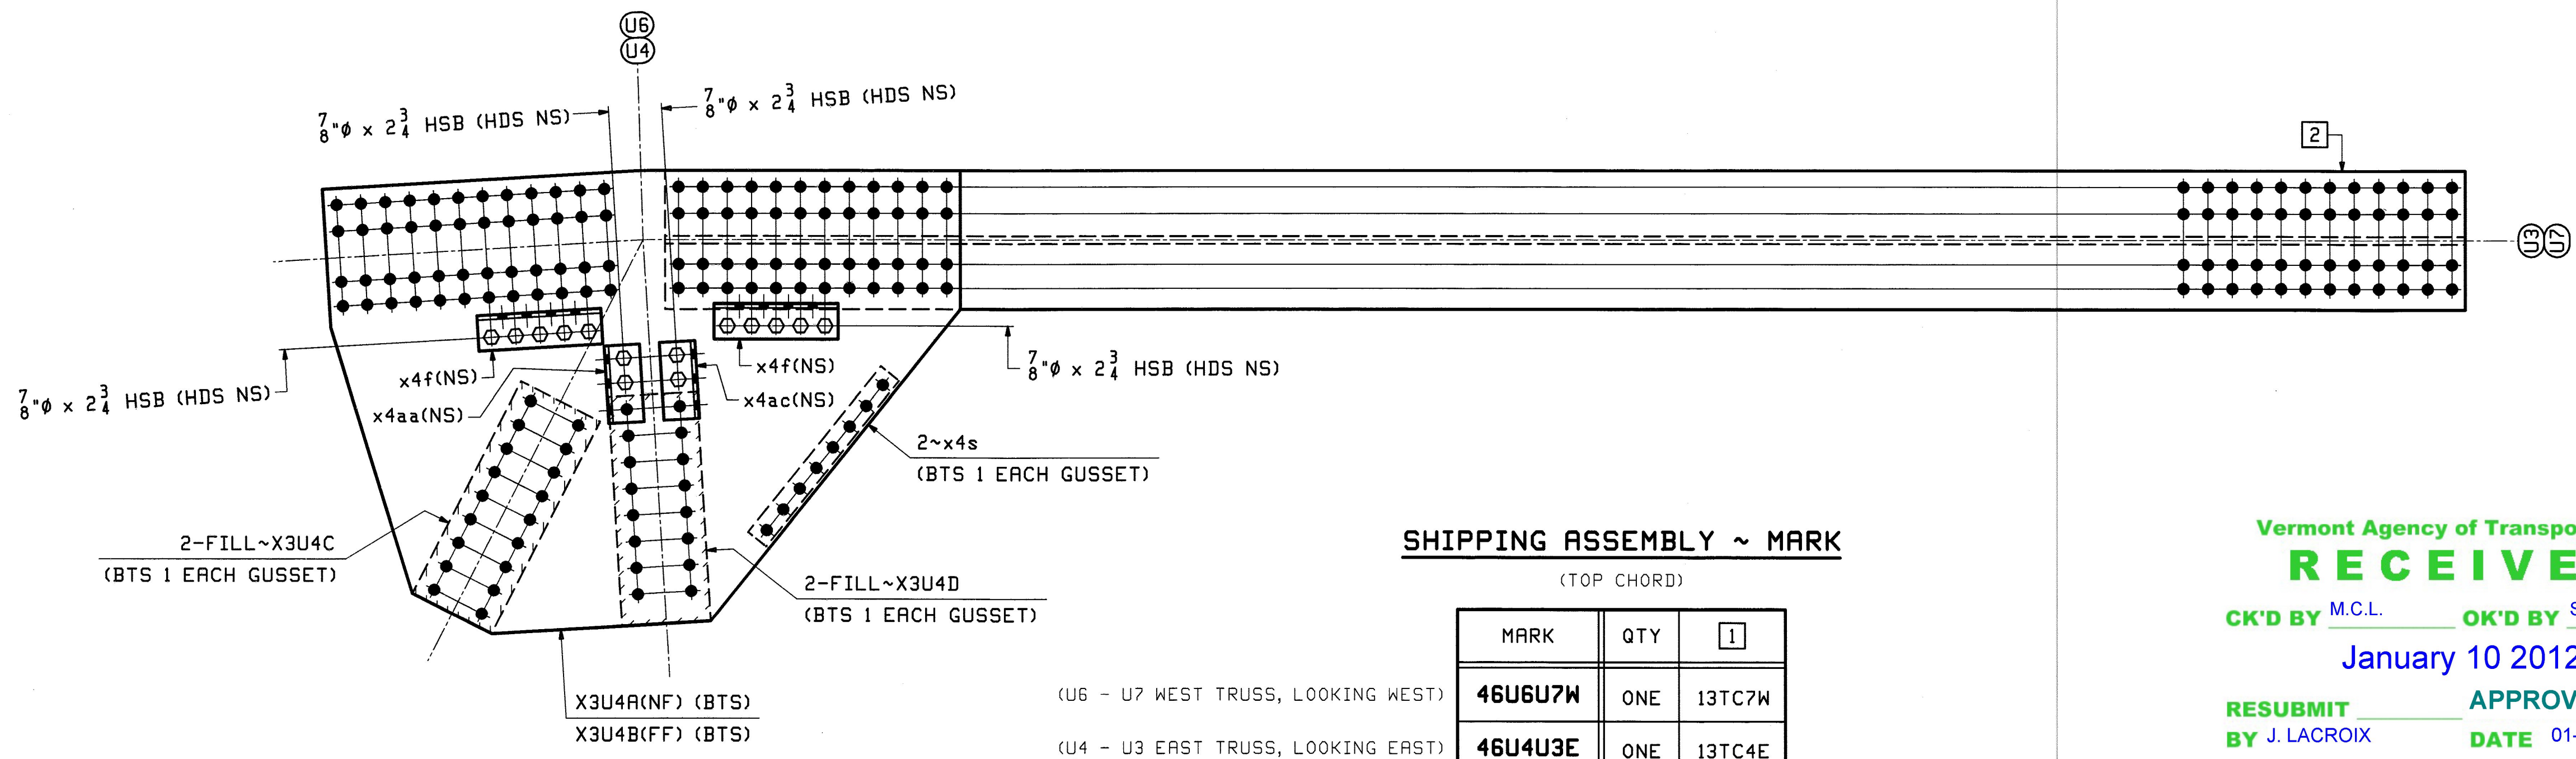


ABM INFO		SHIP	BILL OF MATERIAL				JOB NO.	DRAWING NO.	REV.
PAGE	LINE	MARK	QTY	MARK	MATERIAL	LENGTH FT INCHES	REMARKS	WT	PROCUREMENT NOTES
		46U4U3E	1		TOP CHORD SHIPPING ASS'Y				6667
			1	13TC4E	TOP CHORD				
8	L		1	X3U4A	PL 3/4 x 5 3/8	5 11 15/16	M270-HPS70H		
8	L		1	X3U4B	PL 3/4 x 5 3/8	5 11 15/16	M270-HPS70H		
10	S		2	X3U4C	PL 13/16 x 10	2 3	FILL		
10	T		2	X3U4D	PL 13/16 x 10	2 2	FILL		
10	V		2	x4f	L 4 x 4 x 1/2	1 2	M270-36		
10	W		2	x4s	L 3 x 3 x 5/8	2 0	M270-36		
10	U		1	x4aa	L 6 x 4 x 1/2	0 8 3/4	M270-36		
10	U		1	x4ac	L 6 x 4 x 1/2	0 8 3/4	M270-36		
21	E		14		MECH. GALV. 3325-1	0 2 3/4			
21	X		14		MECH. GALV. F436				
21	Y		14		MECH. GALV. F436				

ABM INFO		SHIP	BILL OF MATERIAL				JOB NO.	DRAWING NO.	REV.
PAGE	LINE	MARK	QTY	MARK	MATERIAL	LENGTH FT INCHES	REMARKS	WT	PROCUREMENT NOTES
		46U3U4W	1		TOP CHORD SHIPPING ASS'Y				6667
			1	13TC4W	TOP CHORD				
8	L		1	X3U4A	PL 3/4 x 5 3/8	5 11 15/16	M270-HPS70H		
8	L		1	X3U4B	PL 3/4 x 5 3/8	5 11 15/16	M270-HPS70H		
10	S		2	X3U4C	PL 13/16 x 10	2 3	FILL		
10	T		2	X3U4D	PL 13/16 x 10	2 2	FILL		
10	V		2	x4f	L 4 x 4 x 1/2	1 2	M270-36		
10	W		2	x4s	L 3 x 3 x 5/8	2 0	M270-36		
10	U		1	x4aa	L 6 x 4 x 1/2	0 8 3/4	M270-36		
10	U		1	x4ac	L 6 x 4 x 1/2	0 8 3/4	M270-36		
21	E		14		MECH. GALV. 3325-1	0 2 3/4			
21	X		14		MECH. GALV. F436				
21	Y		14		MECH. GALV. F436				

ABM INFO		SHIP	BILL OF MATERIAL				JOB NO.	DRAWING NO.	REV.
PAGE	LINE	MARK	QTY	MARK	MATERIAL	LENGTH FT INCHES	REMARKS	WT	PROCUREMENT NOTES
		46U7U6E	1		TOP CHORD SHIPPING ASS'Y				6667
			1	13TC7E	TOP CHORD				
8	L		1	X3U4A	PL 3/4 x 5 3/8	5 11 15/16	M270-HPS70H		
8	L		1	X3U4B	PL 3/4 x 5 3/8	5 11 15/16	M270-HPS70H		
10	S		2	X3U4C	PL 13/16 x 10	2 3	FILL		
10	T		2	X3U4D	PL 13/16 x 10	2 2	FILL		
10	V		2	x4f	L 4 x 4 x 1/2	1 2	M270-36		
10	W		2	x4s	L 3 x 3 x 5/8	2 0	M270-36		
10	U		1	x4aa	L 6 x 4 x 1/2	0 8 3/4	M270-36		
10	U		1	x4ac	L 6 x 4 x 1/2	0 8 3/4	M270-36		
21	E		14		MECH. GALV. 3325-1	0 2 3/4			
21	X		14		MECH. GALV. F436				
21	Y		14		MECH. GALV. F436				

ABM INFO		SHIP	BILL OF MATERIAL				JOB NO.	DRAWING NO.	REV.
PAGE	LINE	MARK	QTY	MARK	MATERIAL	LENGTH FT INCHES	REMARKS	WT	PROCUREMENT NOTES
		46U6U7W	1		TOP CHORD SHIPPING ASS'Y				6667
			1	13TC7W	TOP CHORD				
8	L		1	X3U4A	PL 3/4 x 5 3/8	5 11 15/16	M270-HPS70H		
8	L		1	X3U4B	PL 3/4 x 5 3/8	5 11 15/16	M270-HPS70H		
10	S		2	X3U4C	PL 13/16 x 10	2 3	FILL		
10	T		2	X3U4D	PL 13/16 x 10	2 2	FILL		
10	V		2	x4f	L 4 x 4 x 1/2	1 2	M270-36		
10	W		2	x4s	L 3 x 3 x 5/8	2 0	M270-36		
10	U		1	x4aa	L 6 x 4 x 1/2	0 8 3/4	M270-36		
10	U		1	x4ac	L 6 x 4 x 1/2	0 8 3/4	M270-36		
21	E		14		MECH. GALV. 3325-1	0 2 3/4			
21	X		14		MECH. GALV. F436				
21	Y		14		MECH. GALV. F436				

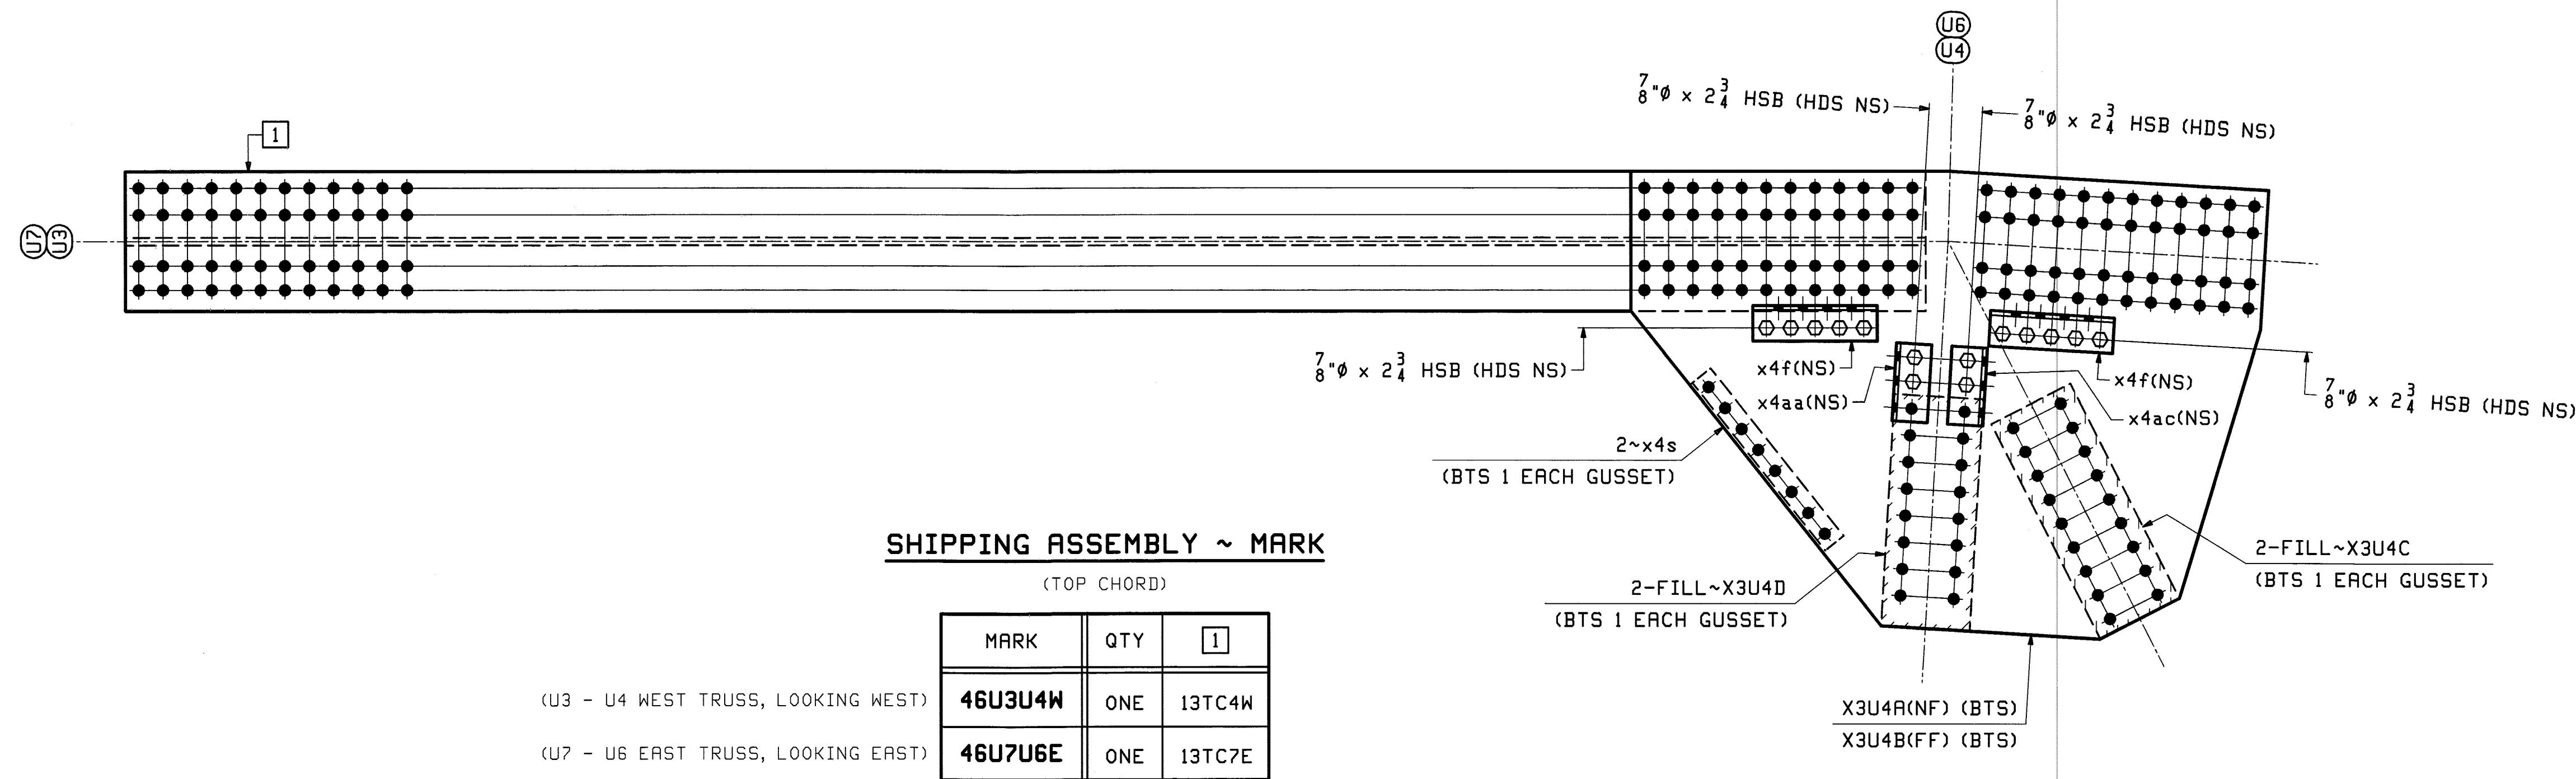

Vermont Agency of Transportation
RECEIVED
CK'D BY M.C.L. OK'D BY S.S.S.
January 10 2012
RESUBMIT APPROVED ✓
BY J. LACROIX DATE 01-12-2012

- NOTES:
1. NF - DENOTES NEAR FACE OF TOP CHORD.
2. FF - DENOTES FAR FACE OF TOP CHORD.
3. NS - DENOTES NEAR SIDE.
4. FS - DENOTES FAR SIDE.

REV.	DATE	REMARKS	DWN	CHK	APVL	SHOP
0						
MATERIAL:		SURFACE PREP. & PAINT:		HOLES:		SHOP BOLTS:
M270-50 (UN)		HOT-DIP GALV.		15 16φ (UN)		7 8φ (UN)
DESCRIPTION: SHIPPING ASSEMBLY (U3-U4, U7-U6, U6-U7 & U4-U3)						
CASCO BAY STEEL STRUCTURES, INC. 1 WALLACE AVE. PHONE (207) 780-6722 SOUTH PORTLAND, ME 04106 FAX. (207) 780-6726						
STRUCTURE: VT RTE 107 OVER WHITE RIVER			DRAWN:		DATE:	
			EE0		11/22	
			CHKD:		DATE:	
			PCP		11/28	
LOCATION: BETHEL, VT.			JOB NO.		DWG NO.	
PROJ NO. BRF 022-1(14)			498		46	
CUSTOMER: BECK & BELLUCCI					REV. △	

EEO - Ind. No. 28, 2011 03/24/2012 1:46 PM