



ABM INFO		SHIP		BILL OF MATERIAL				JOB NO.	DRAWING NO.	REV.
								498	47	
PAGE	LINE	MARK	QTY	MARK	MATERIAL	LENGTH		REMARKS	WT	PROCUREMENT NOTES
						FT	INCHES			
					47U4U5W	1		TOP CHORD SHIPPING ASS'Y		6484
					13TC5W			TOP CHORD		
8	M		1	X3U5A	PL 3/4 x 4 3/8	5	11 1/2	M270-HP5Z0H		
8	M		1	X3U5B	PL 3/4 x 4 3/8	5	11 1/2	M270-HP5Z0H		
11	F		2	X3U5C	PL 1/2 x 10	2	0	FILL		
11	H		2	x4f	L 4 x 4 x 1/2	1	2	M270-36		
11	J		4	x4s	L 3 x 3 x 3/8	2	0	M270-36		
11	G		1	x4aa	L 6 x 4 x 1/2	0	8 3/4	M270-36		
11	G		1	x4ac	L 6 x 4 x 1/2	0	8 3/4	M270-36		
21	E		14	7/8 HSB		0	2 3/4	MECH. GALV. F438-1		
21	X		14	7/8 HSW				MECH. GALV. F438		
21	Y		14	LOAD IND. 7/8 HSB FOR 8 HSB				MECH. GALV. F438		
					47U5U4E	1		TOP CHORD SHIPPING ASS'Y		6484
					13TC5E			TOP CHORD		
8	M		1	X3U5A	PL 3/4 x 4 3/8	5	11 1/2	M270-HP5Z0H		
8	M		1	X3U5B	PL 3/4 x 4 3/8	5	11 1/2	M270-HP5Z0H		
11	F		2	X3U5C	PL 1/2 x 10	2	0	FILL		
11	H		2	x4f	L 4 x 4 x 1/2	1	2	M270-36		
11	J		4	x4s	L 3 x 3 x 3/8	2	0	M270-36		
11	G		1	x4aa	L 6 x 4 x 1/2	0	8 3/4	M270-36		
11	G		1	x4ac	L 6 x 4 x 1/2	0	8 3/4	M270-36		
21	E		14	7/8 HSB		0	2 3/4	MECH. GALV. F438-1		
21	X		14	7/8 HSW				MECH. GALV. F438		
21	Y		14	LOAD IND. 7/8 HSB FOR 8 HSB				MECH. GALV. F438		

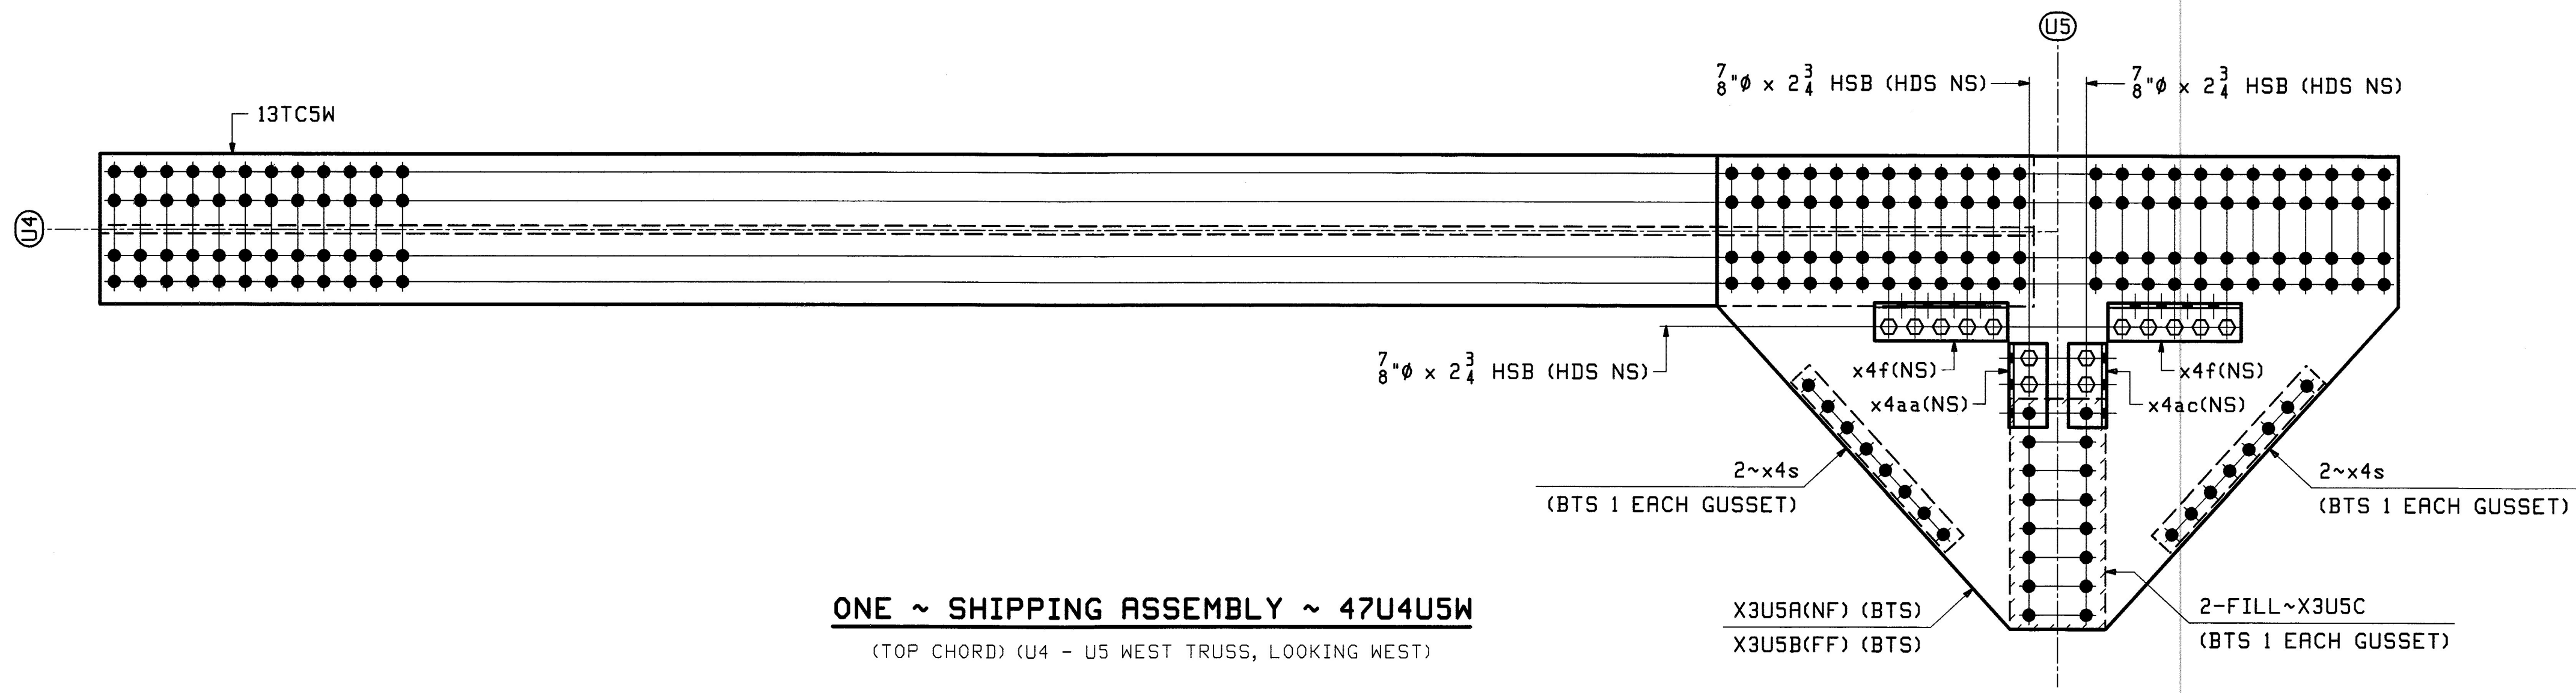

**ONE ~ SHIPPING ASSEMBLY ~ 47U4U5W**  
(TOP CHORD) (U4 - U5 WEST TRUSS, LOOKING WEST)

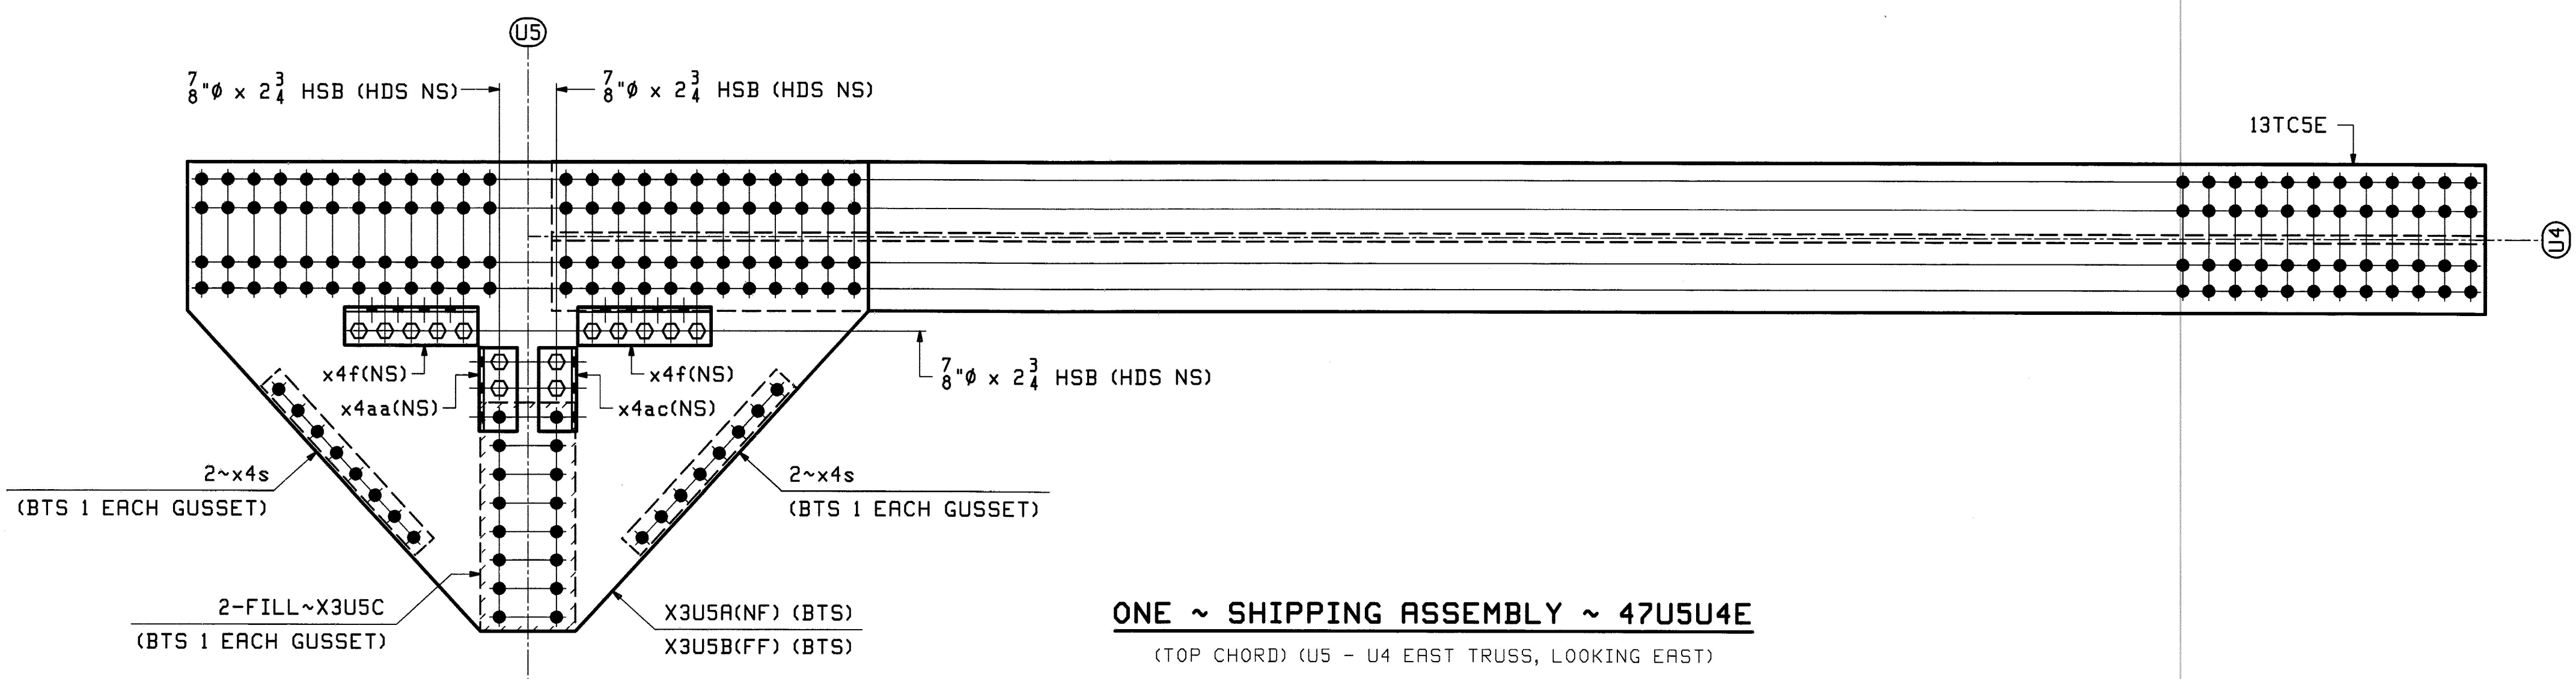

**ONE ~ SHIPPING ASSEMBLY ~ 47U5U4E**  
(TOP CHORD) (U5 - U4 EAST TRUSS, LOOKING EAST)

- NOTES:
1. NF - DENOTES NEAR FACE OF TOP CHORD.
  2. FF - DENOTES FAR FACE OF TOP CHORD.
  3. NS - DENOTES NEAR SIDE.
  4. FS - DENOTES FAR SIDE.

Vermont Agency of Transportation  
**RECEIVED**  
CK'D BY M.C.L. OK'D BY S.S.S.  
January 10 2012  
RESUBMIT APPROVED ✓  
BY J. LACROIX DATE 01-12-2012

REV.	DATE	REMARKS	DWN	CHK	APVL	SHOP
0						
MATERIAL:		SURFACE PREP. & PAINT:		HOLES:		SHOP BOLTS:
M270-50 (UN)		HOT-DIP GALV.		15 16 Ø (UN)		7 8 Ø (UN)
DESCRIPTION: SHIPPING ASSEMBLY (U4-U5 WEST & U5-U4 EAST)						
CASCO BAY STEEL STRUCTURES, INC. 1 WALLACE AVE. SOUTH PORTLAND, ME 04106 PHONE (207) 780-6722 FAX. (207) 780-6726						
STRUCTURE: VT RTE 107 OVER WHITE RIVER					DRAWN:	DATE:
					EEO	11/22
					CHKD:	DATE:
					PCP	11/28
LOCATION: BETHEL, VT.					JOB NO.	DWG NO.
PROJ NO. BRF 022-1(14)					498	47
CUSTOMER: BECK & BELLUCCI					REV.	△