


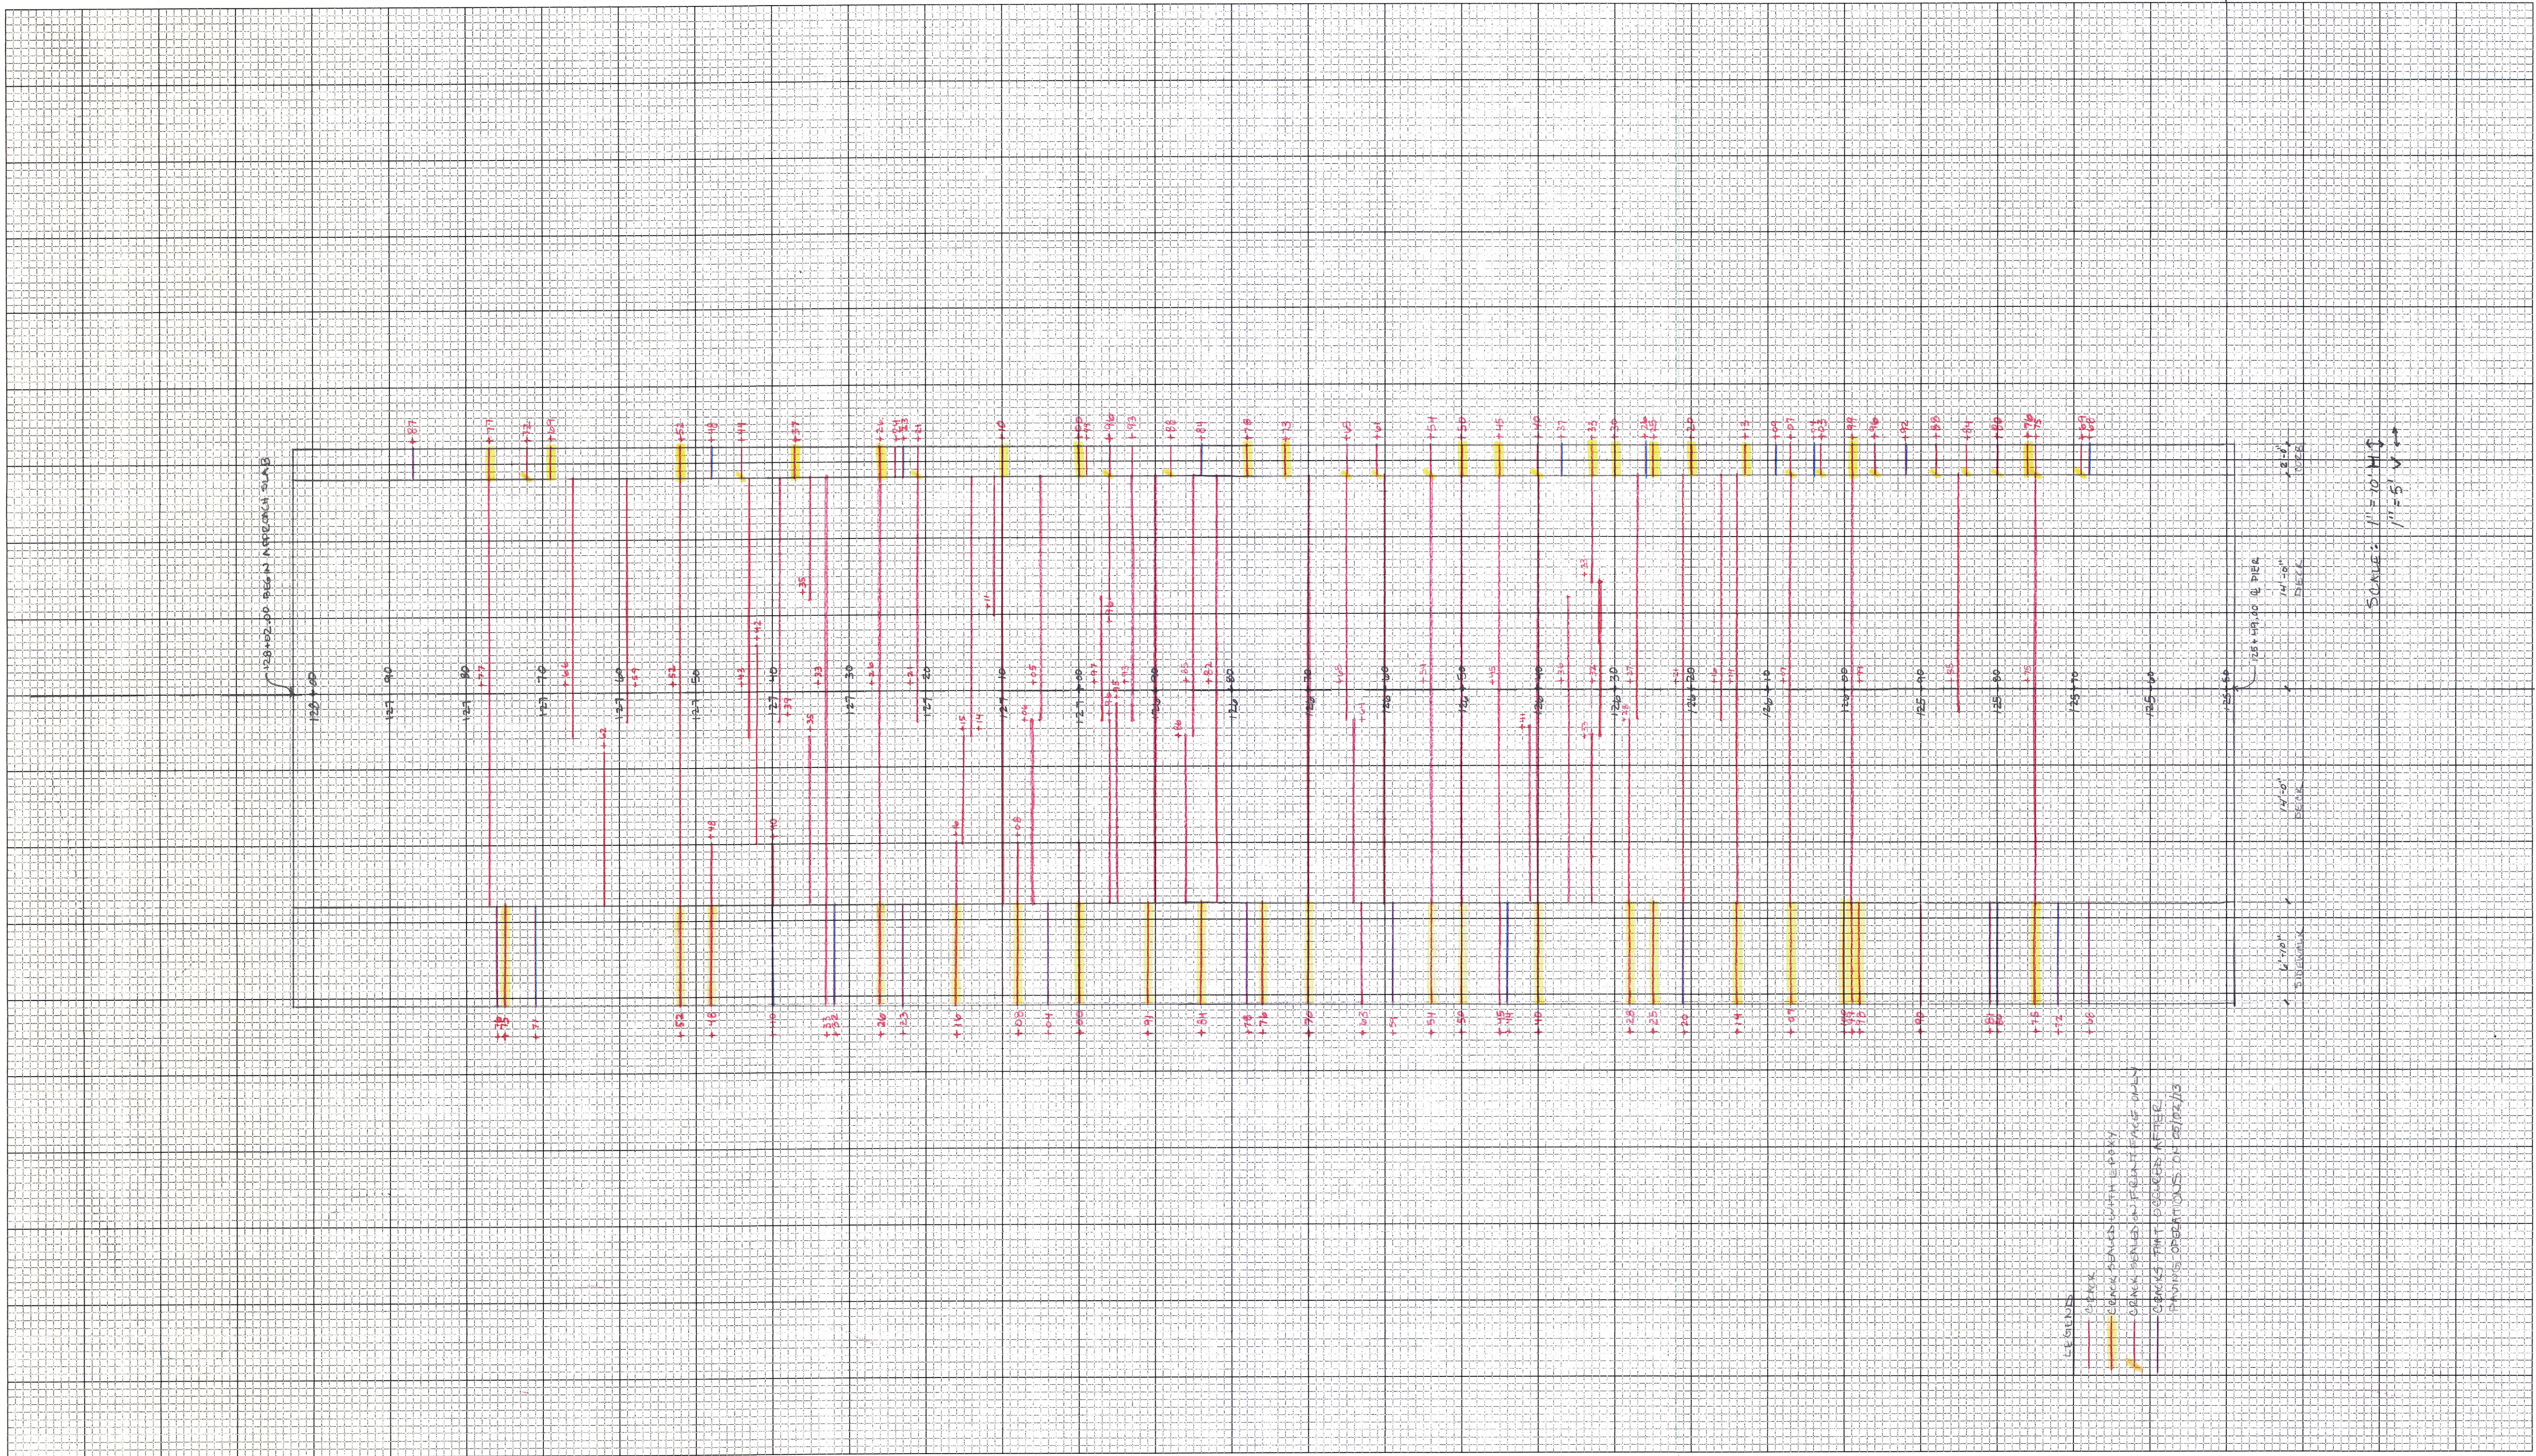

CROSS SECTION SHEET

PROJECT NAME:	BETHEL CRACKS IN SLAB
PROJECT NUMBER:	BRF 022-1(14) SCHMITT 04-23-13
FILE NAME:	
PROJECT LEADER:	
DESIGNED BY:	
const: g:/common/cadd/e-xsection.dgn	
PLOT DATE:	05-JUN-2000 09
DRAWN BY:	
CHECKED BY:	
SHEET	OF