



MATCHLINE - STA. 20+200 - SEE EPSC FINAL CONDITIONS PLAN 2

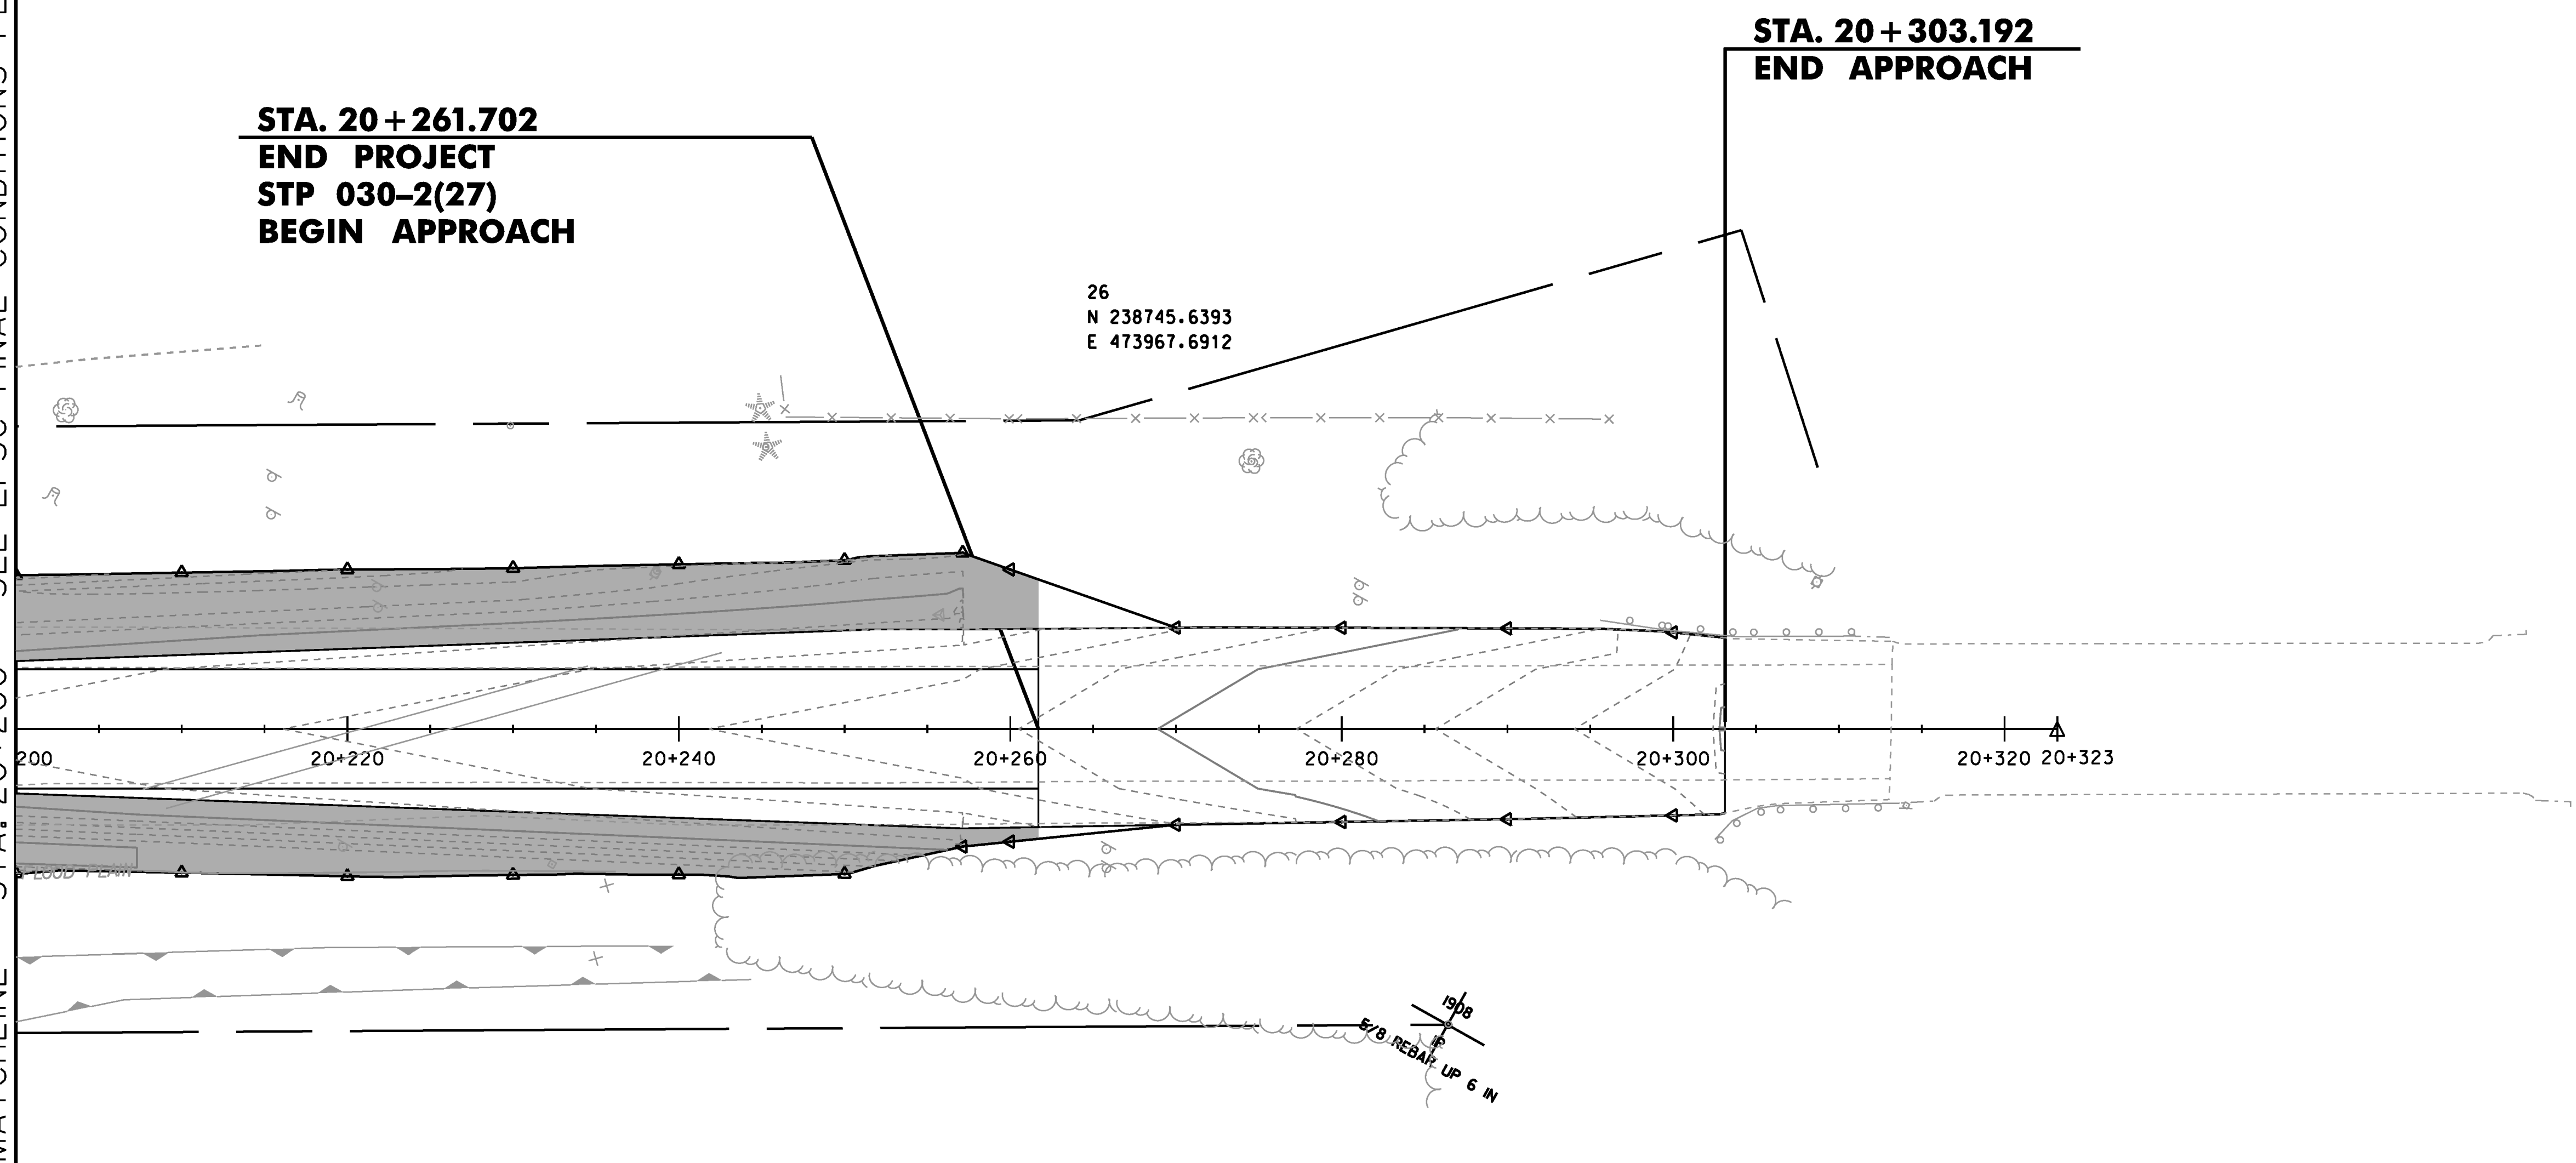

LEGEND	
	PERM. SLOPE LIMITS
	SOIL BOUNDARY TYPE
	WETLAND
	ARCHAEOLOGY
	FLOOD PLAIN
	STONE FILL, TYPE I
	STONE FILL, TYPE IV
	TURF ESTABLISHED AREAS

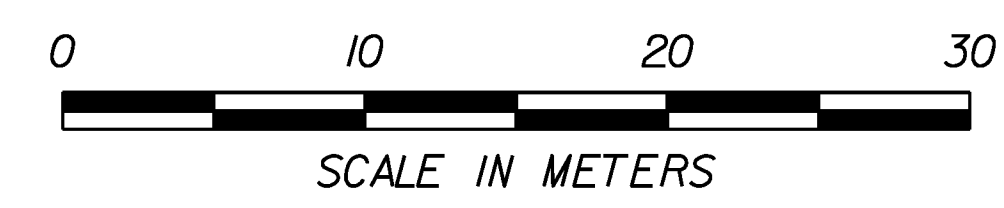

PROJECT NAME: CAMBRIDGE	PLOT DATE: 05-JUN-2012
PROJECT NUMBER: STP 030-2(27)	DRAWN BY: MBL
FILE NAME: +78f163bdr.dgn	CHECKED BY: JAD
PROJECT LEADER: JLS	SHEET 26 OF 214
DESIGNED BY: MBL	
EPSC FINAL CONDITIONS PLAN 3	