

MATERIAL TOLERANCES

MATERIAL ITEM	THICKNESS TOLERANCE (TOTAL DEPTH FOR EACH MATERIAL)
PAVEMENT	± 5
SUBBASE	± 30
SAND BORROW	± 30

TYPICAL SECTIONS

SEEDING FORMULA

SEE EROSION CONTROL DETAIL SHEET 1 FOR THE SEEDING FORMULA.



GENERAL NOTES

1. TACK COAT: EMULSIFIED ASPHALT IS TO BE APPLIED AT THE RATE OF 0.025 GAL/SY BETWEEN SUCCESSIVE COURSES OF PAVEMENT AS DIRECTED BY THE ENGINEER.
2. MARKER POSTS: TO BE PLACED AS INDICATED OR AS DIRECTED BY THE ENGINEER.
3. SLOPE ROUNDING: ALL CUT SLOPES TO BE ROUNDED IN ACCORDANCE WITH STANDARD B-5.
4. ALL MATERIALS AND CONSTRUCTION PRACTICES SHALL CONFORM TO THE STATE OF VERMONT AGENCY OF TRANSPORTATION'S 2011 STANDARD SPECIFICATIONS FOR CONSTRUCTION AND ITS LATEST REVISIONS.





VT ROUTE 15 & VT ROUTE 108

40 BITUMINOUS CONCRETE PAVEMENT (TYPE IVS)
 80 BITUMINOUS CONCRETE PAVEMENT (TYPE IIS)
 80 BITUMINOUS CONCRETE PAVEMENT (TYPE IIS)
 600 SUBBASE OF DENSE GRADED CRUSHED STONE
 450 SAND BORROW

VT ROUTE 108


~~40 BITUMINOUS CONCRETE PAVEMENT (TYPE IVS)~~
~~65 BITUMINOUS CONCRETE PAVEMENT (TYPE IS)~~
 550 SUBBASE OF DENSE GRADED CRUSHED STONE
~~600 SAND BORROW~~

SEE W.O. #39
 80MM TYPE IIS
 80MM TYPE IIS
 40MM TYPE IVS

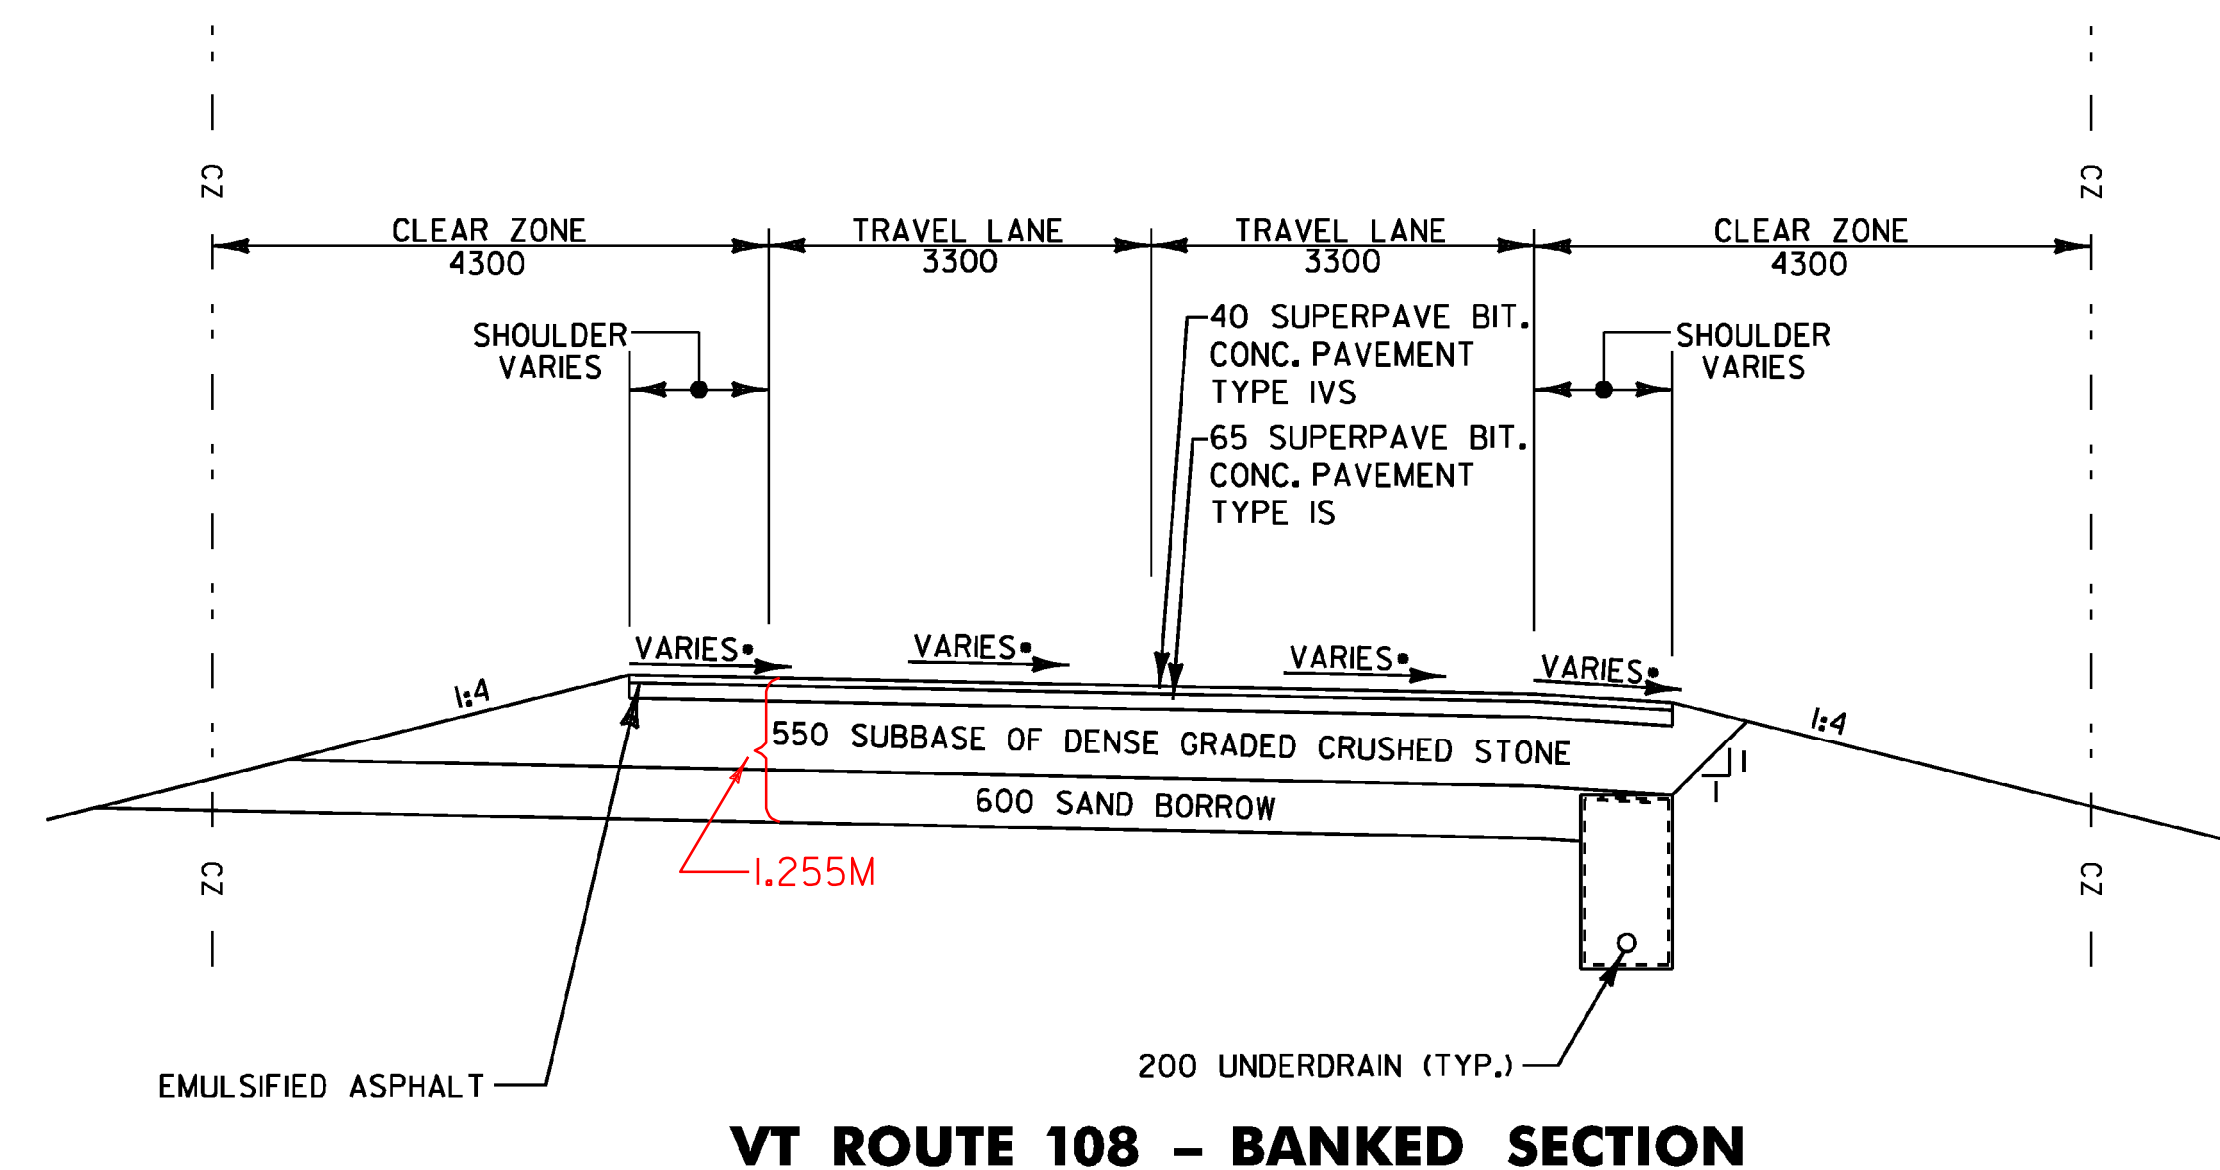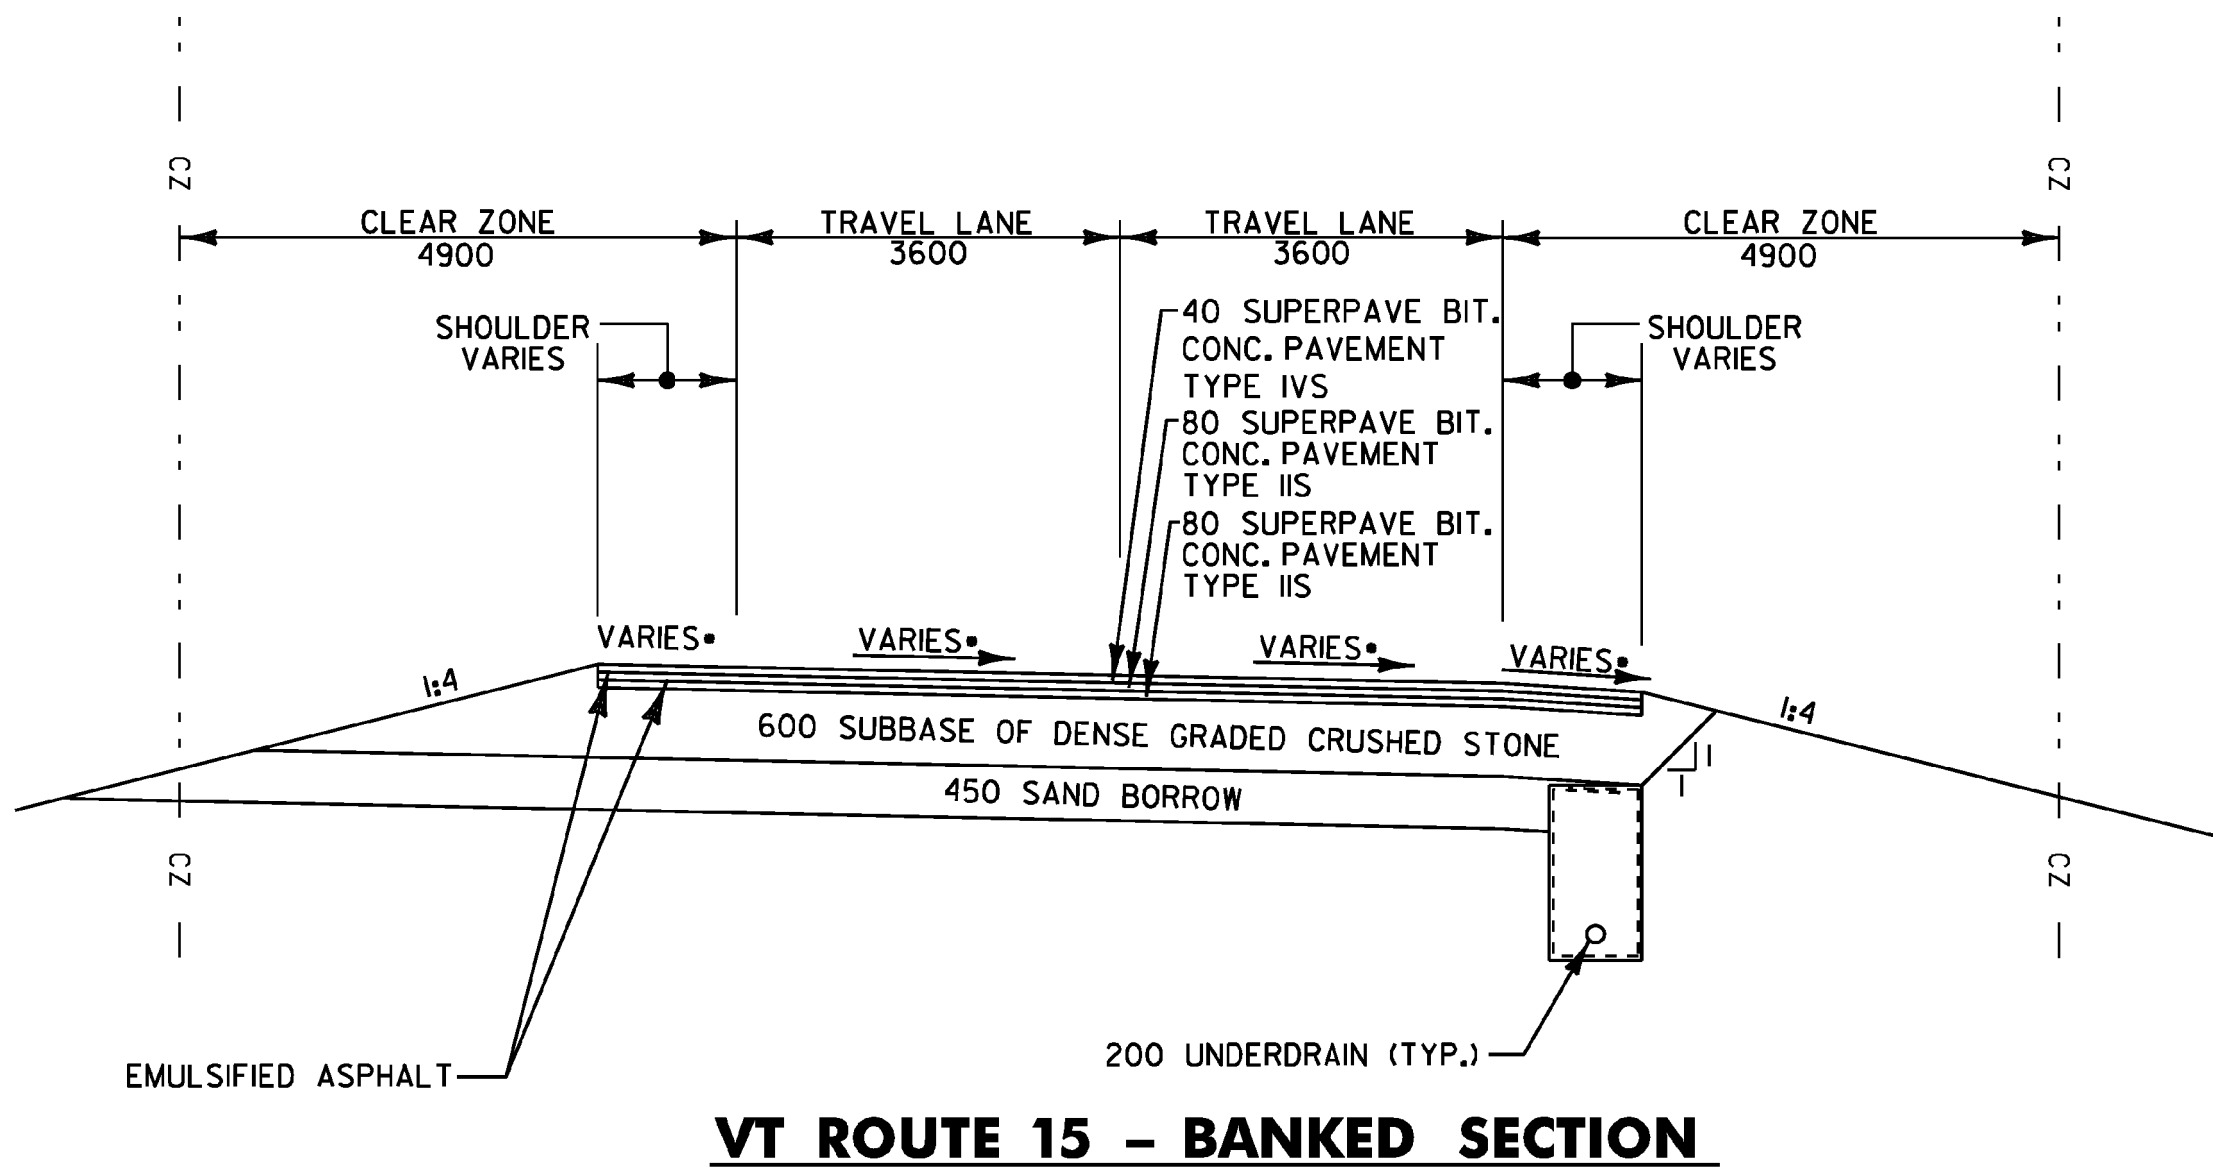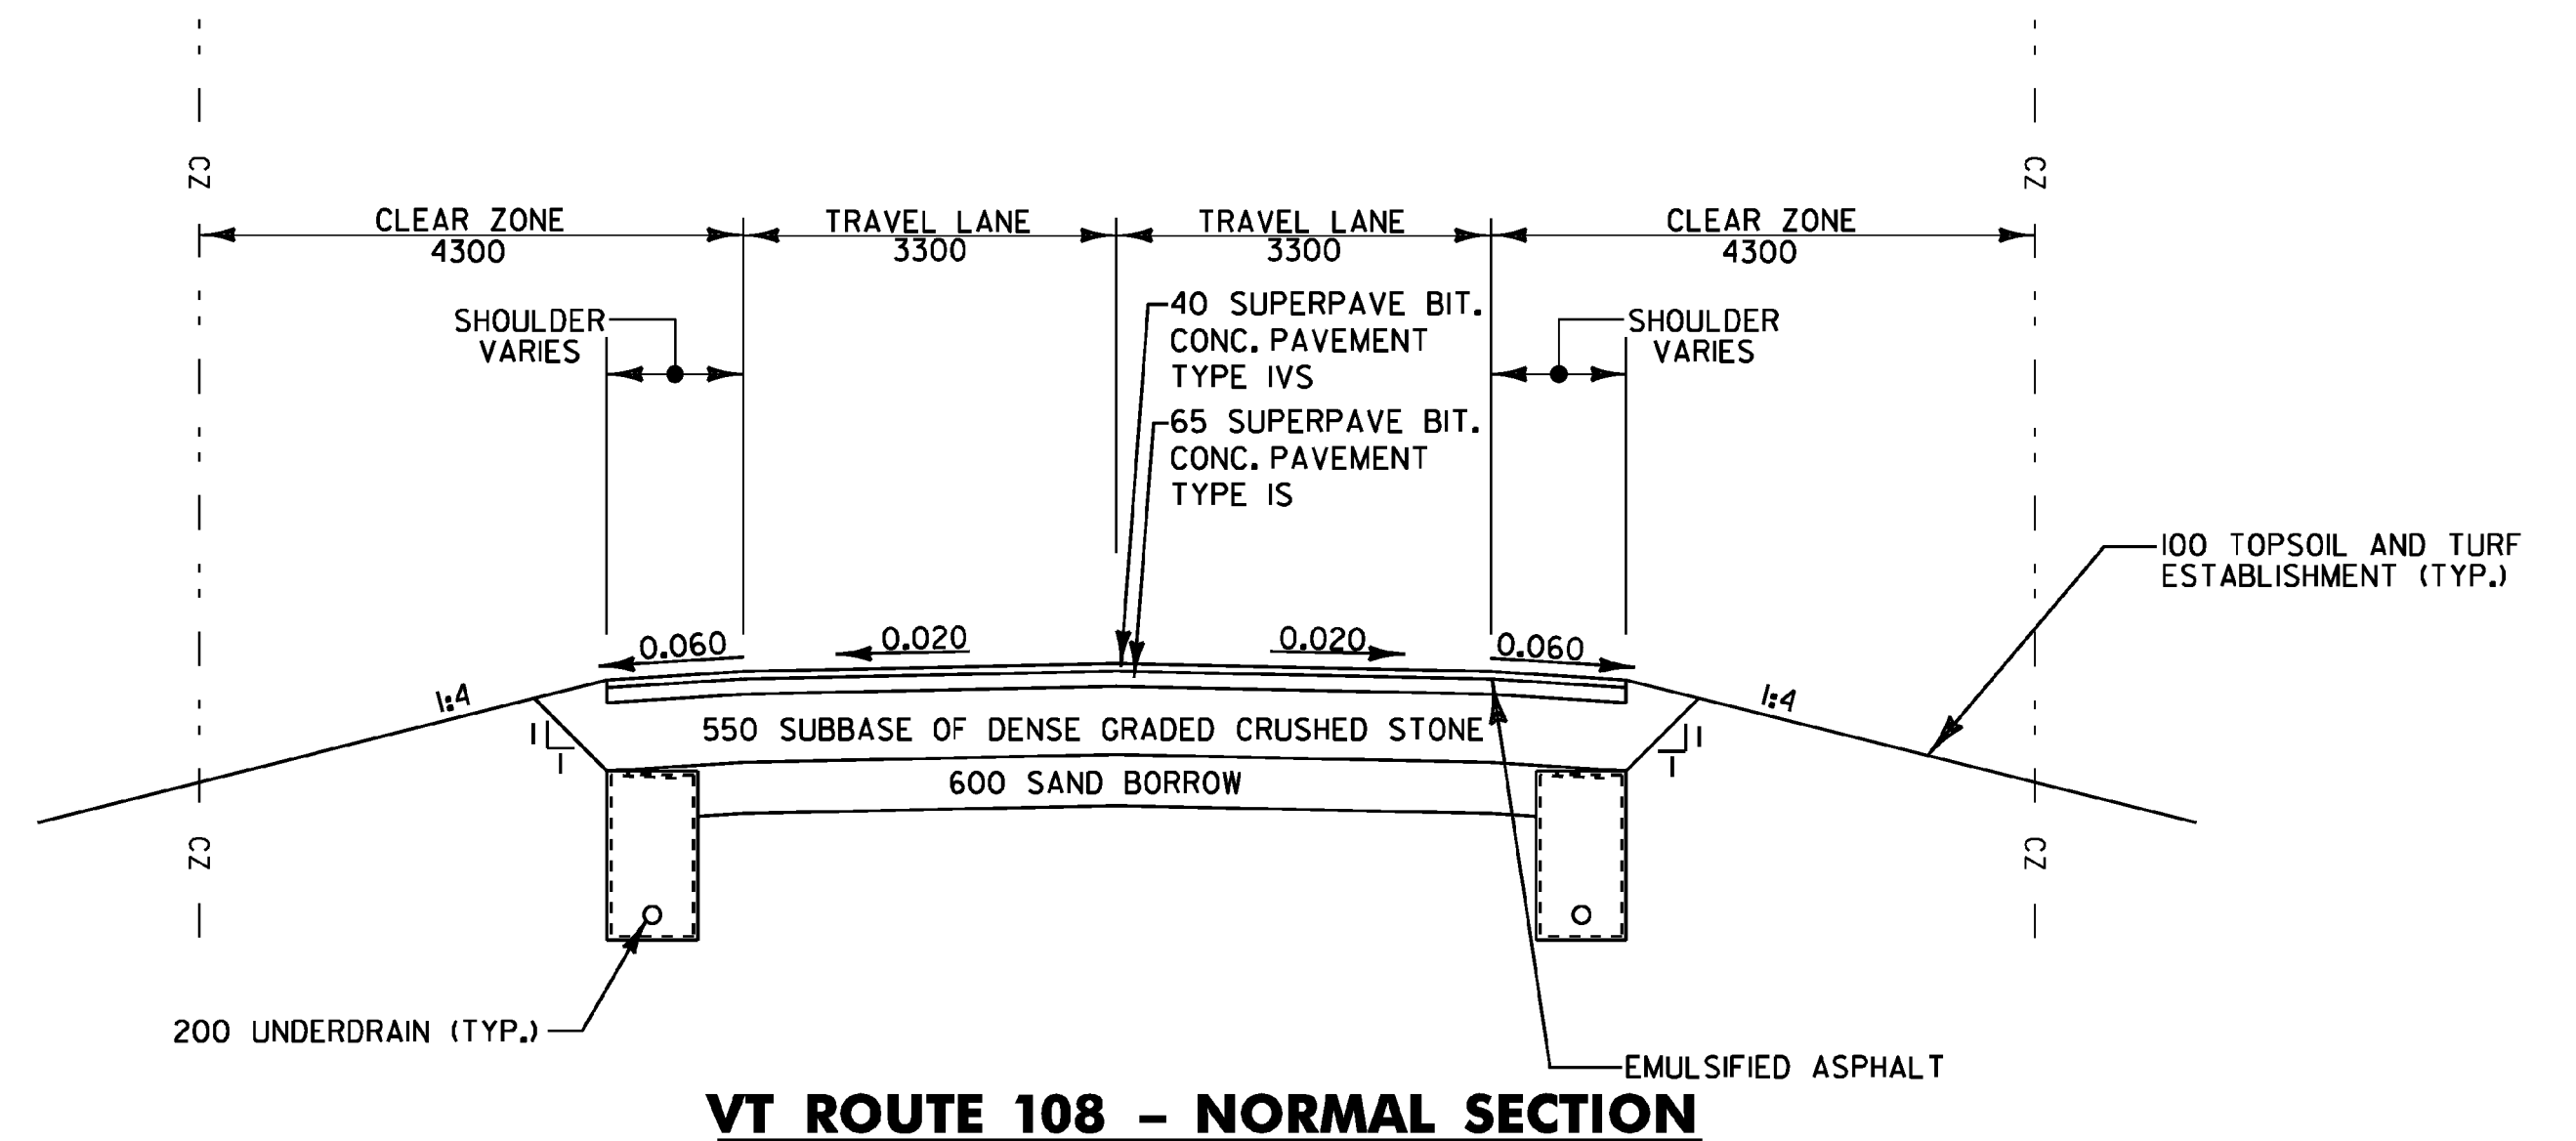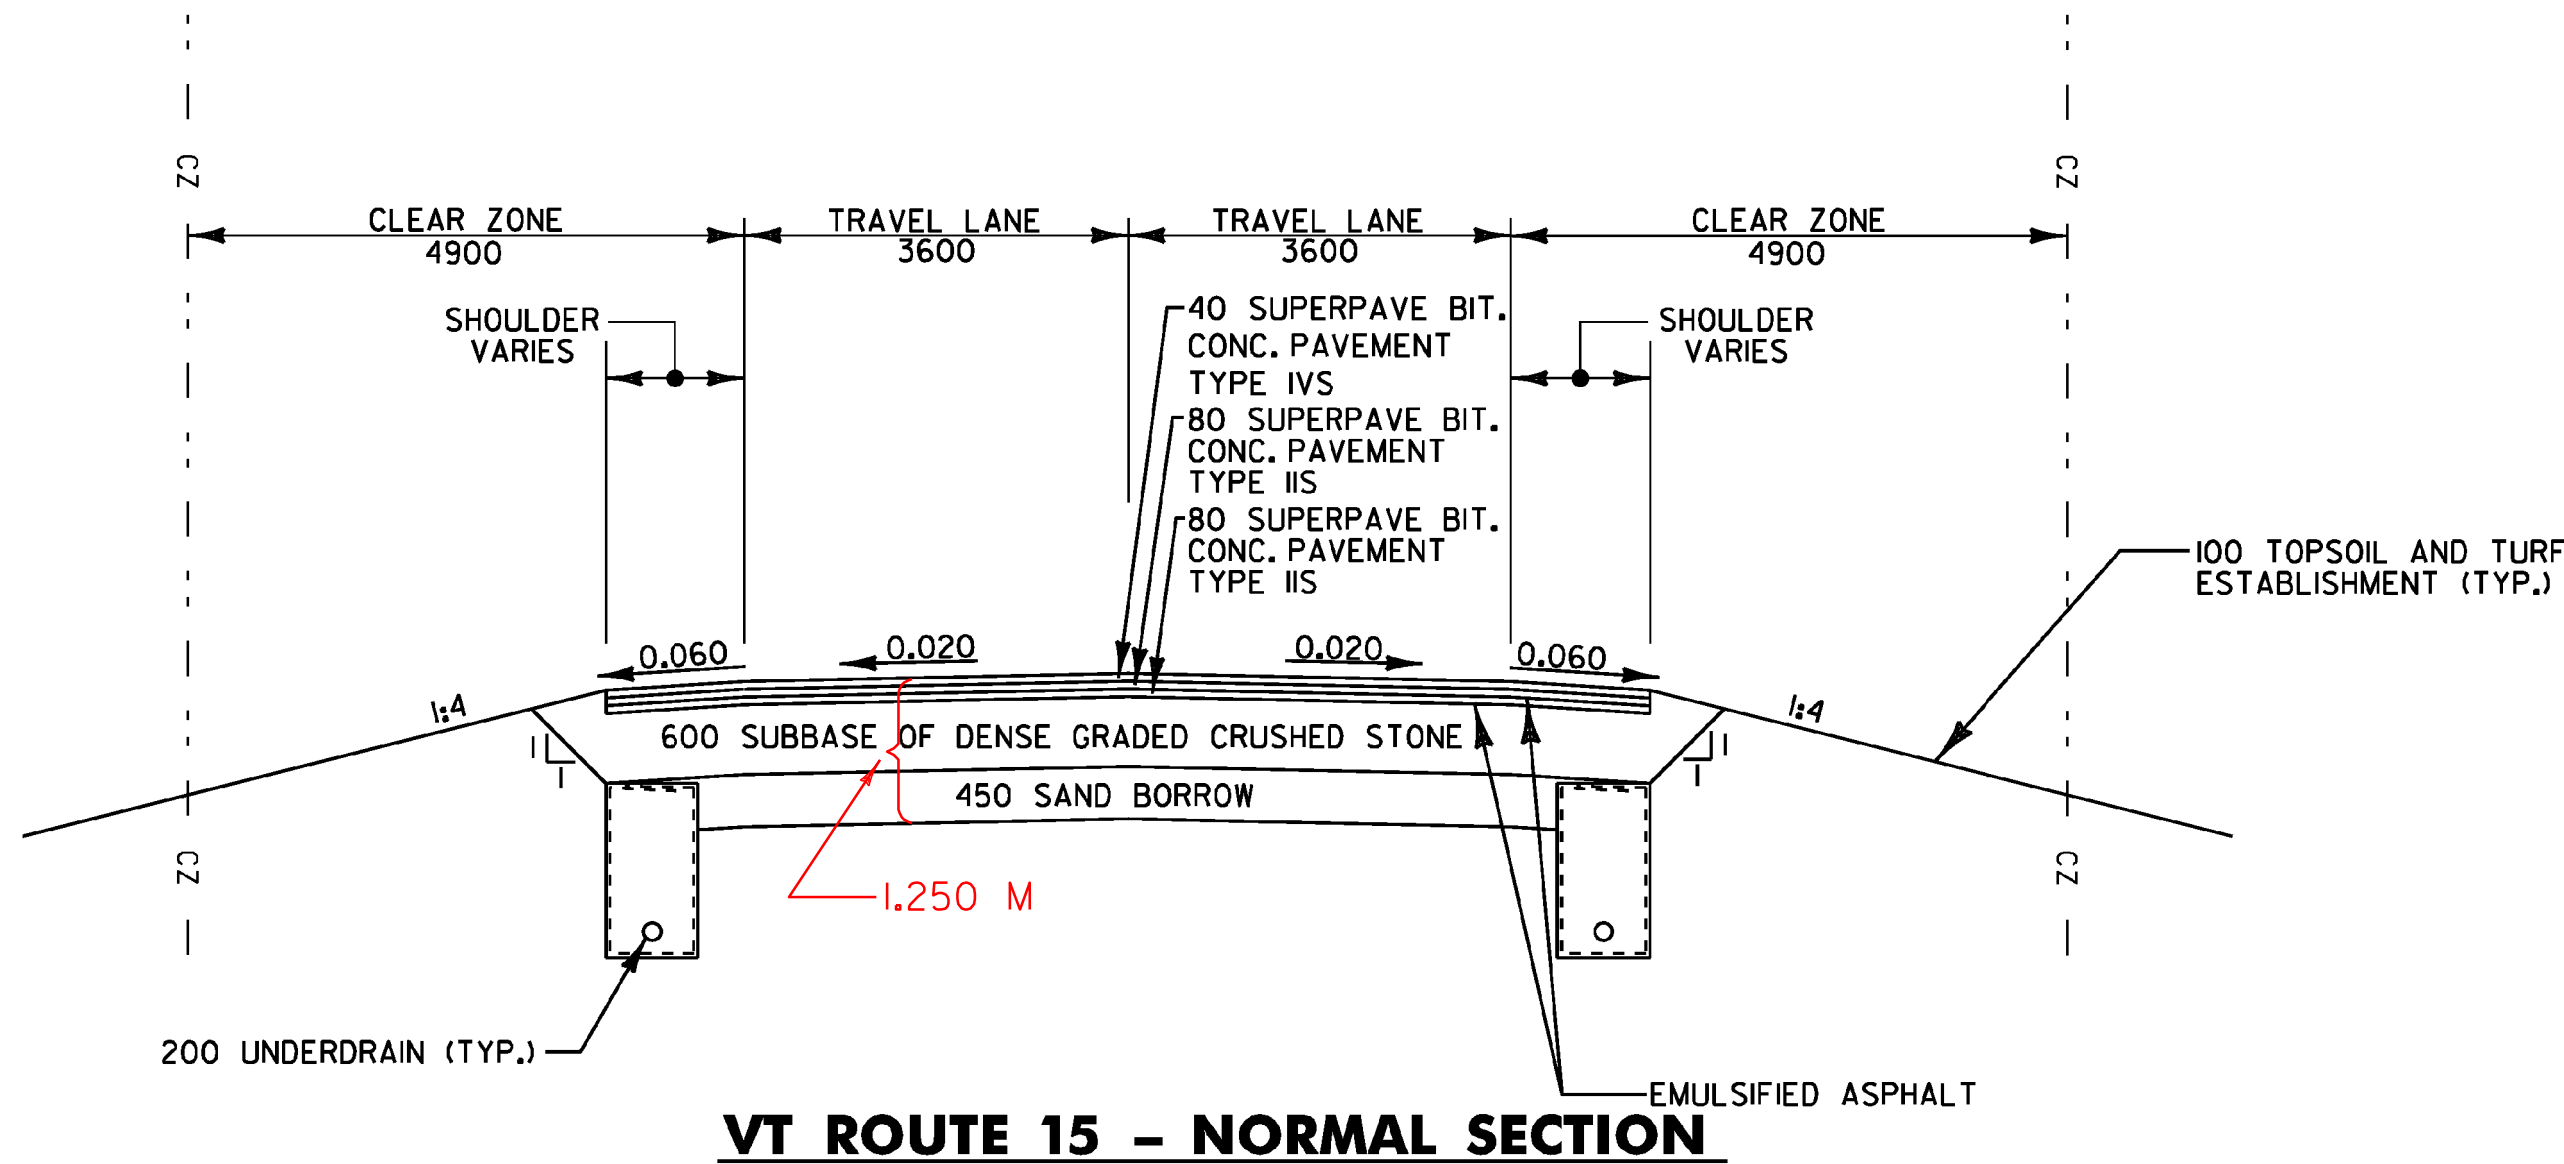

• SEE PROFILE SHEETS 1 & 2 FOR BANKING DIAGRAMS, SHEETS 48 & 49.

• SEE PROFILE SHEETS 3 & 4 FOR BANKING DIAGRAMS, SHEETS 50 & 51.

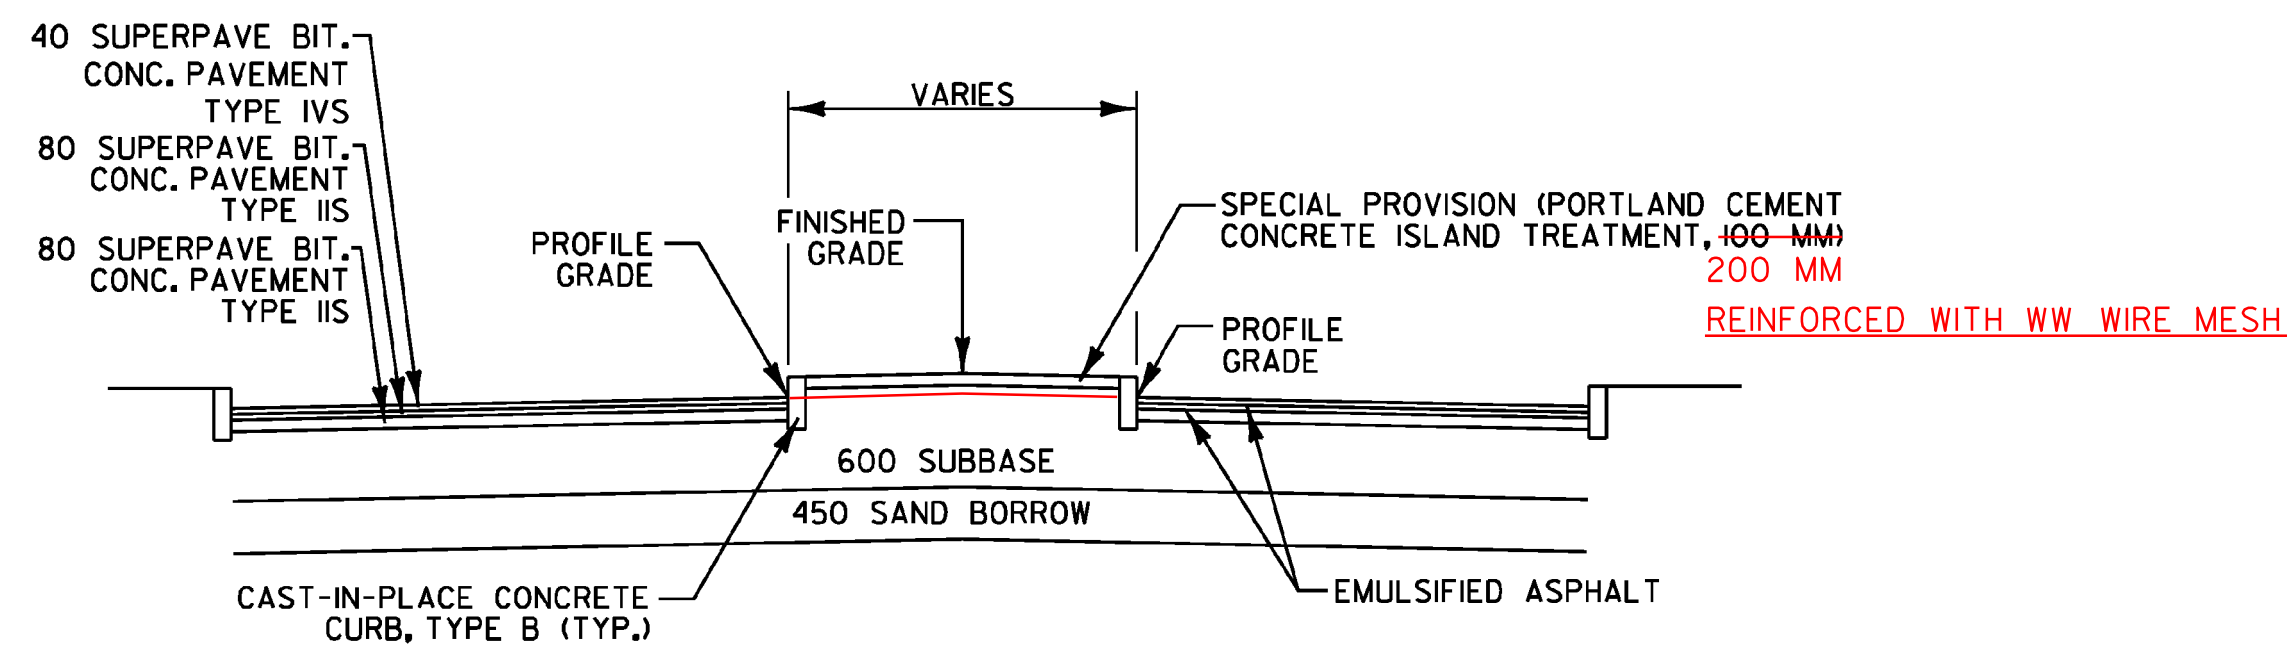

SPLITTER ISLAND DETAIL

ALL DIMENSIONS IN MILLIMETERS, EXCEPT WHERE NOTED.

NOT TO SCALE

PROJECT NAME:	CAMBRIDGE
PROJECT NUMBER:	STP 030-2(27)
FILE NAME:	t78f163frm.dgn
PROJECT LEADER:	JLS
DESIGNED BY:	MBL
TYPICAL SECTIONS SHEET 1	
PLOT DATE:	05-JUN-2012
DRAWN BY:	MBL
CHECKED BY:	JAD
SHEET	39 OF 214