

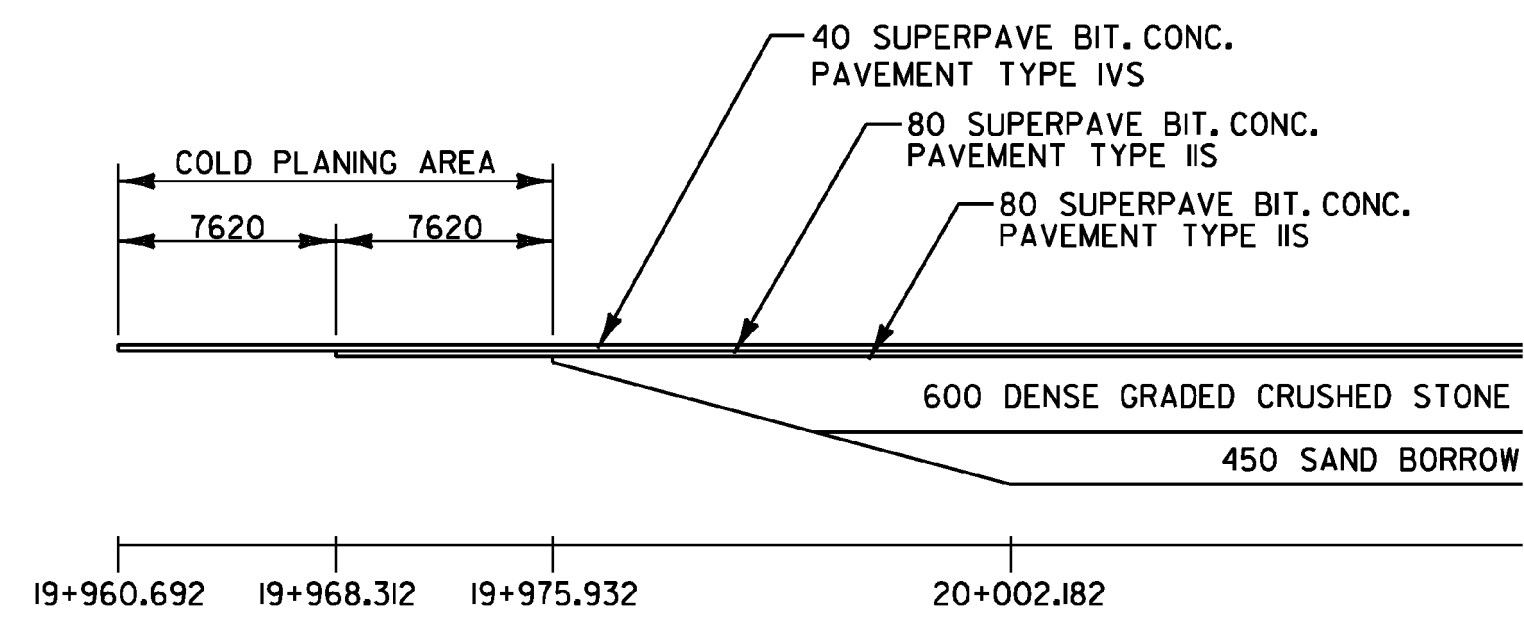


# TYPICAL SECTIONS



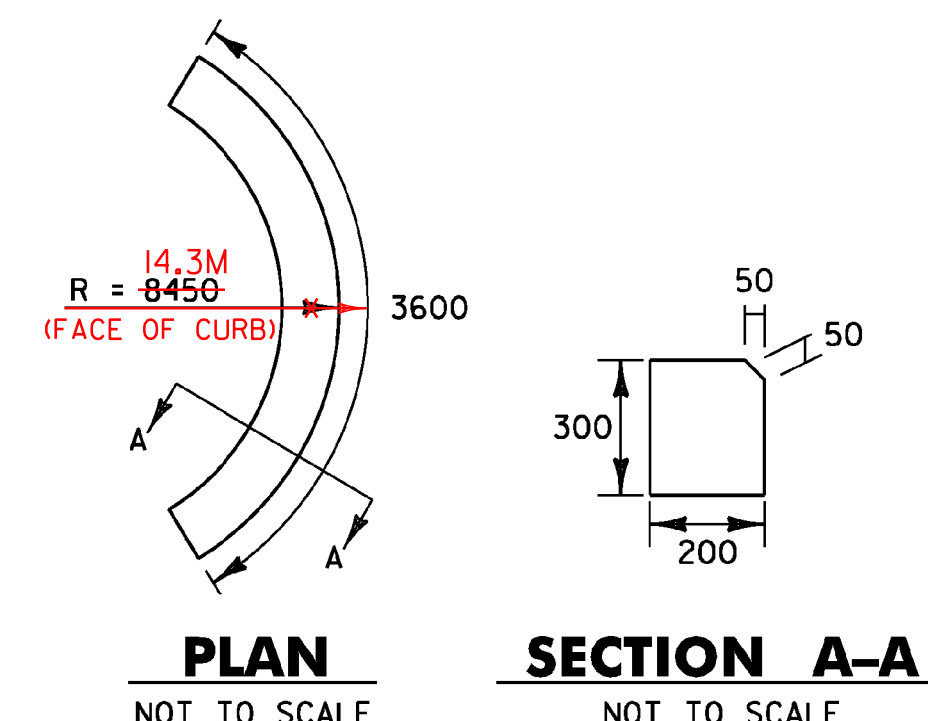


**VT ROUTE 15**  
 40 BITUMINOUS CONCRETE PAVEMENT (TYPE IVS)  
 80 BITUMINOUS CONCRETE PAVEMENT (TYPE IIS)  
 80 BITUMINOUS CONCRETE PAVEMENT (TYPE IIS)  
 600 SUBBASE OF DENSE GRADED CRUSHED STONE  
 450 SAND BORROW



**VT ROUTE 108**  
 40 BITUMINOUS CONCRETE PAVEMENT (TYPE IVS)  
 65 BITUMINOUS CONCRETE PAVEMENT (TYPE IS)  
 550 SUBBASE OF DENSE GRADED CRUSHED STONE  
 600 SAND BORROW

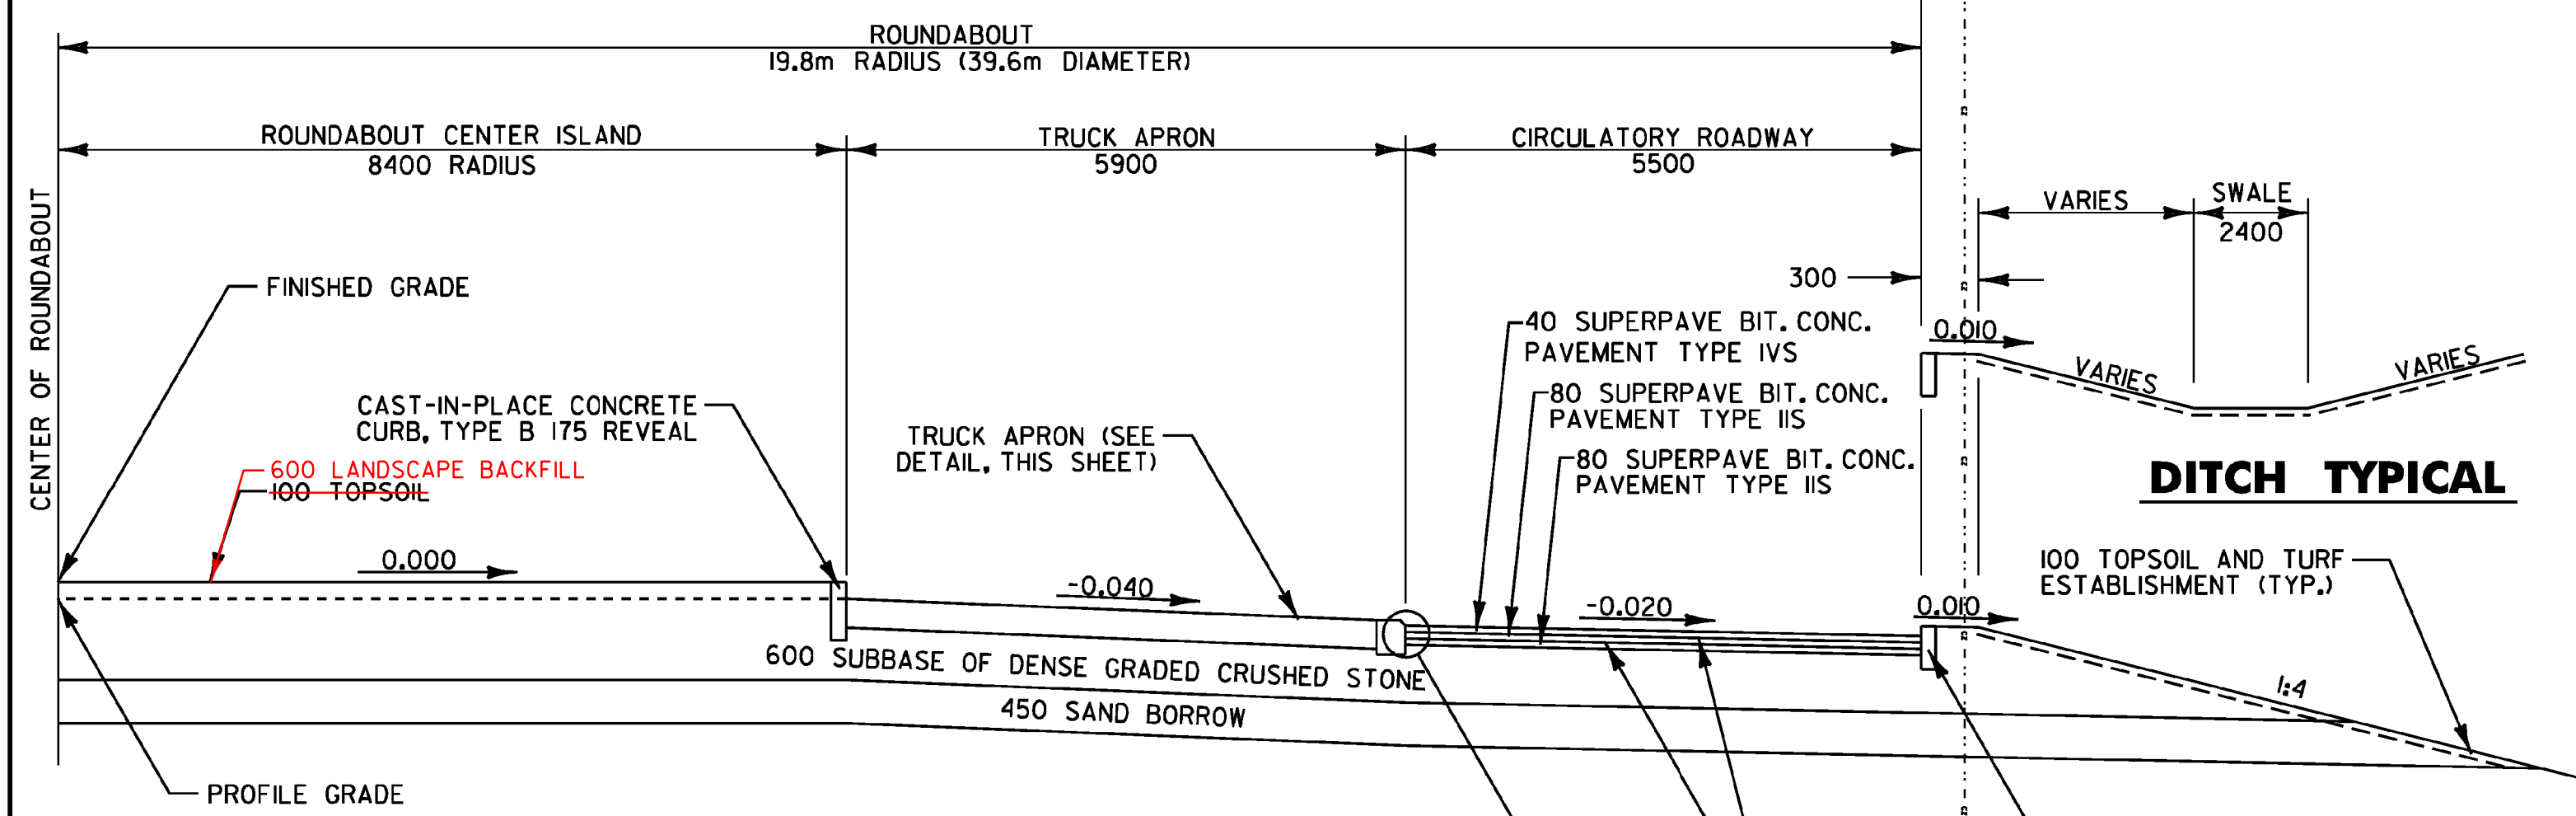

## ROUNDABOUT SECTION

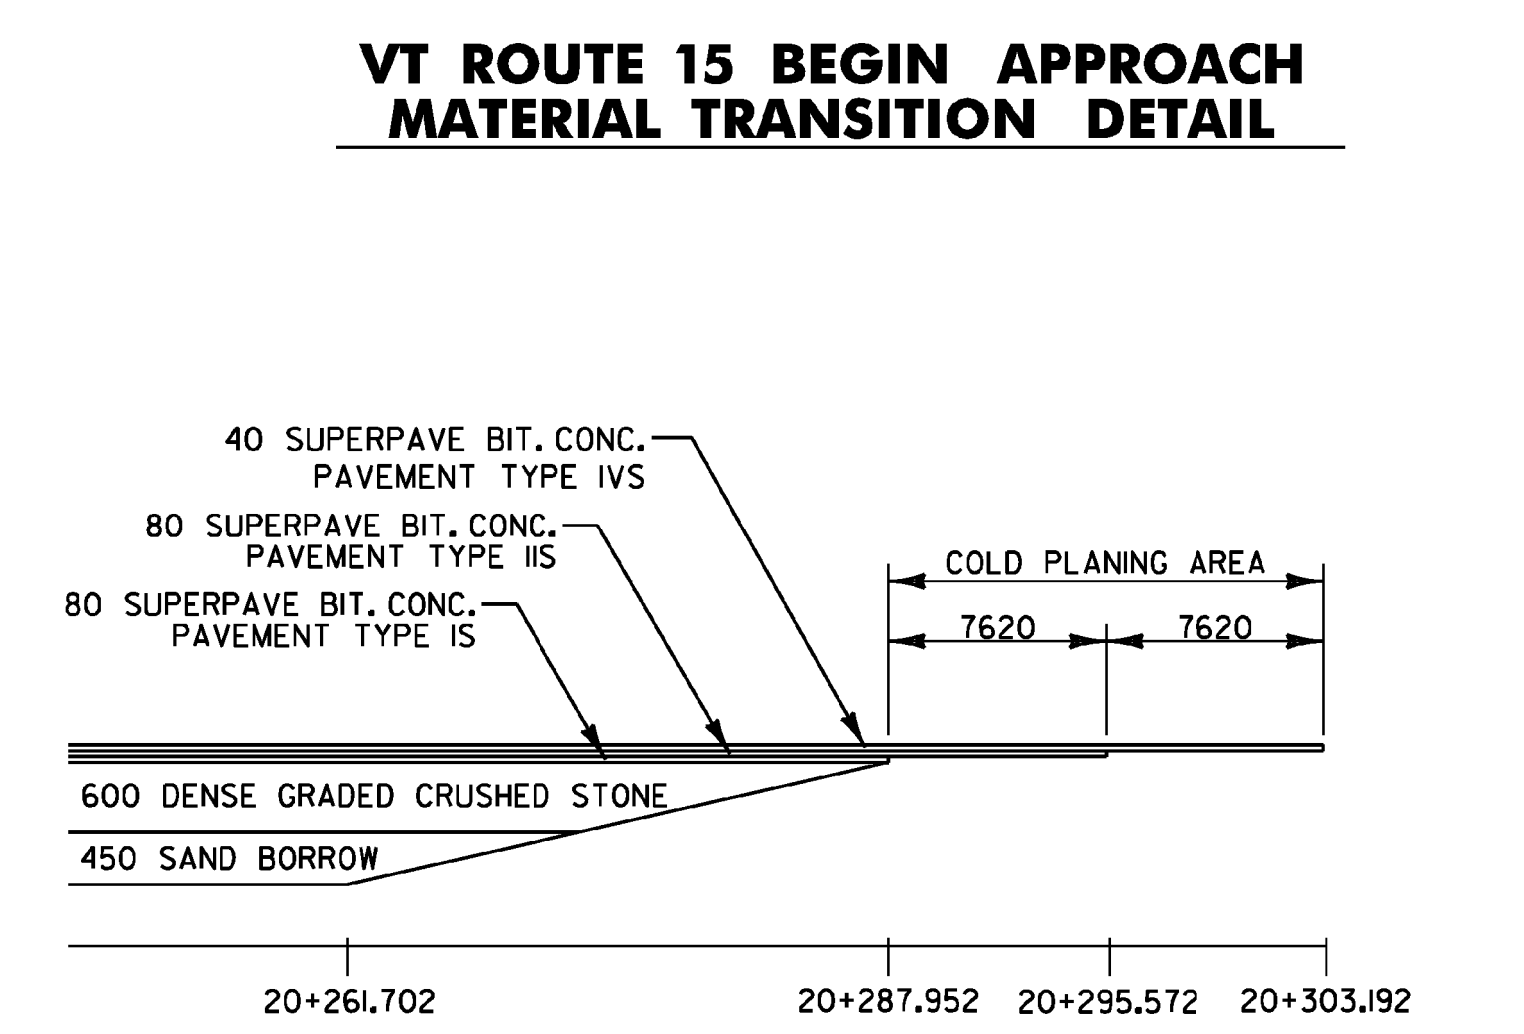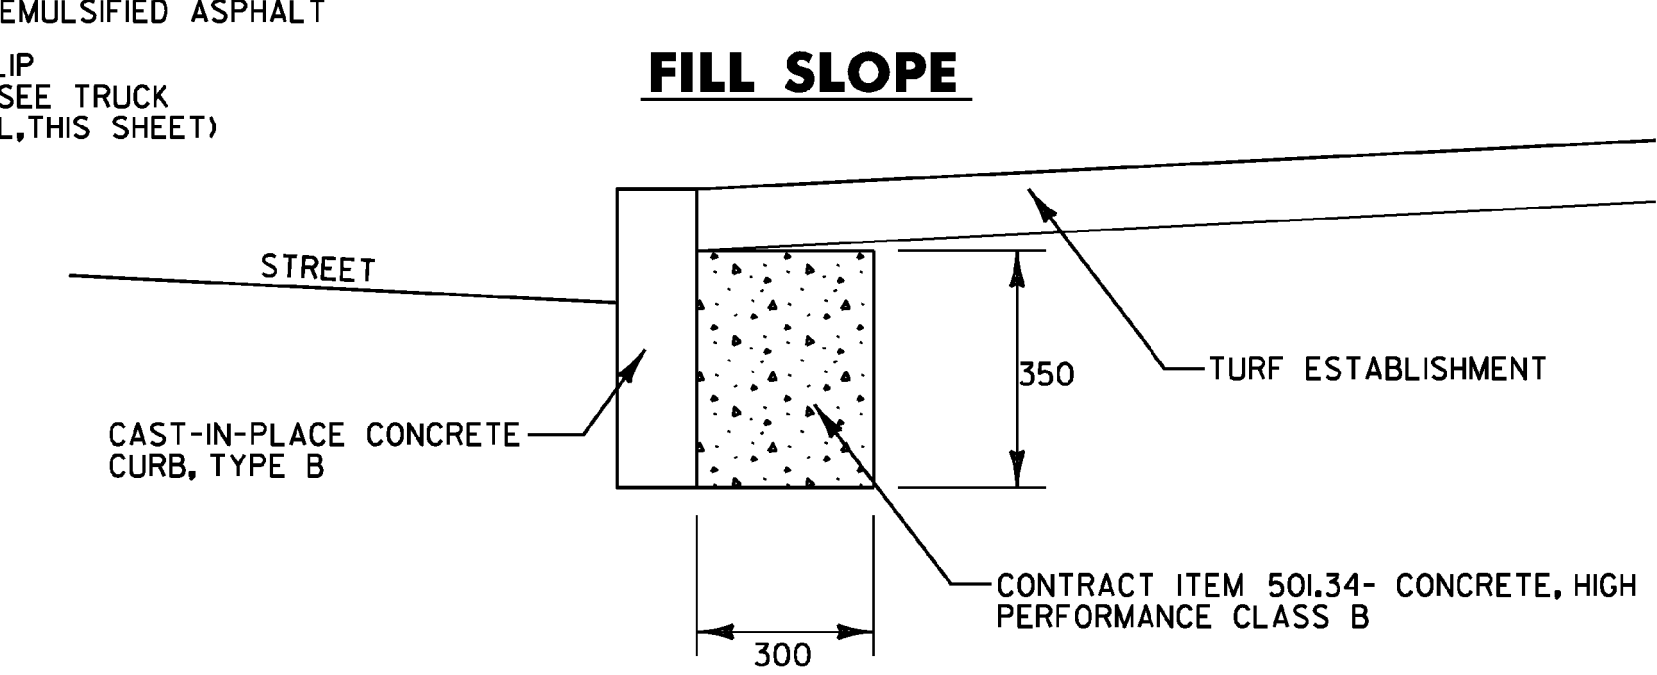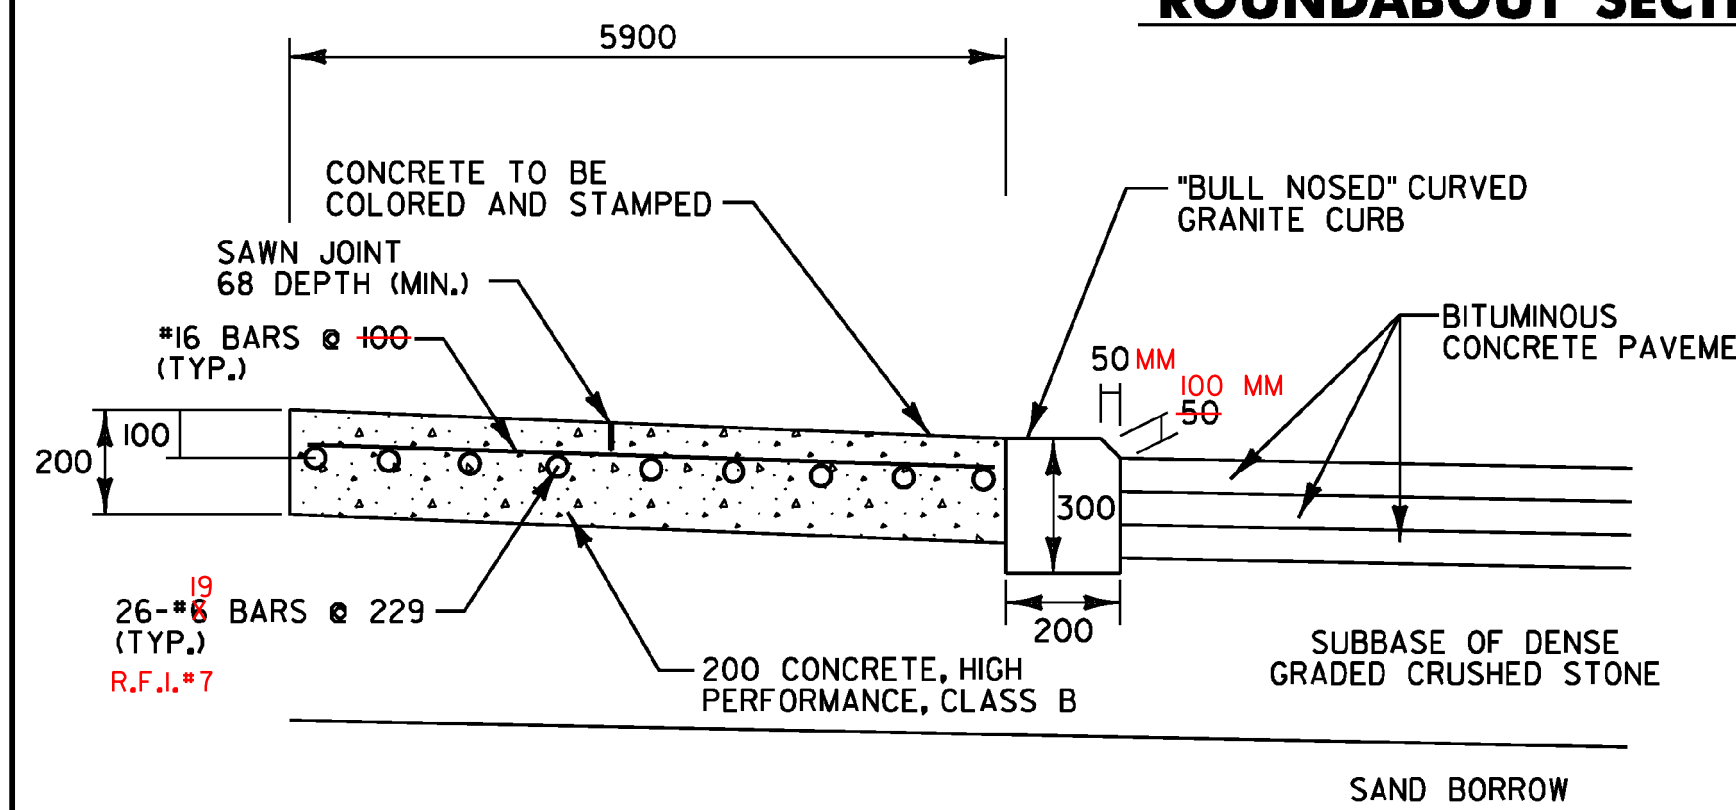


## CONCRETE BEHIND CURB ON RADII DETAIL

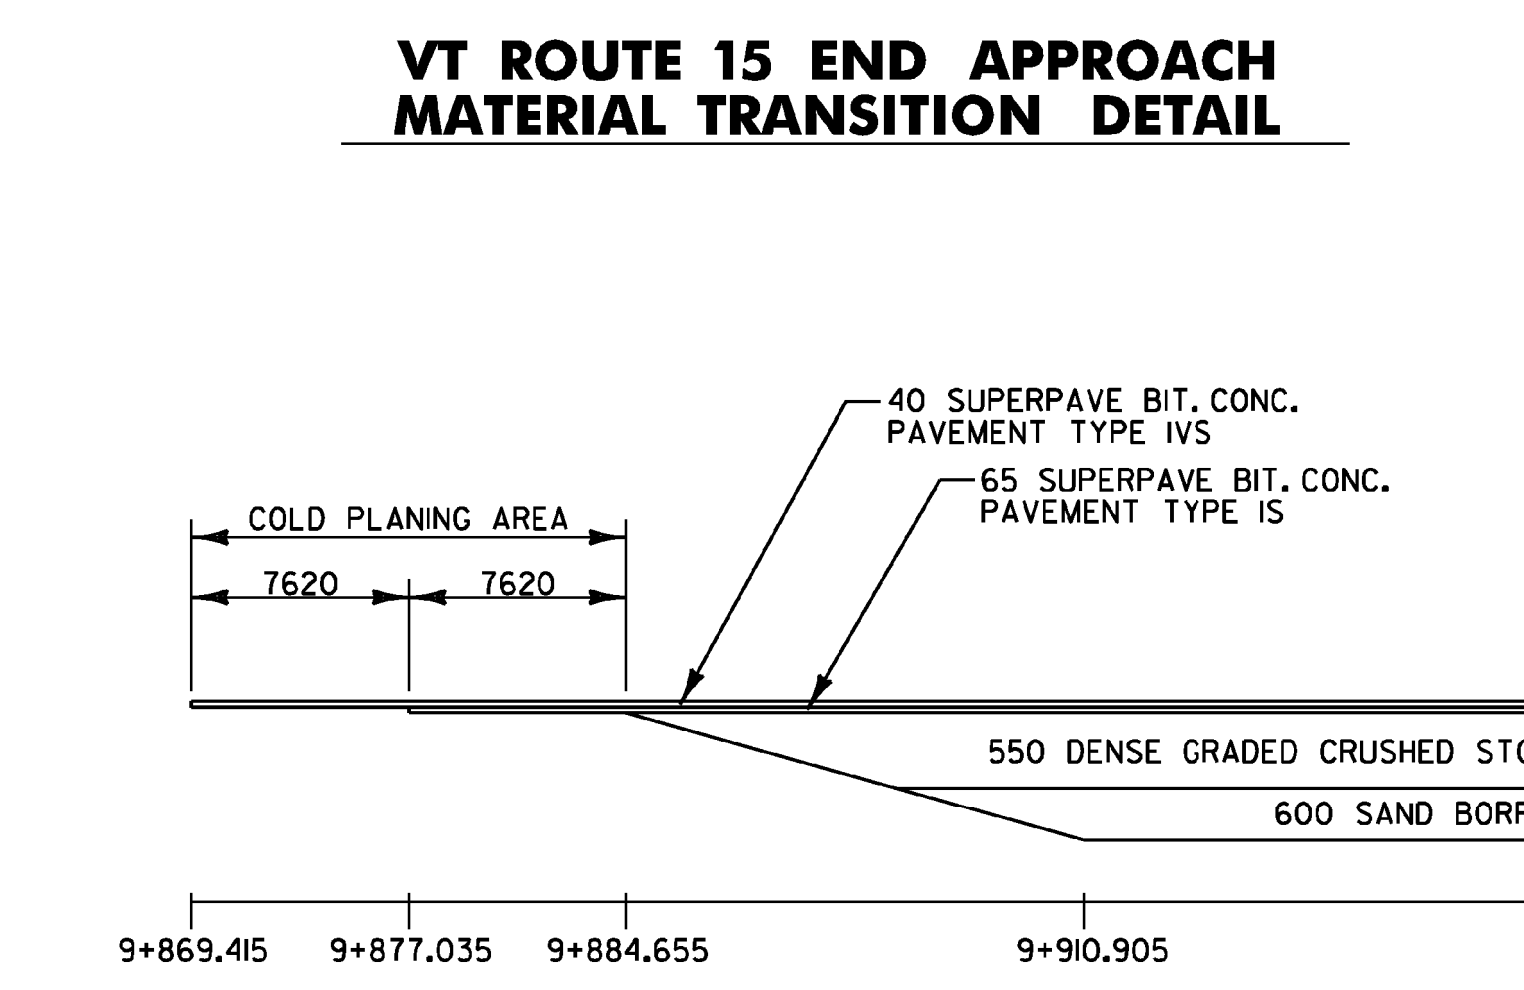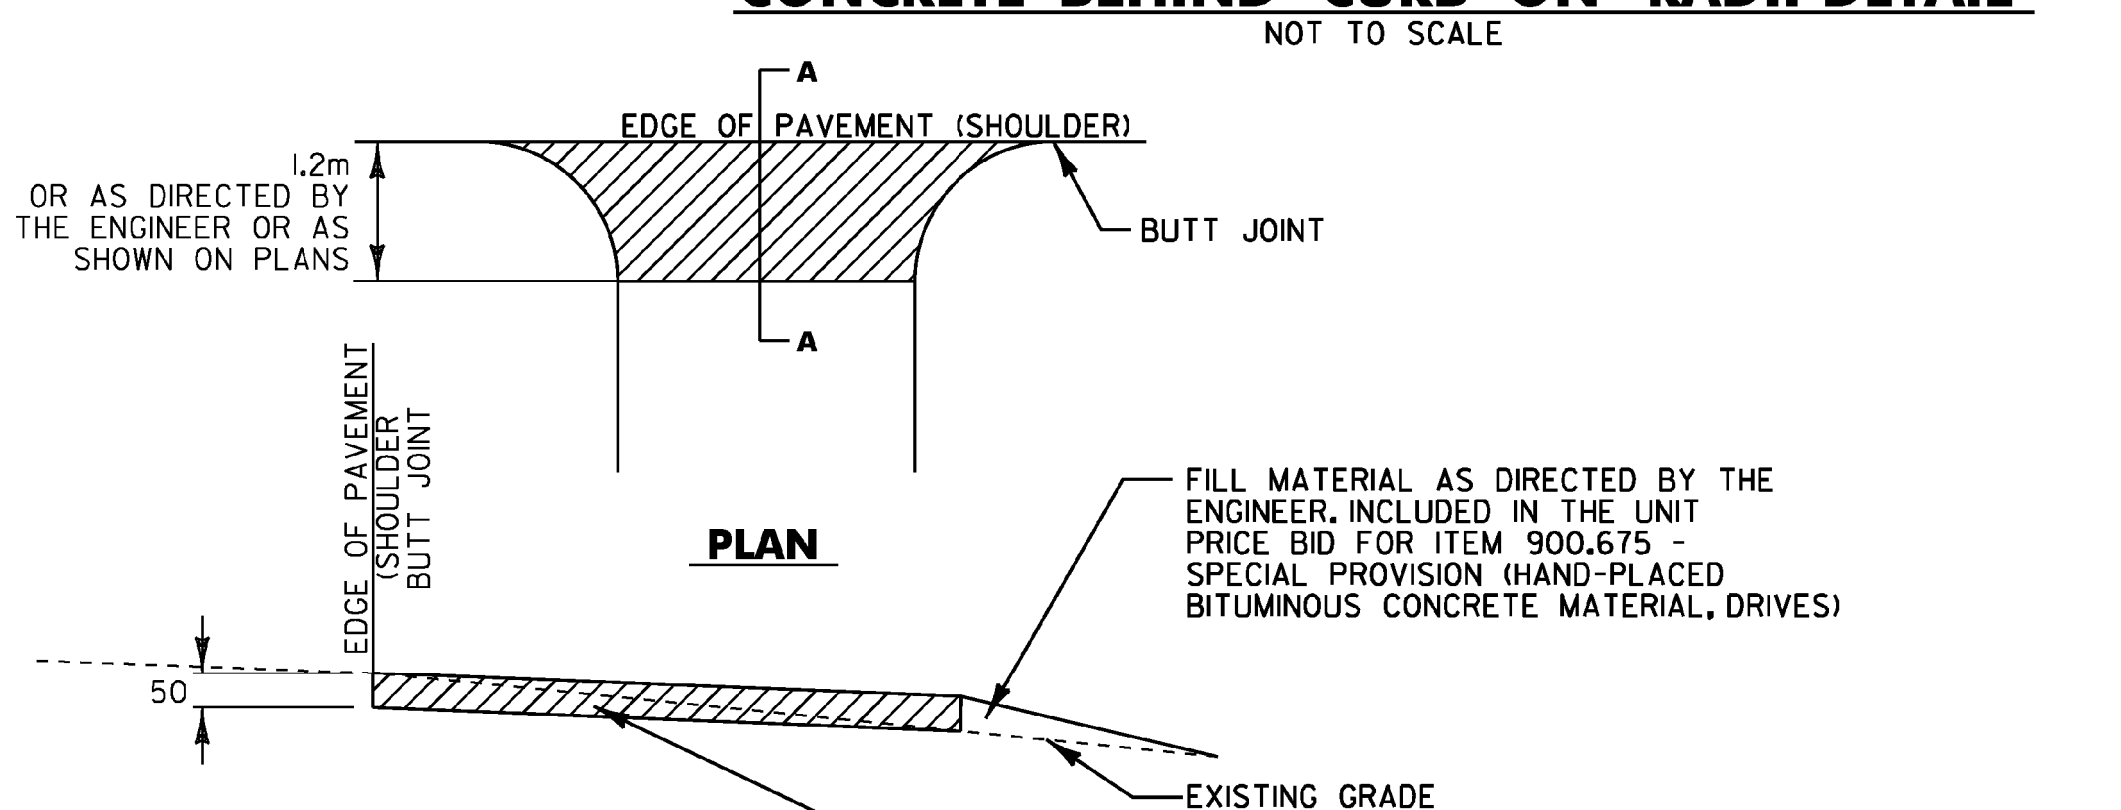

**NOTE:**  
 1. ALL REINFORCING STEEL SHALL BE EPOXY COATED AND PAID FOR UNDER CONTRACT ITEM 507.11.  
 2. THE COLOR OF THE CONCRETE AGGREGATE SHALL MATCH THAT OF THE COLORED CONCRETE.

## TRUCK APRON DETAIL

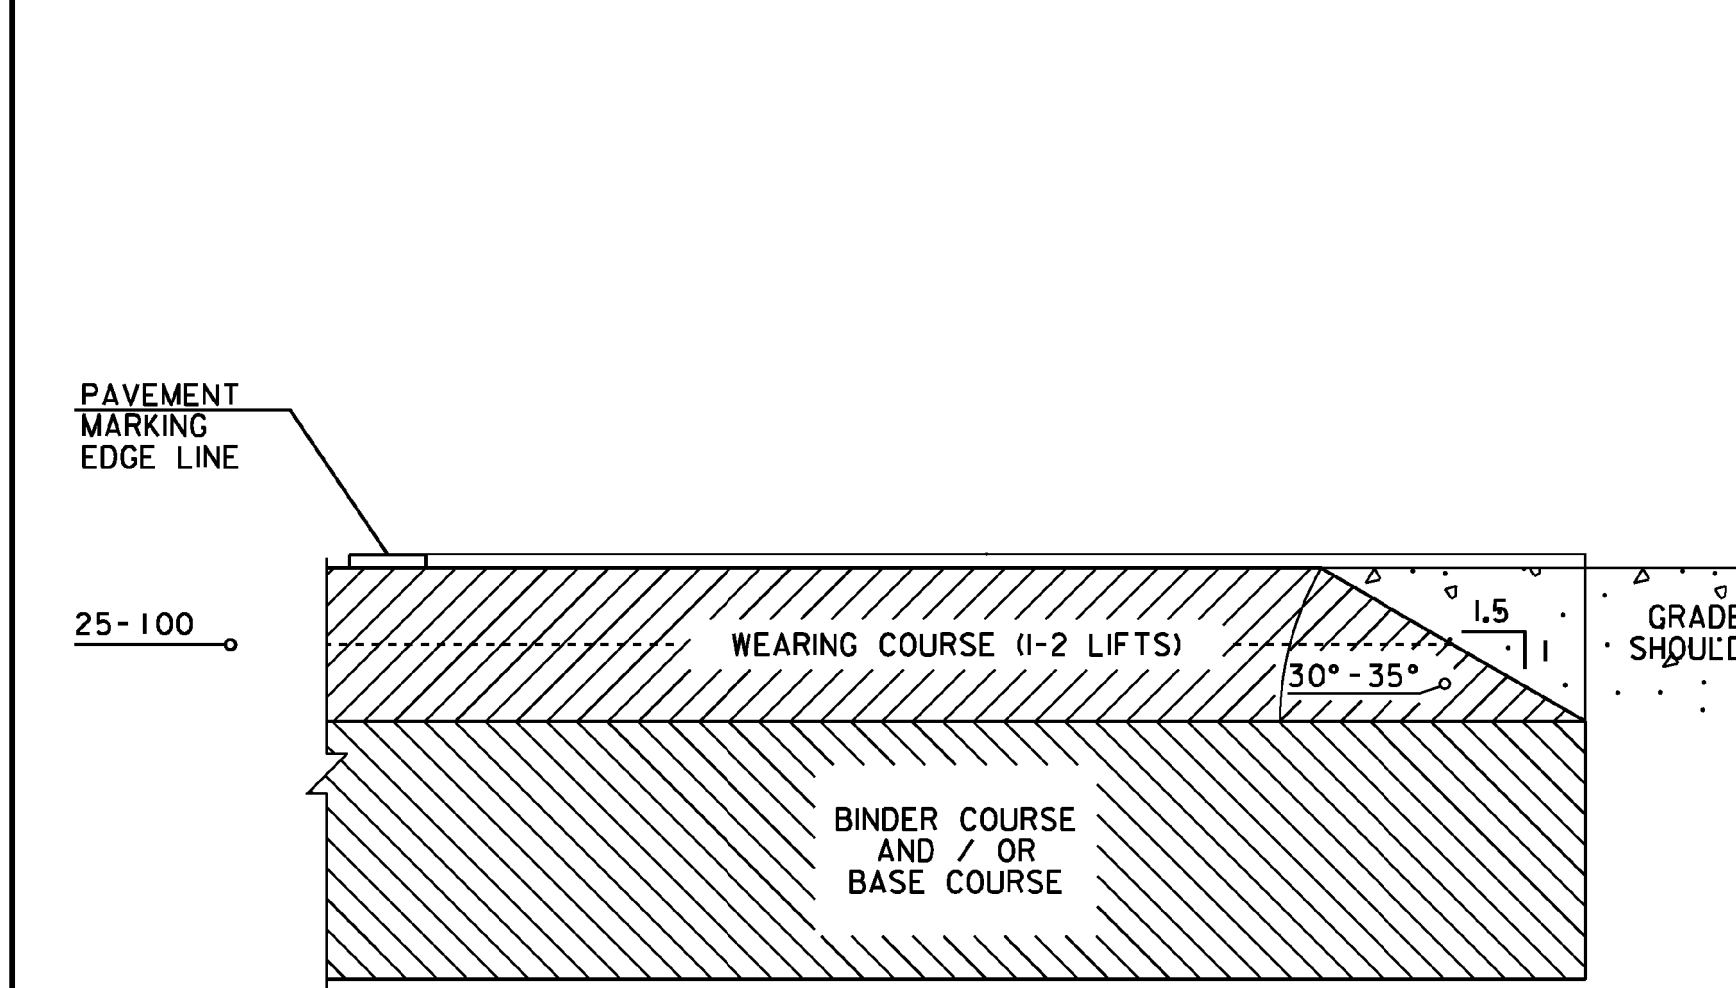

**SECTION A-A**

STATION	QUANTITY (SM)
9+934.418, L.T.	14.2 SM
9+943.594, R.T.	24.9 SM
10+055.294, L.T.	13.8 SM
20+030.517, L.T.	16.9 SM
20+073.010, L.T.	19.0 SM
20+187.354, L.T.	23.9 SM

## DRIVE LOCATION SUMMARY

AREAS FOR 900.675 - SPECIAL PROVISION (HAND-PLACED BIT. CONC. MATERIAL, DRIVES)

**ITEM NO. 900.675 - SPECIAL PROVISION (HAND-PLACED BITUMINOUS CONCRETE MATERIAL, DRIVES)**

**NOTES:**  
 1. CONCRETE FOR THE SPLITTER ISLANDS SHALL BE PAID FOR UNDER ITEM NO. 900.675 - SPECIAL PROVISION (PORTLAND CEMENT CONCRETE ISLAND TREATMENT, 100 MM).  
 2. CONCRETE FOR THE TRUCK APRON SHALL BE PAID FOR UNDER ITEM NO. 900.675 - SPECIAL PROVISION (STAMPED COLORED CONCRETE APRON, 200 MM).

## SAFETY EDGE DETAIL

**SAFETY EDGE NOTE:**  
 1. LEVELING COURSE MAY INCLUDE THE "SAFETY EDGE" AT THE CONTRACTOR'S CHOICE.

ALL DIMENSIONS IN MILLIMETERS, EXCEPT WHERE NOTED.

PROJECT NAME: CAMBRIDGE  
 PROJECT NUMBER: STP 030-2(27)  
 FILE NAME: t78f163frm.dgn  
 PROJECT LEADER: JLS  
 DESIGNED BY: MBL  
 TYPICAL SECTION SHEET 2

PLOT DATE: 07-JUN-2012  
 DRAWN BY: MBL  
 CHECKED BY: JAD  
 SHEET 40 OF 214