
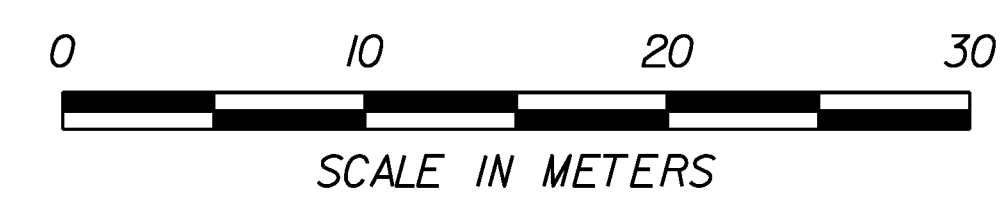


MATCHLINE - STA. 20+200 - SEE LAYOUT PLAN 2

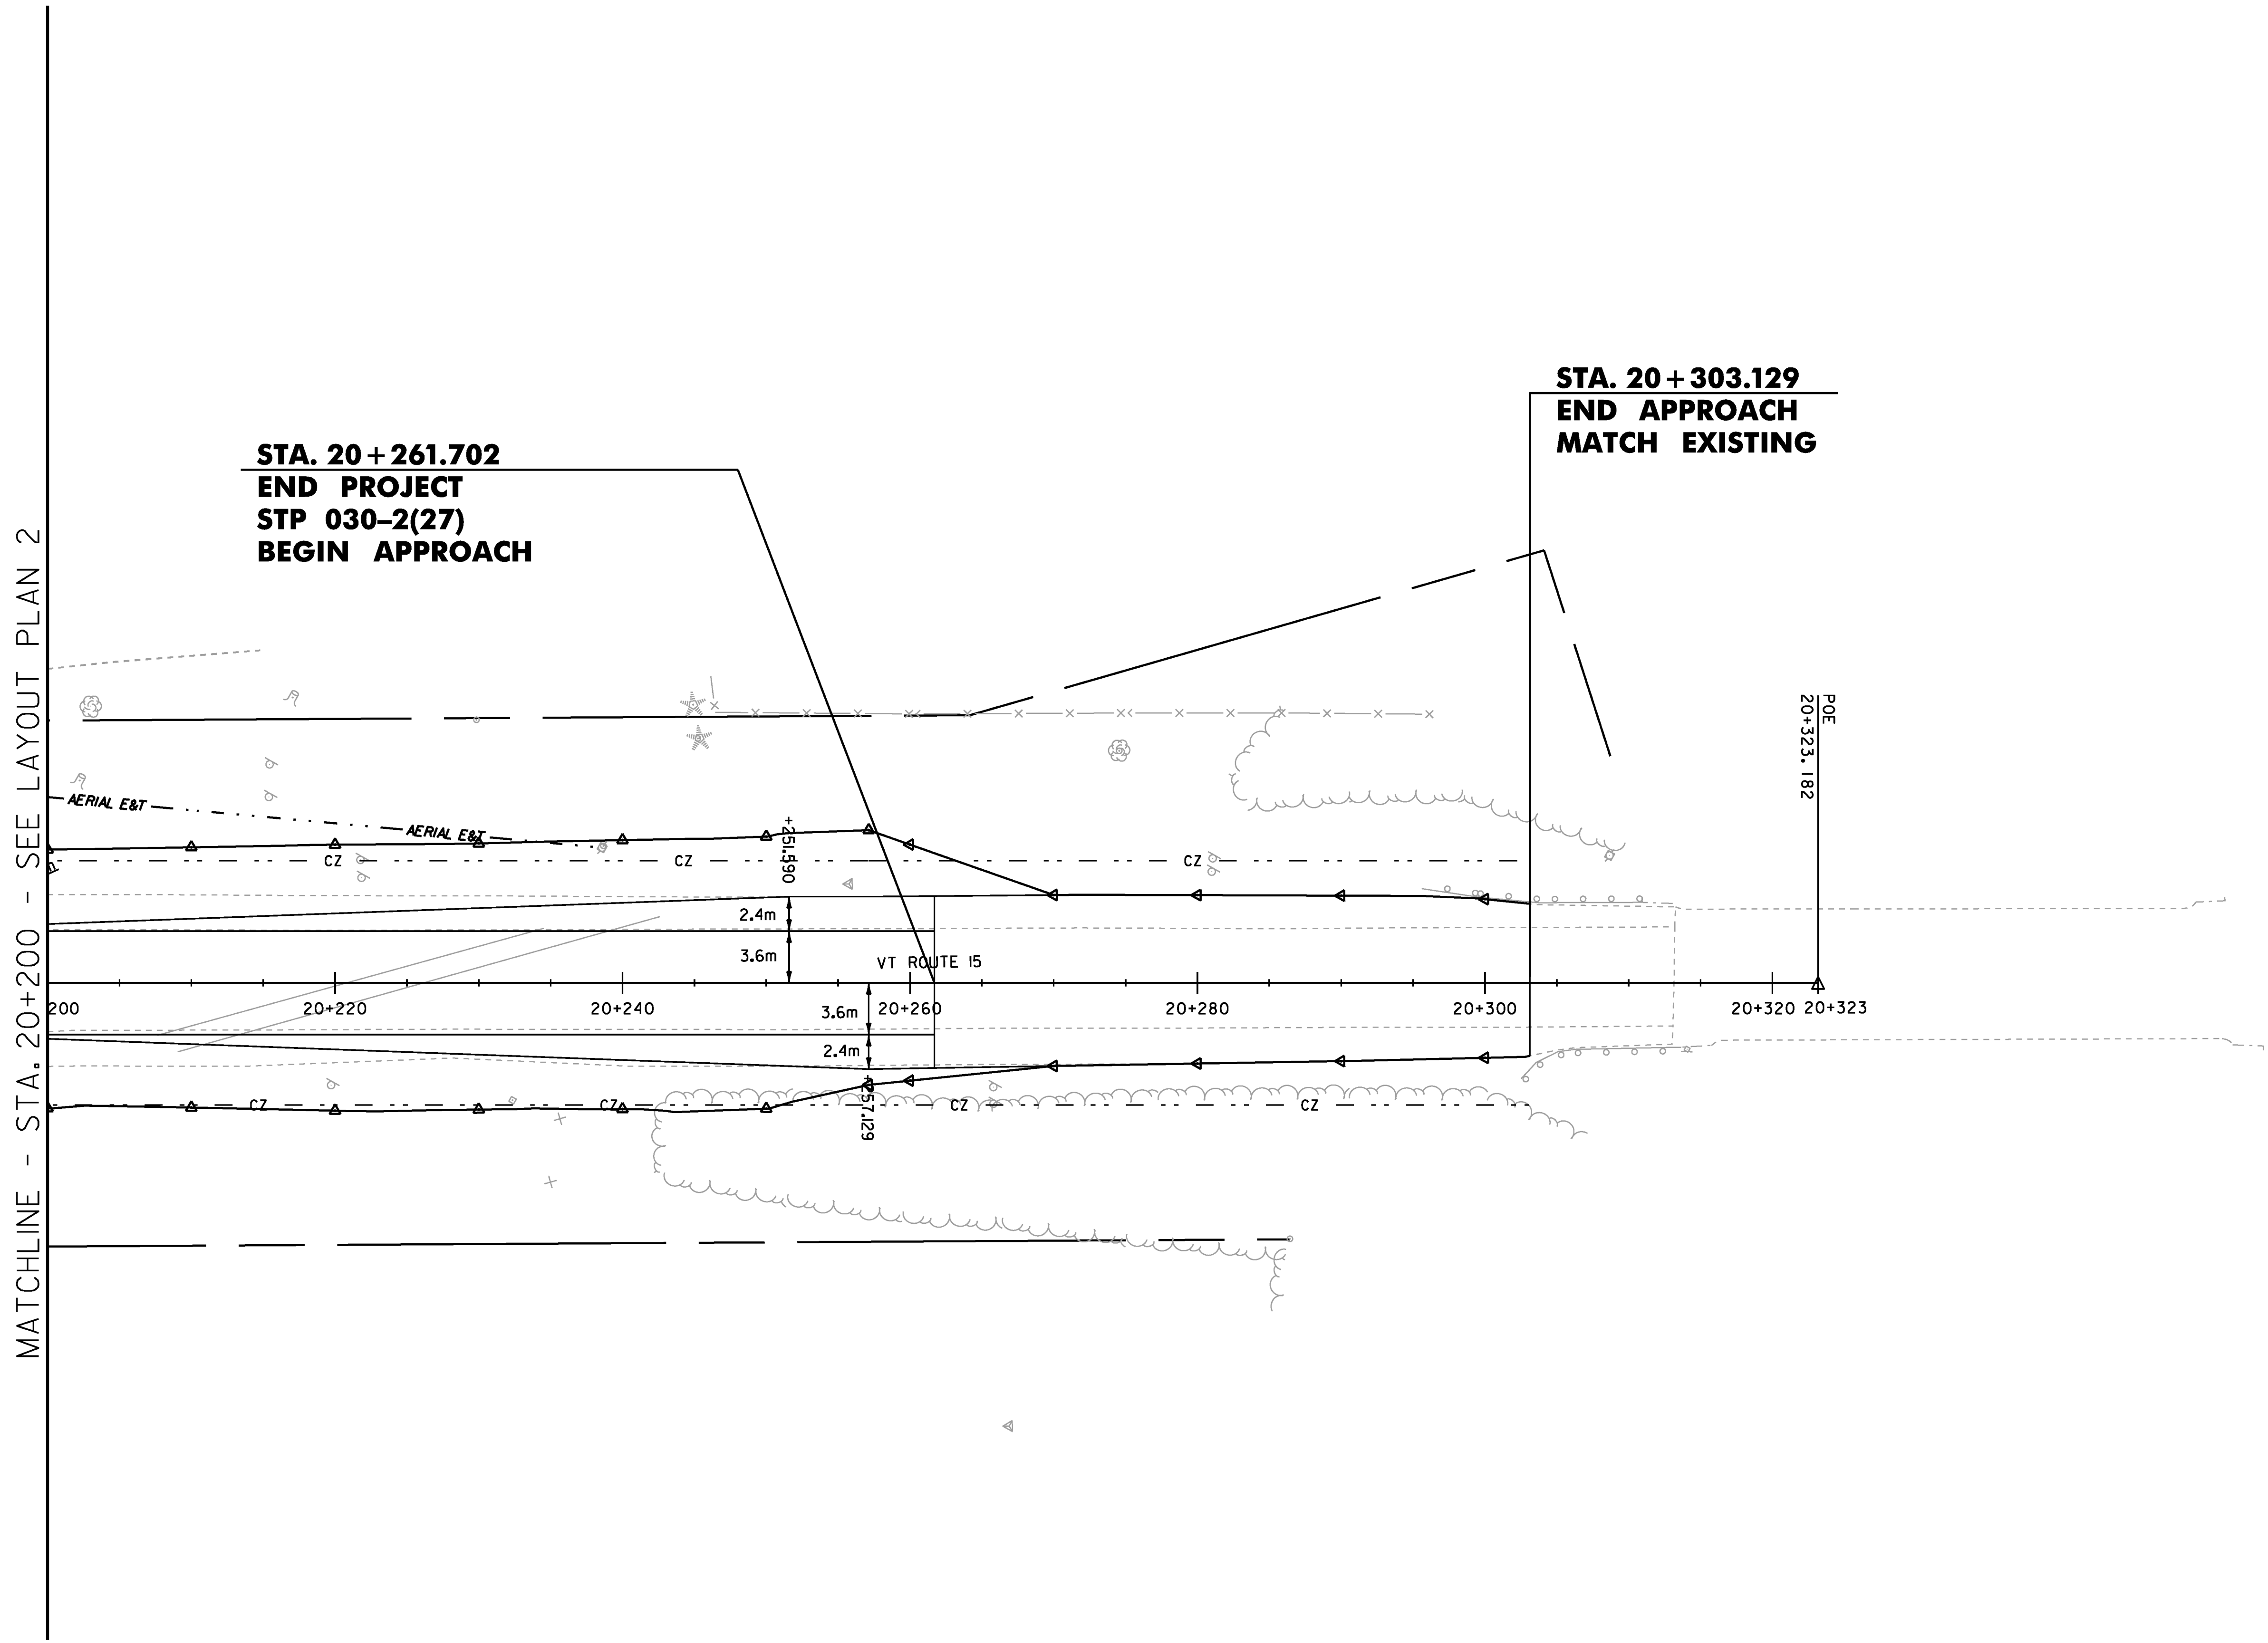

PROJECT NAME: CAMBRIDGE	PLOT DATE: 05-JUN-2012
PROJECT NUMBER: STP 030-2(27)	DRAWN BY: MBL
FILE NAME: +78f163bdr.dgn	CHECKED BY: JAD
PROJECT LEADER: JLS	SHEET 46 OF 214
DESIGNED BY: MBL	
LAYOUT PLAN 3	