
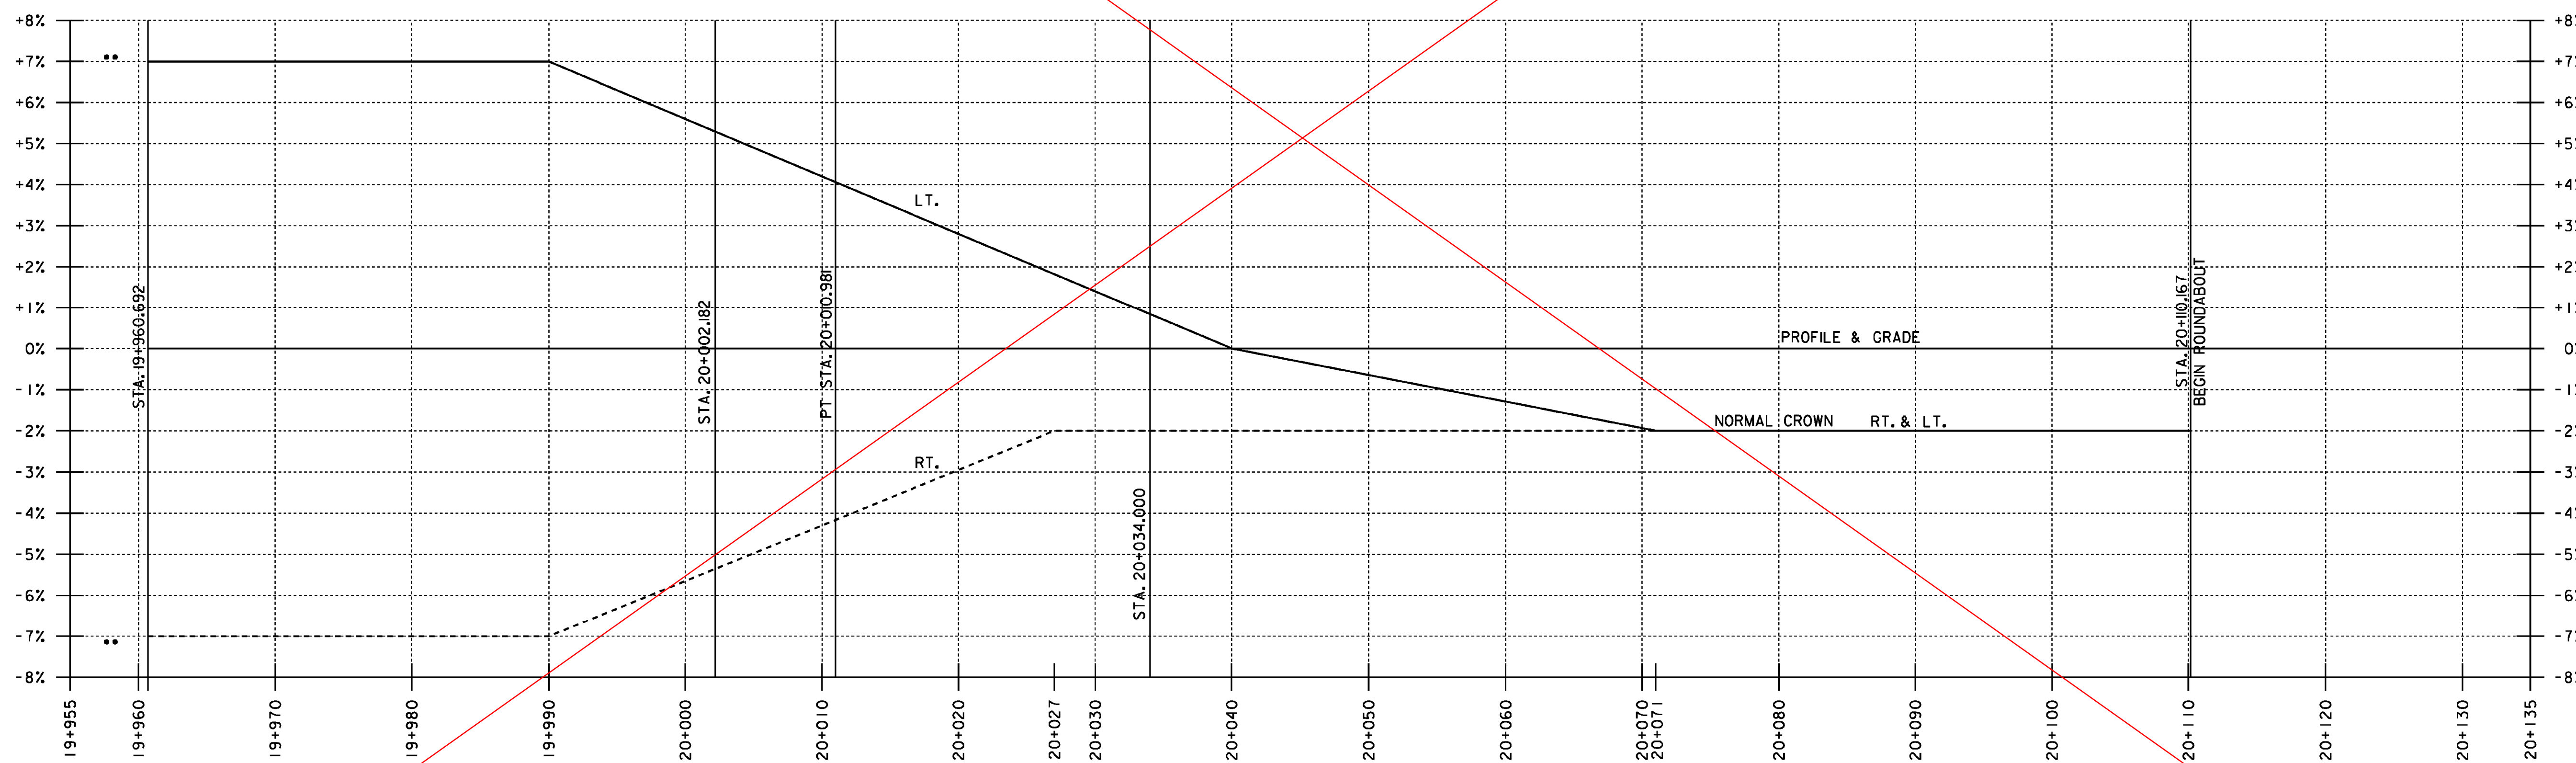


VT ROUTE 15 BASELINE PROFILE

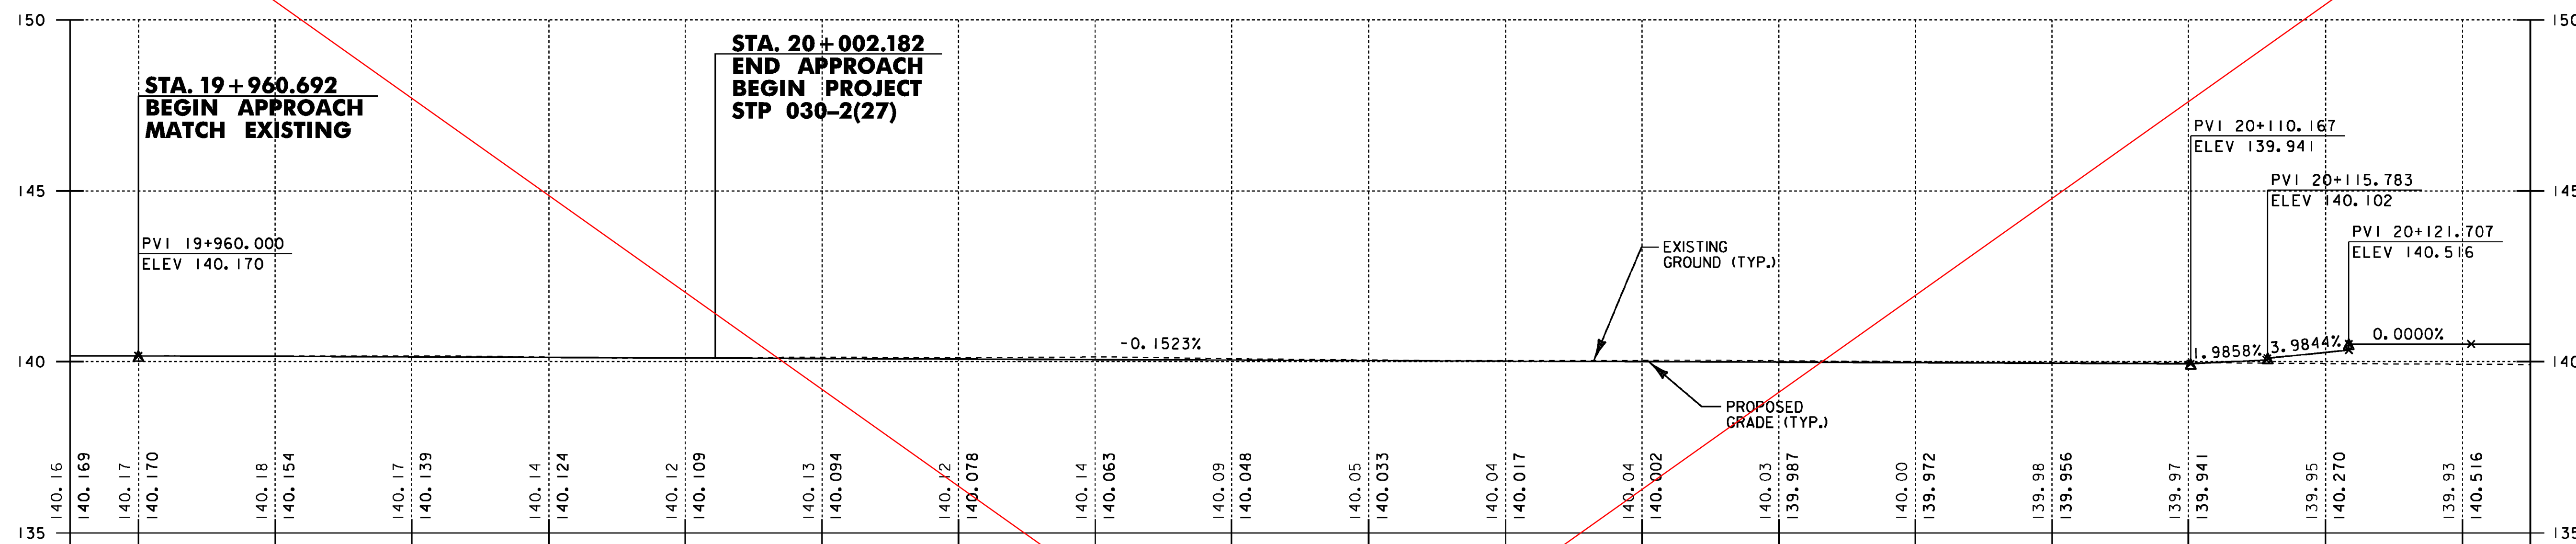


VT ROUTE 15 BANKING DIAGRAM

BANKING LEGEND

- LEFT LANE BANKING
- RIGHT LANE BANKING
- MATCH EXISTING BANKING

THE ELEVATIONS SHOWN TO THE NEAREST HUNDRETH ARE THE EXISTING GROUND ALONG REVISED CENTERLINE. THE ELEVATIONS SHOWN TO THE NEAREST THOUSANDTH ARE THE PROPOSED FINISHED GRADE ALONG REVISED CENTERLINE.

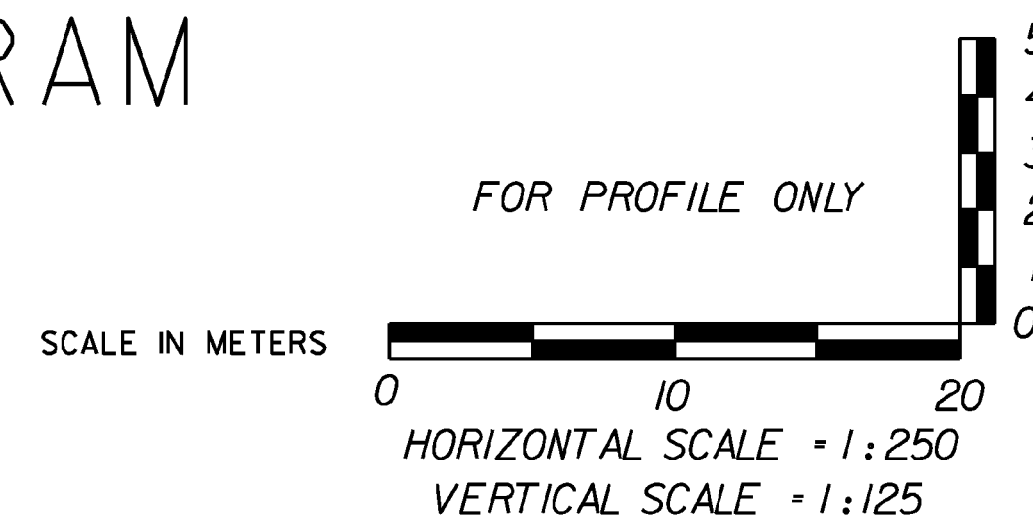

PROJECT NAME: CAMBRIDGE		PLOT DATE: 05 JUN-2012	
PROJECT NUMBER: STP 030-2(27)		DRAWN BY: MBL	
FILE NAME: t78f163pro.dgn	DESIGNED BY: MBL	CHECKED BY: JAD	SHEET 48 OF 214
PROJECT LEADER: MEM		PROFILE SHEET 1	