
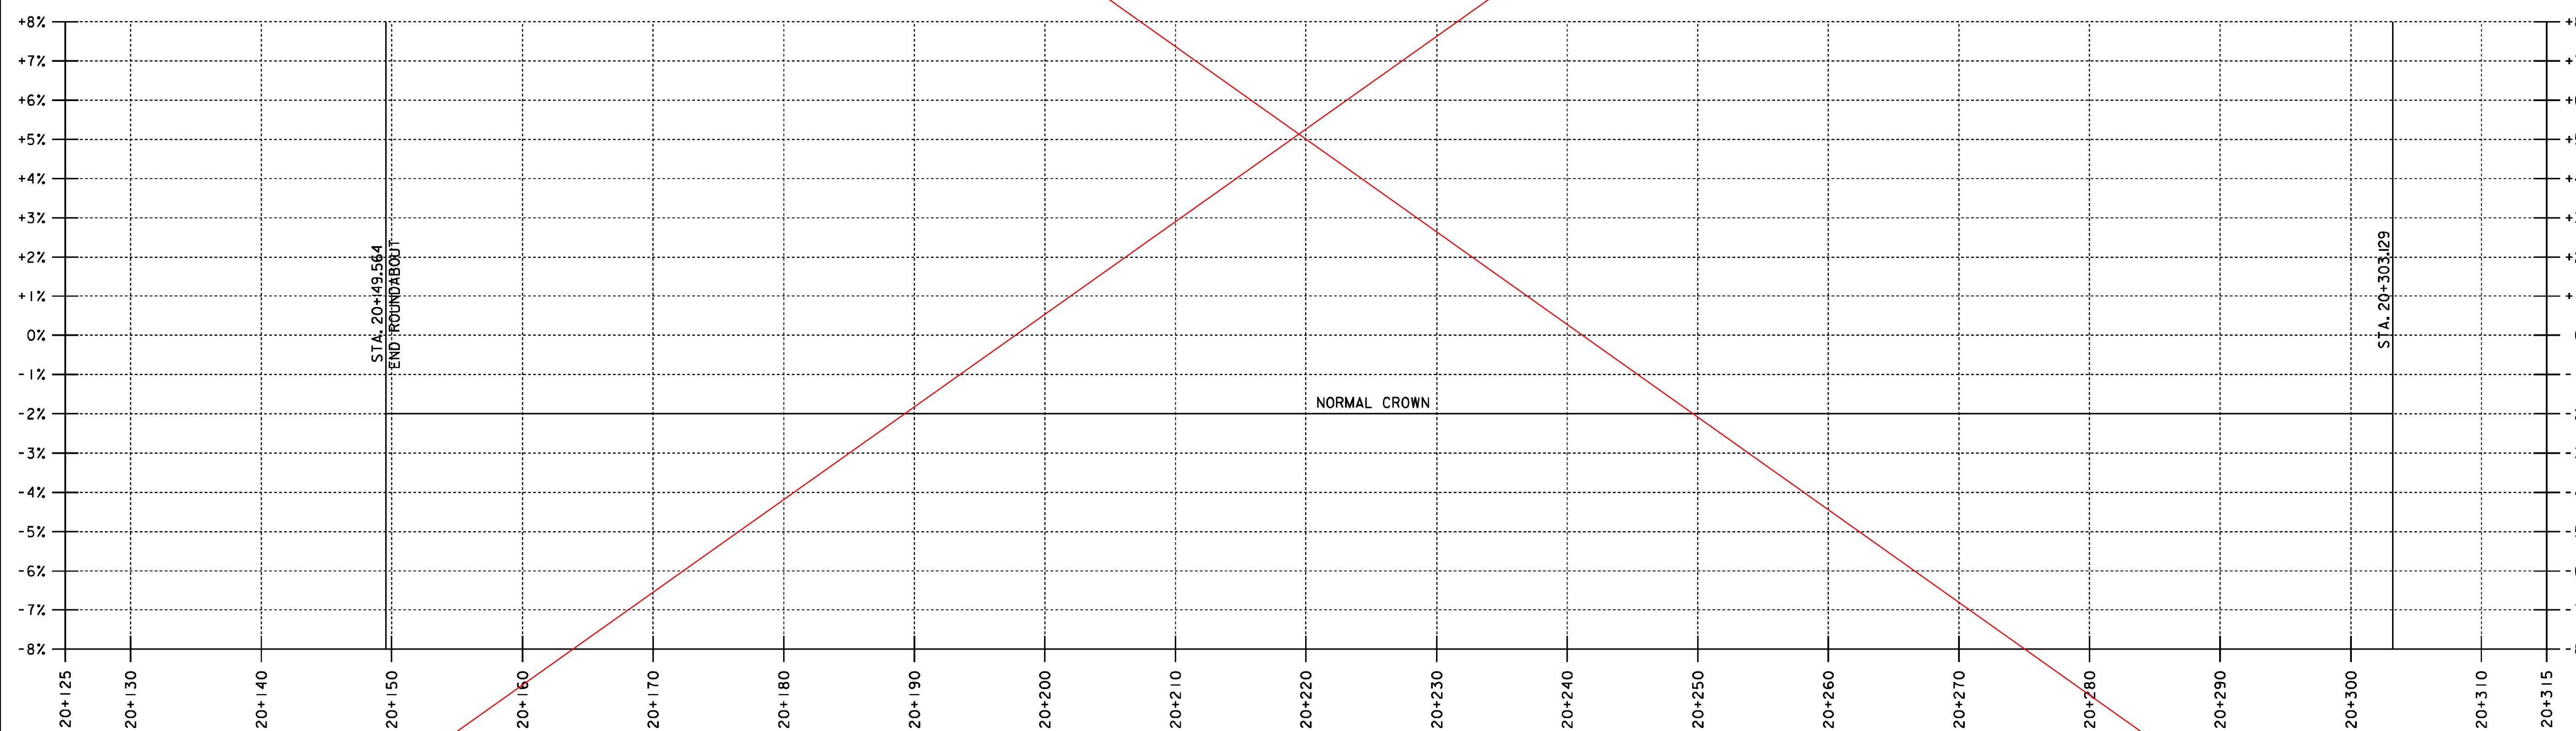



VT ROUTE 15 BASELINE PROFILE

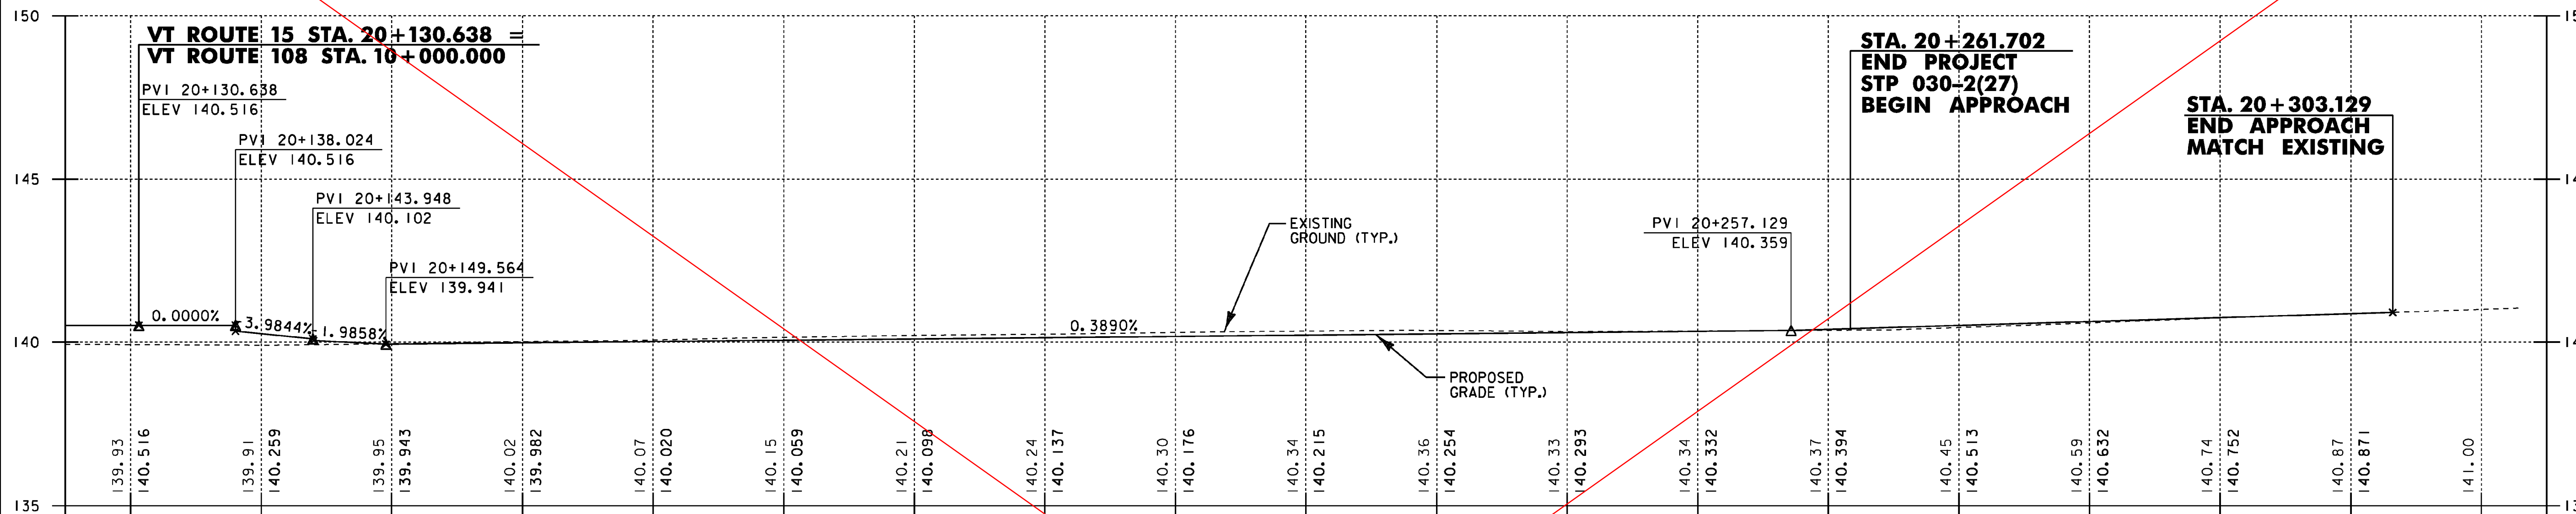

BANKING LEGEND

- LEFT LANE BANKING
- - - RIGHT LANE BANKING
- MATCH EXISTING BANKING

THE ELEVATIONS SHOWN TO THE NEAREST HUNDRETH ARE THE EXISTING GROUND ALONG REVISED CENTERLINE. THE ELEVATIONS SHOWN TO THE NEAREST THOUSANDTH ARE THE PROPOSED FINISHED GRADE ALONG REVISED CENTERLINE.

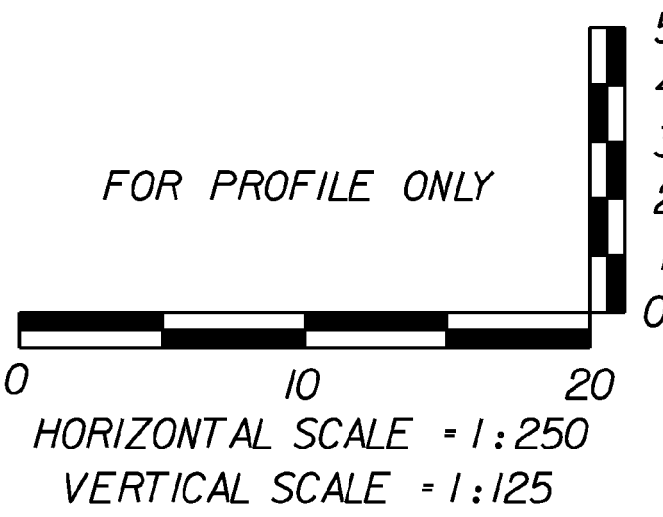

PROJECT NAME: CAMBRIDGE	PLOT DATE: 05-JUN-2012
PROJECT NUMBER: STP 030-2(27)	DRAWN BY: MBL
FILE NAME: t78f163pro.dgn	CHECKED BY: JAD
PROJECT LEADER: MEM	SHEET 49 OF 214
DESIGNED BY: MBL	
PROFILE SHEET 2	