
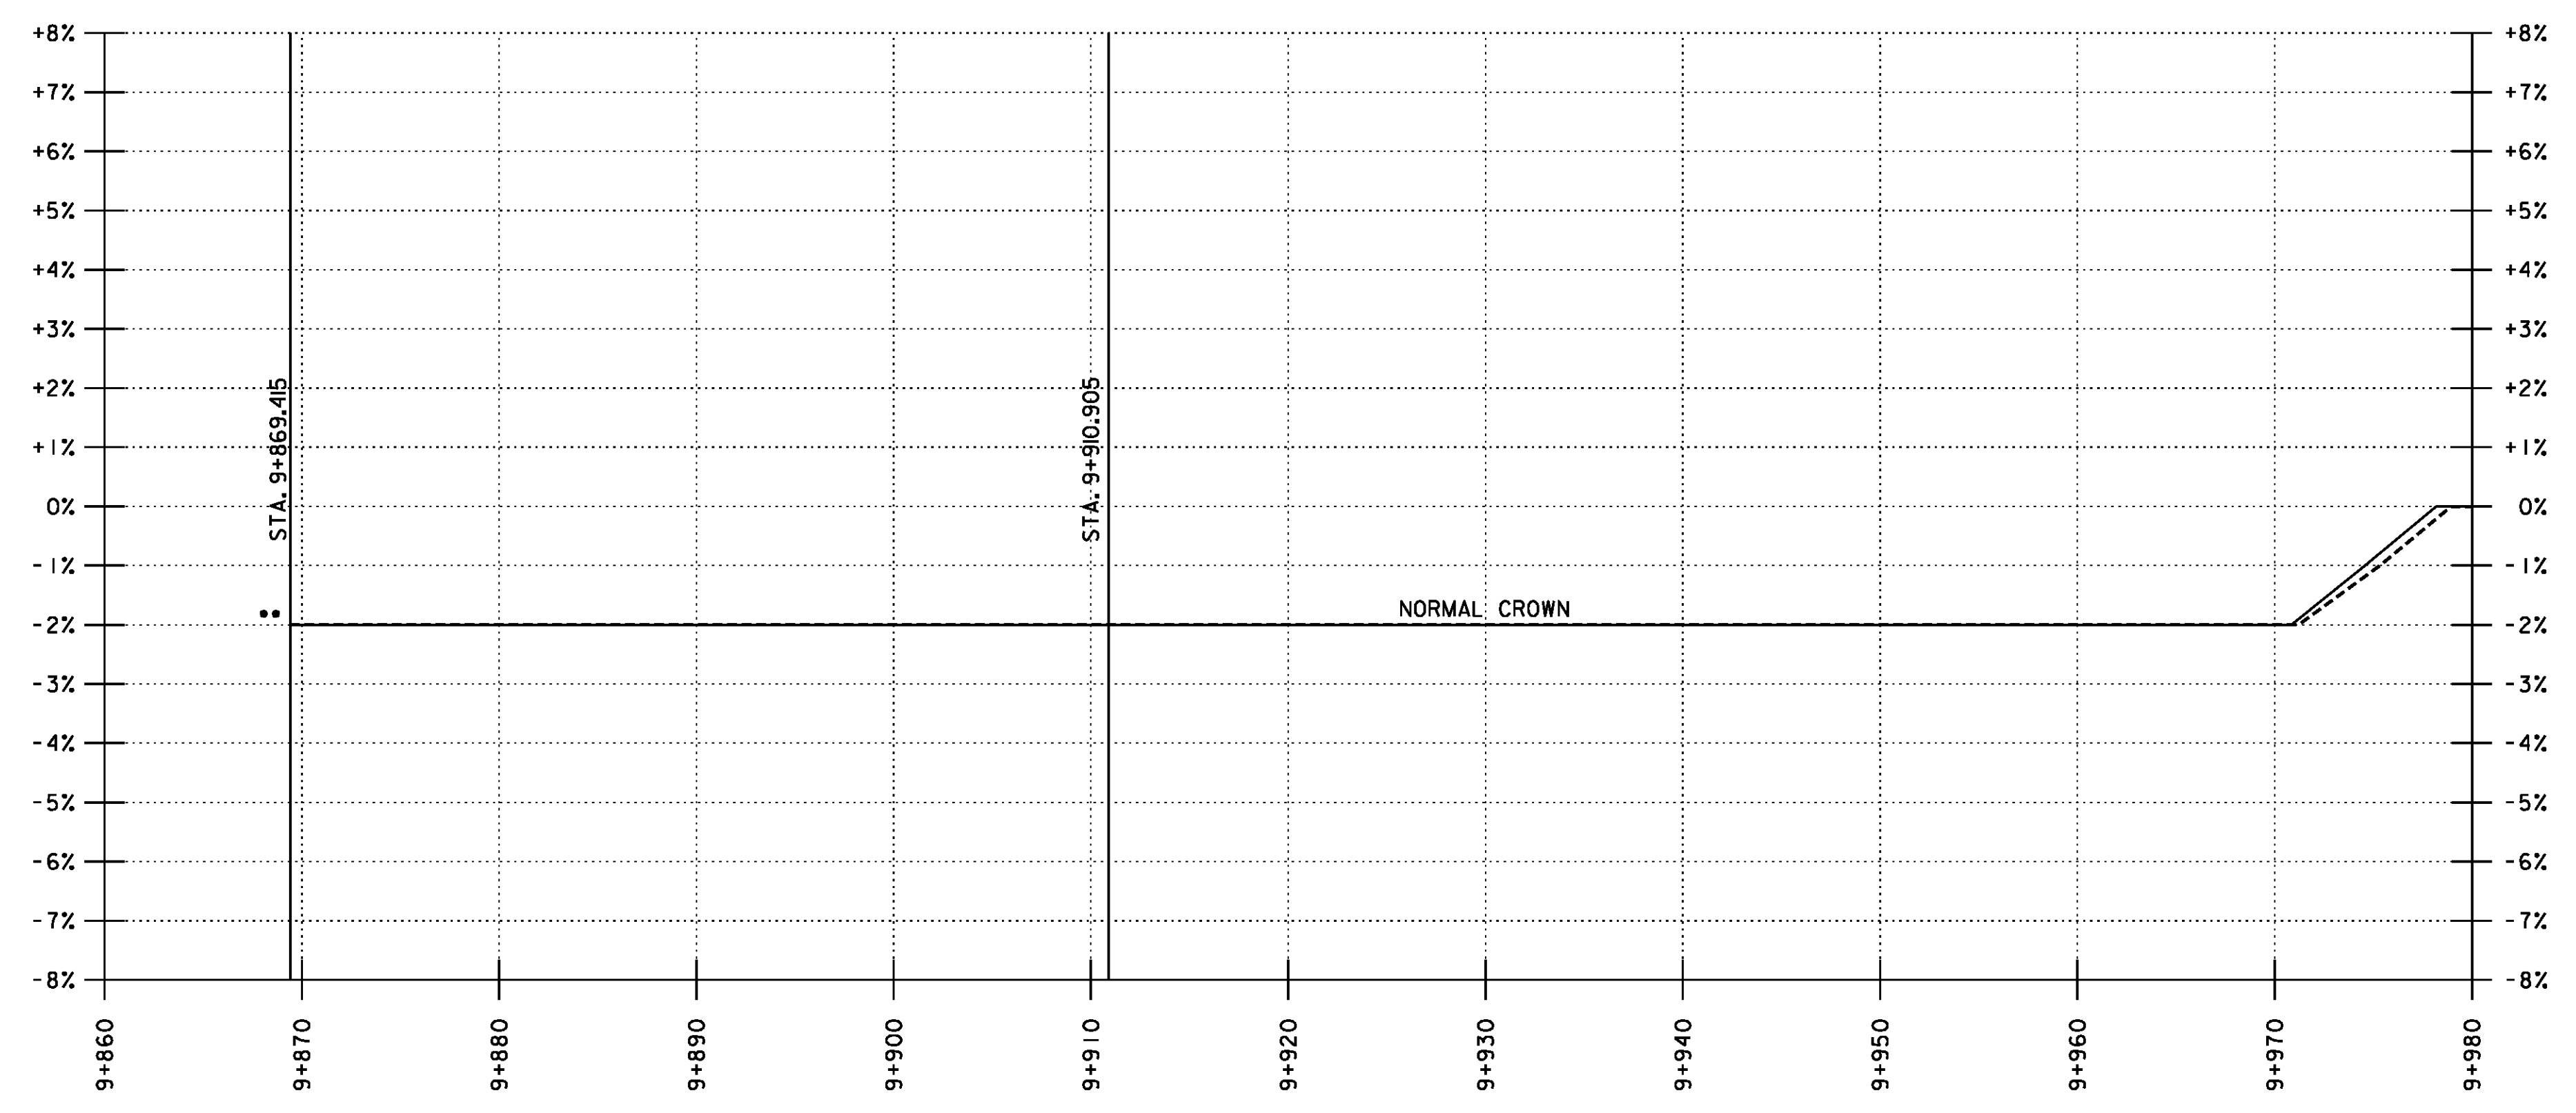


VT ROUTE 108 BASELINE PROFILE

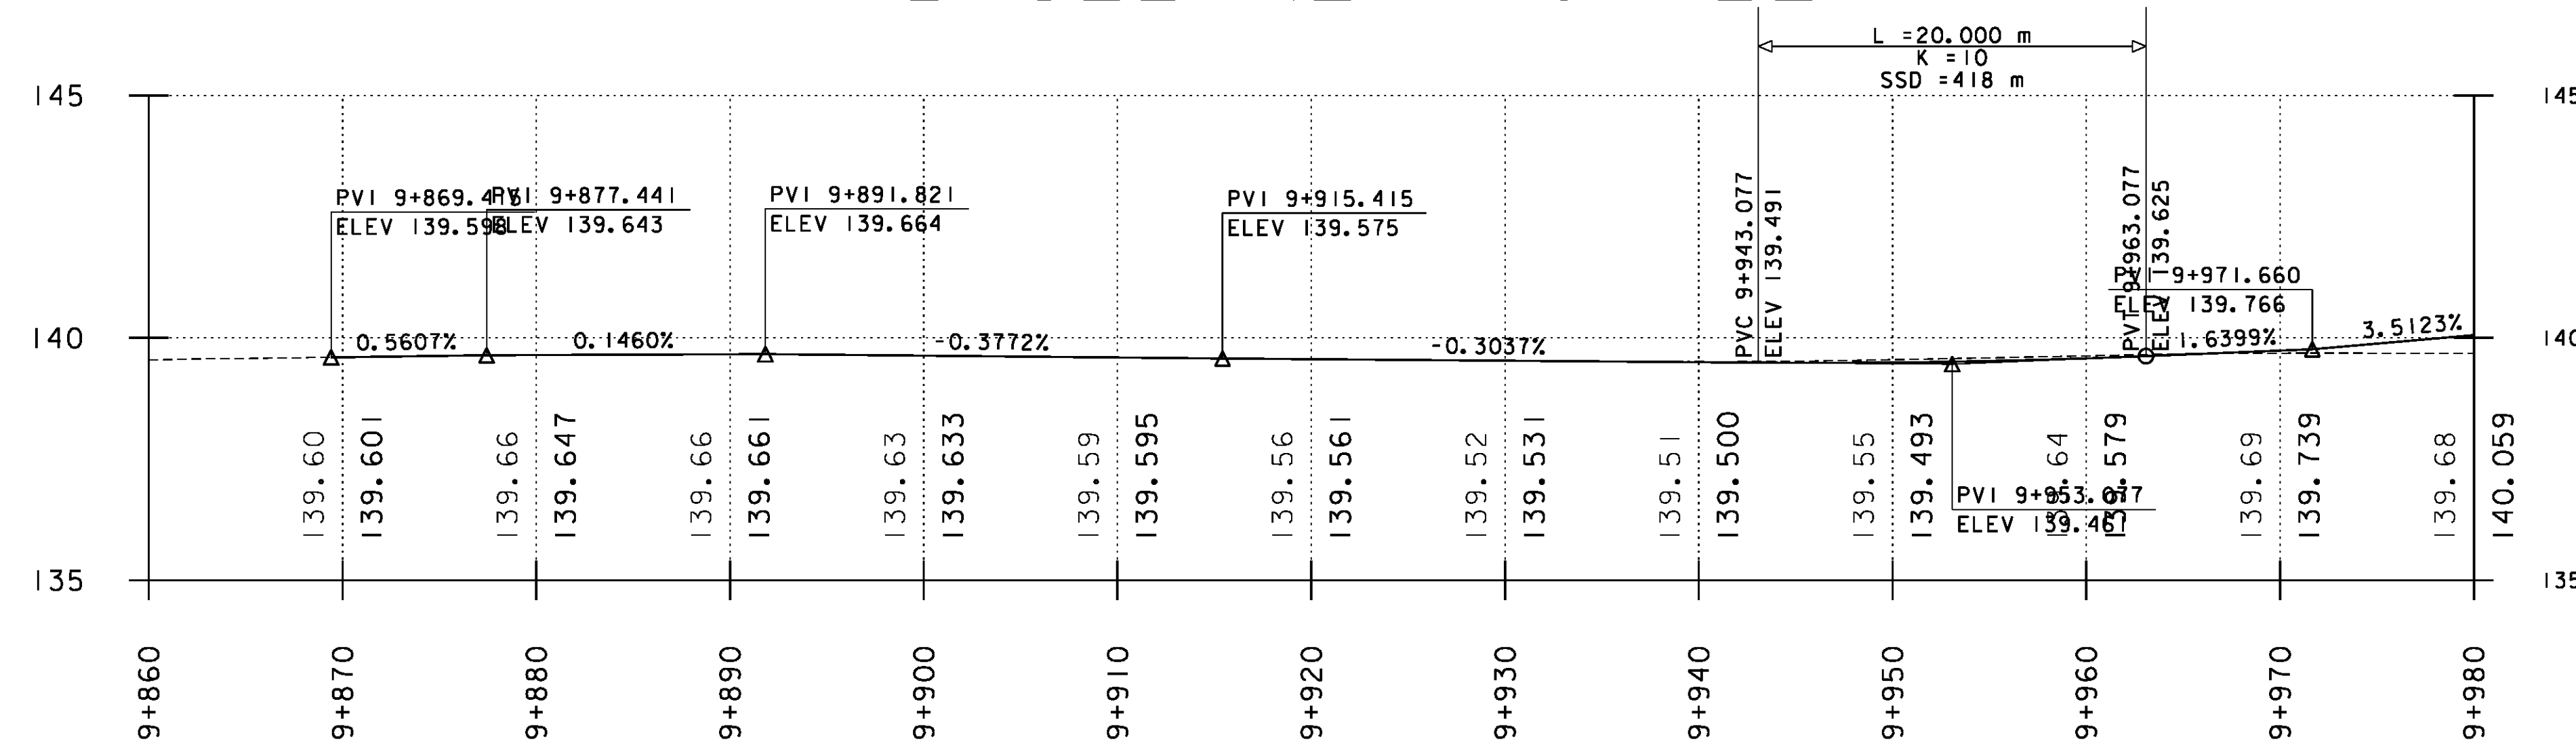


VT ROUTE 108 BANKING DIAGRAM

BANKING LEGEND

- LEFT LANE BANKING
- - - - RIGHT LANE BANKING
- MATCH EXISTING BANKING

THE ELEVATIONS SHOWN TO THE NEAREST HUNDRETH ARE THE EXISTING GROUND ALONG REVISED CENTERLINE, THE ELEVATIONS SHOWN TO THE NEAREST THOUSANDTH ARE THE PROPOSED FINISHED GRADE ALONG REVISED CENTERLINE.

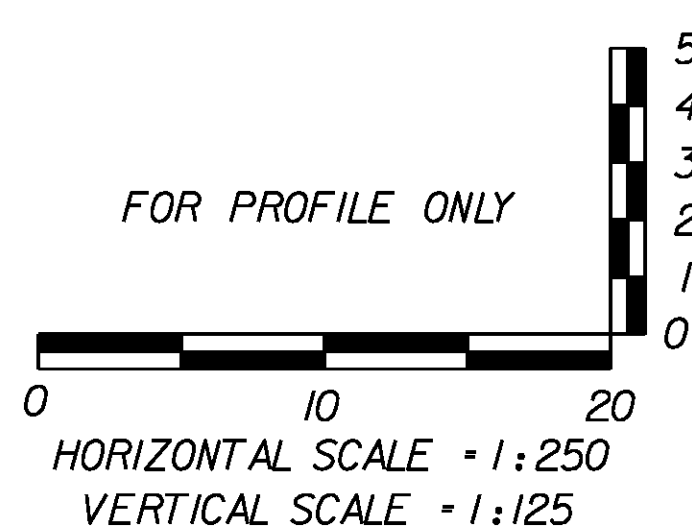

▲ REVISED BANKING DIAGRAM

PROJECT NAME: CAMBRIDGE	
PROJECT NUMBER: STP 030-2(27)	
FILE NAME: f78f163pro.dgn	PLOT DATE: 5/1/13
PROJECT LEADER: MEM	DRAWN BY: MBL
DESIGNED BY: MBL	CHECKED BY: JAD
PROFILE SHEET 3	SHEET 50 OF 214