
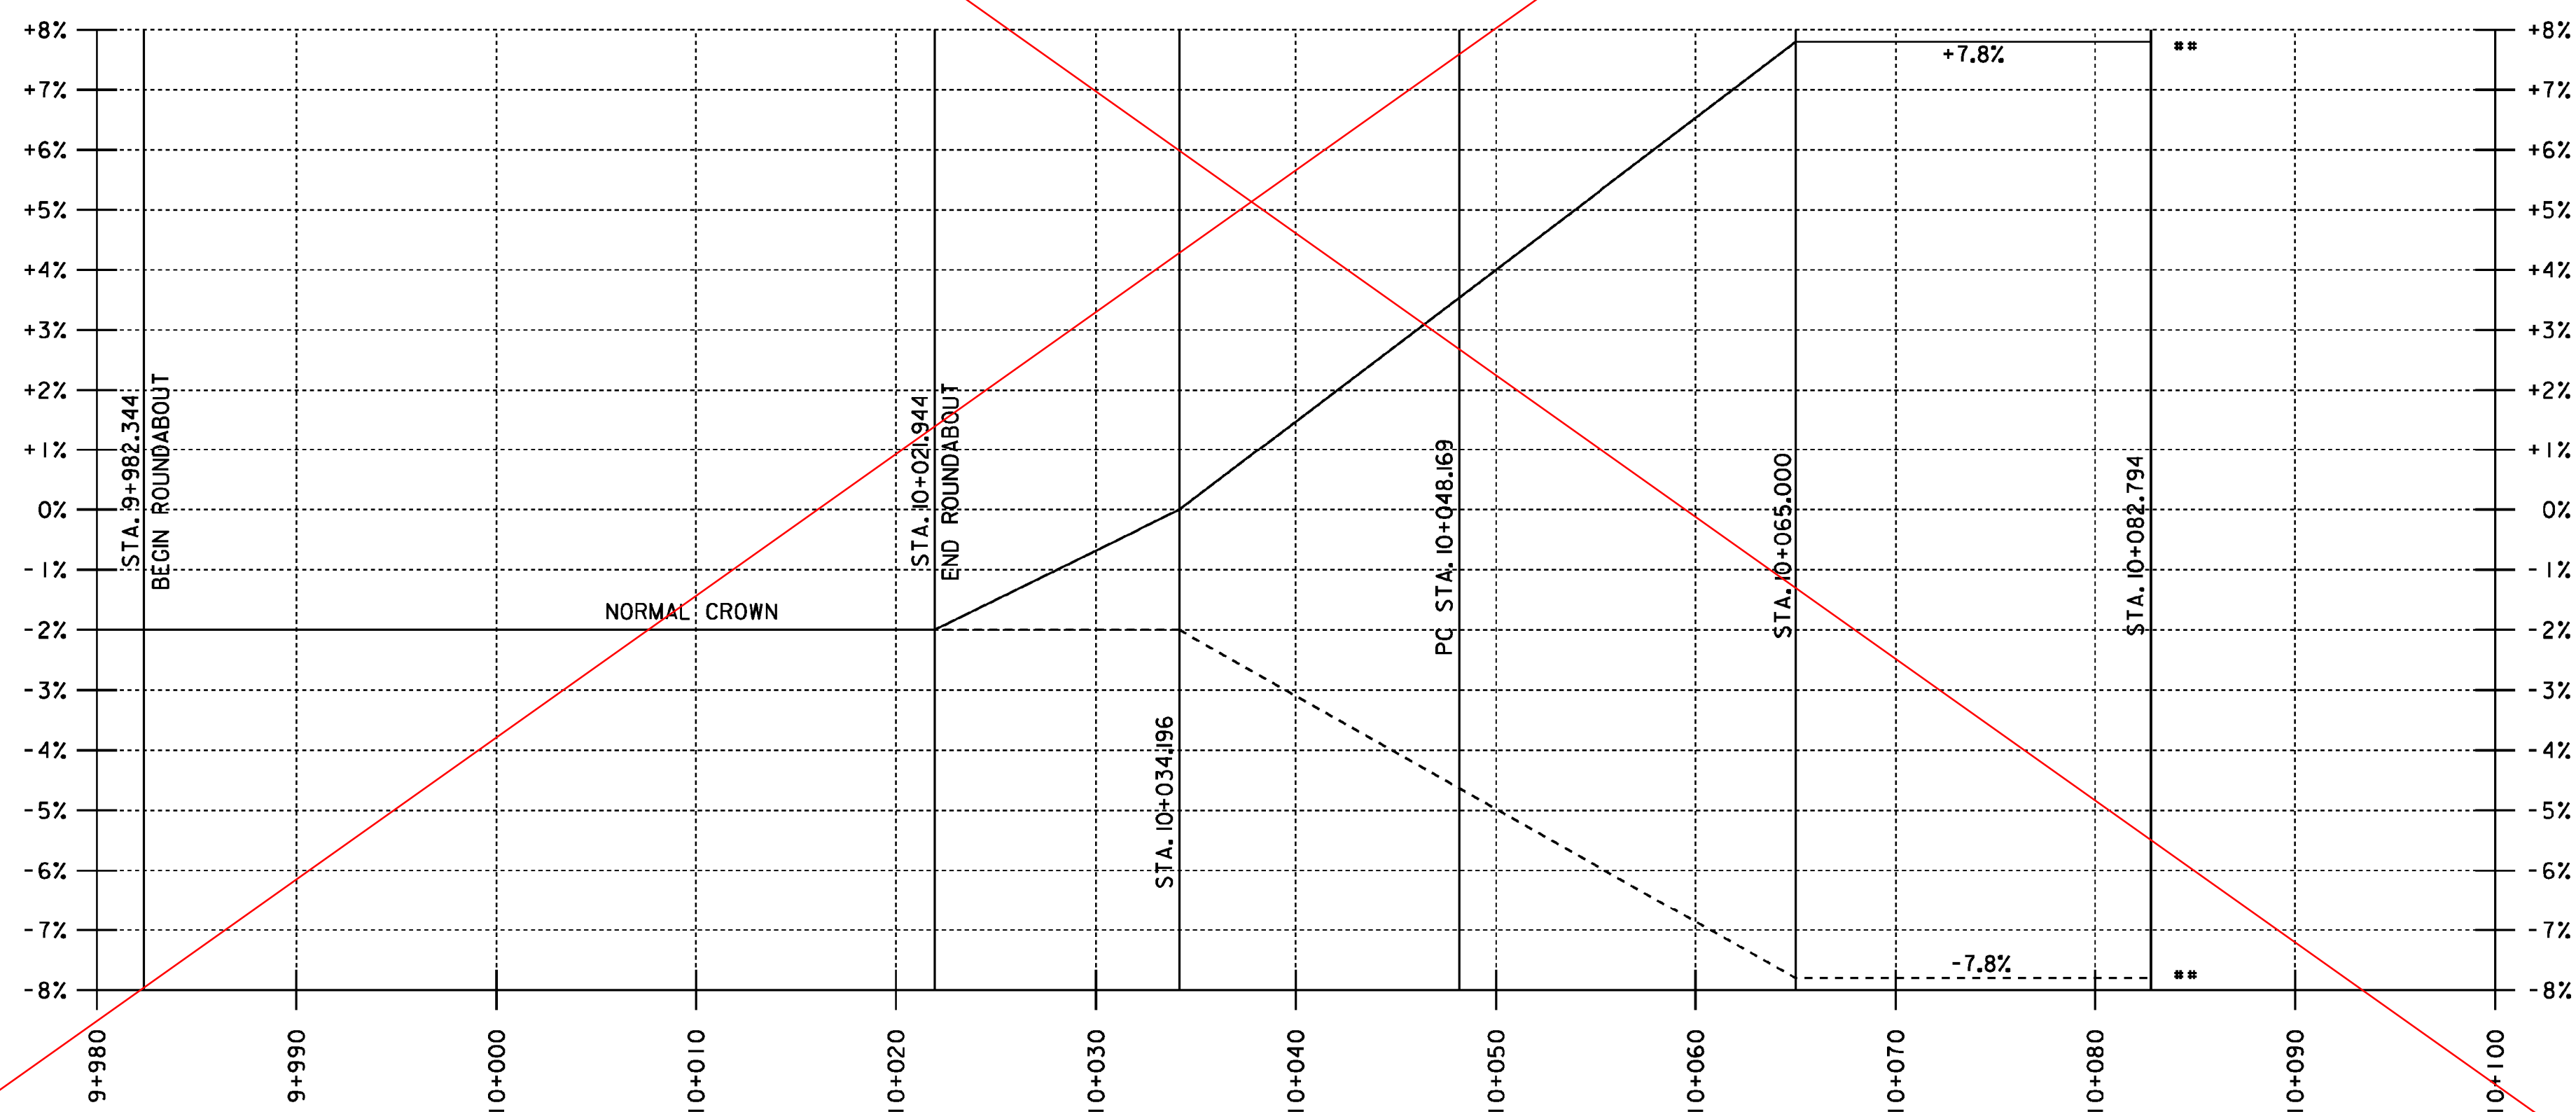


# VT ROUTE 108 BASELINE PROFILE

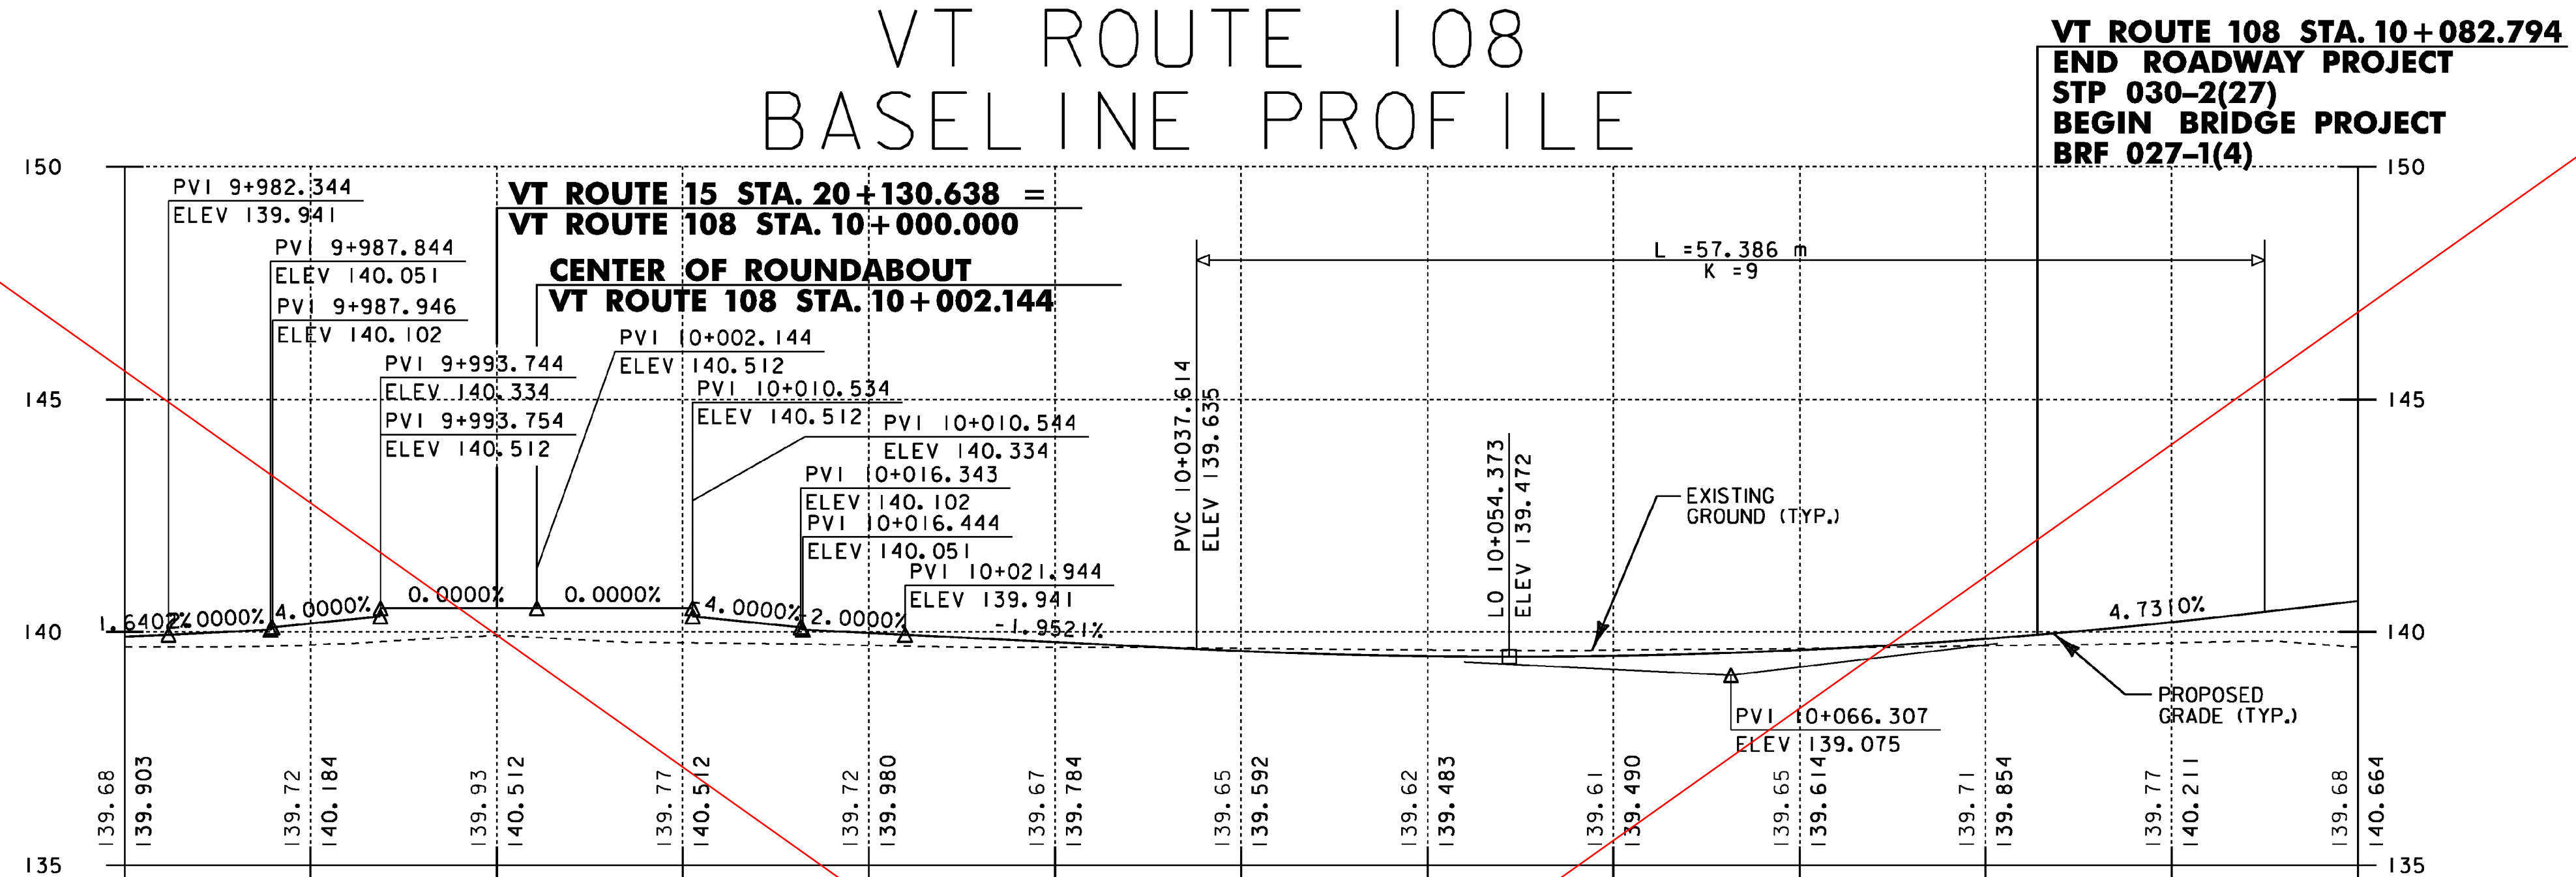


### BANKING LEGEND

- LEFT LANE BANKING
- - - RIGHT LANE BANKING
- \*\* MATCH BRF 027-1(4)

THE ELEVATIONS SHOWN TO THE NEAREST HUNDRETH ARE THE EXISTING GROUND ALONG REVISED CENTERLINE. THE ELEVATIONS SHOWN TO THE NEAREST THOUSANDTH ARE THE PROPOSED FINISHED GRADE ALONG REVISED CENTERLINE.

FOR PROFILE ONLY

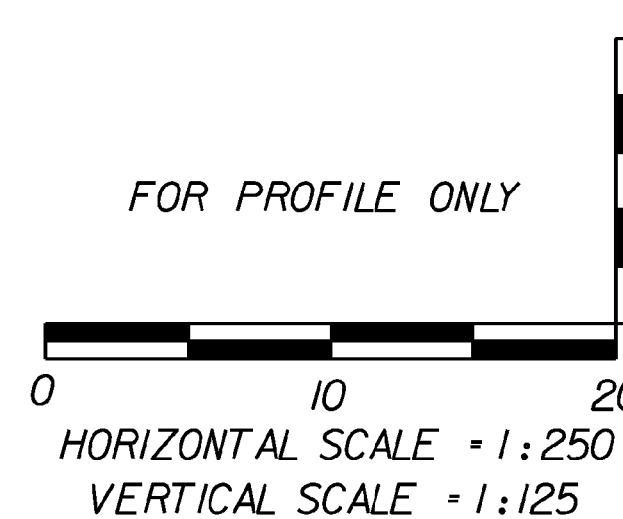

PROJECT NAME: CAMBRIDGE  
 PROJECT NUMBER: STP 030-2(27)

FILE NAME: t78f163pro.dgn  
 PROJECT LEADER: MEM  
 DESIGNED BY: MBL  
 PROFILE SHEET 4

PLOT DATE: 05 JUN 2012  
 DRAWN BY: MBL  
 CHECKED BY: JAD  
 SHEET 51 OF 214