


U1 STA. 20+046.892, 7.309m, LT. - STA. 20+080, 3.657m, LT.
 NEW 200mm X 4.0m UNDERDRAIN
 NEW 200mm X 4.5m UNDERDRAIN CARRIER PIPE
 NEW FLUSHING BASIN AT 20+046.892, 7.309m, LT.


EX5 STA. 20+044.222, 22.332m, LT. - STA. 20+045.542, 9.655m, RT.
 CLEAN AND RETAIN EXISTING 600mm CULVERT

U2 STA. 20+047.566, 6.910m, RT. - STA. 20+080, 3.288m, RT.
 NEW 200mm X 4.0m UNDERDRAIN
 NEW 200mm X 3.9m UNDERDRAIN CARRIER PIPE
 NEW FLUSHING BASIN AT 20+047.566, 6.910m, RT.

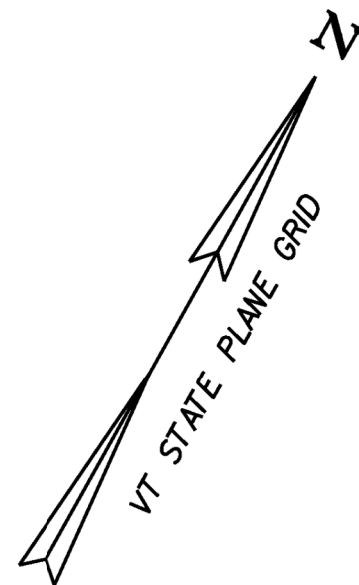

**STA. 19+960.692
 BEGIN APPROACH**

**STA. 20+002.182
 END APPROACH
 BEGIN PROJECT
 STP 030-2(27)**

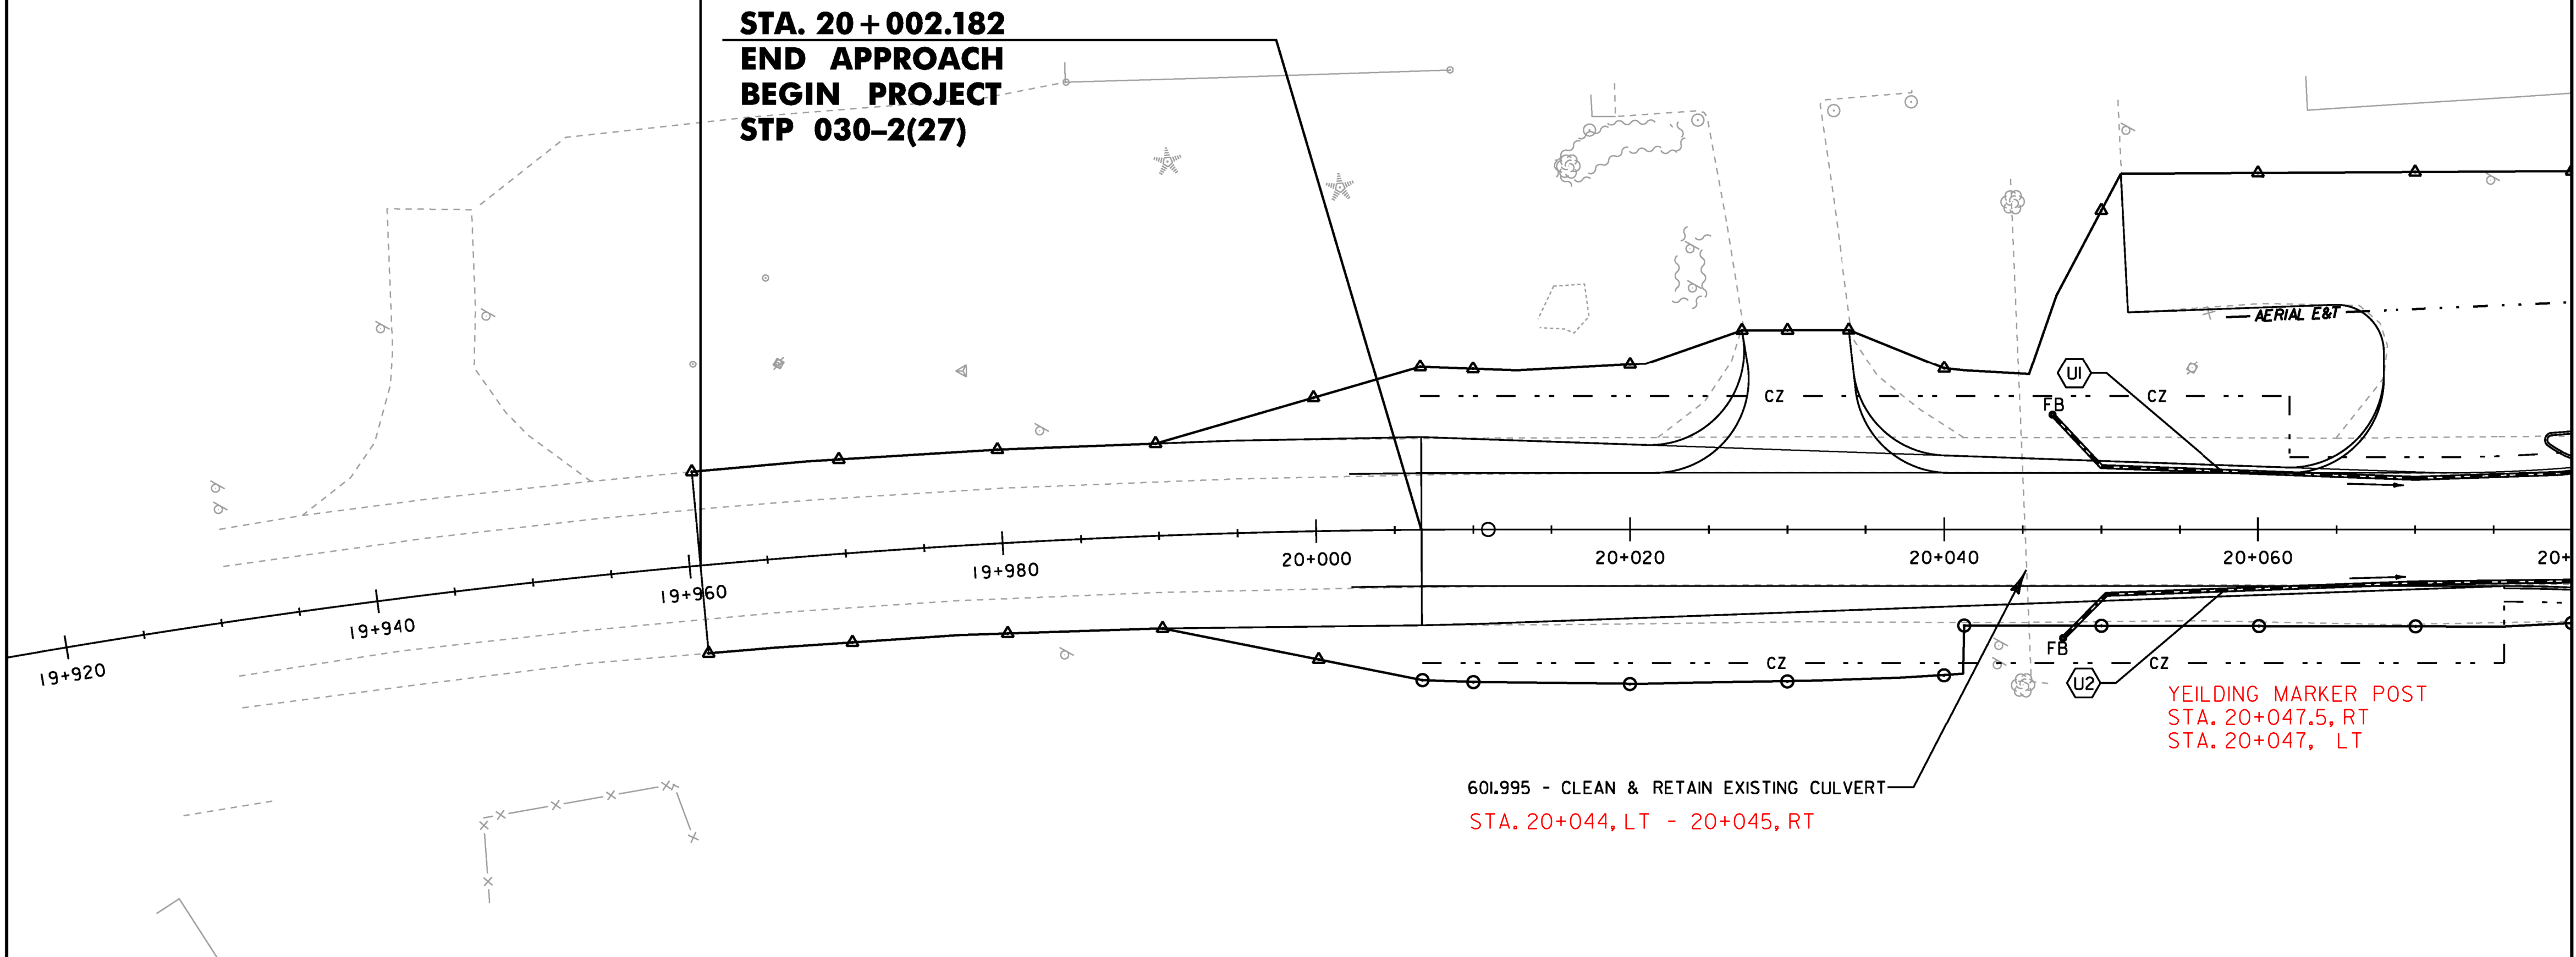

601.995 - CLEAN & RETAIN EXISTING CULVERT
 STA. 20+044, LT - 20+045, RT

YEILDING MARKER POST
 STA. 20+047.5, RT
 STA. 20+047, LT

MATCHLINE - STA. 20+080 - SEE DRAINAGE PLAN 2

LEGEND

•FB FLUSHING BASIN



PROJECT NAME: CAMBRIDGE	PLOT DATE: 05-JUN-2012
PROJECT NUMBER: STP 030-2(27)	DRAWN BY: MBL
FILE NAME: +78f163bdr.dgn	CHECKED BY: JAD
PROJECT LEADER: JLS	SHEET 53 OF 214
DESIGNED BY: MBL	
DRAINAGE PLAN I	