


- 1 REVISED CB-8 RIM ELEVATION AND DEPTH
- 2 REVISED CB-9 RIM ELEVATION AND DEPTH
- 3 REVISED CB-11 RIM ELEVATION AND DEPTH
- 4 REVISED CB-13 RIM ELEVATION AND DEPTH
- 5 REVISED CB-14 RIM ELEVATION AND DEPTH
- 6 REVISED CB-11 RIM ELEVATION TO 139.602 AND DEPTH TO 1.57 M
- 7 REMOVED CB-12 AND PIPE 12 AND REPLACED WITH CB-12A AND PIPE 12A

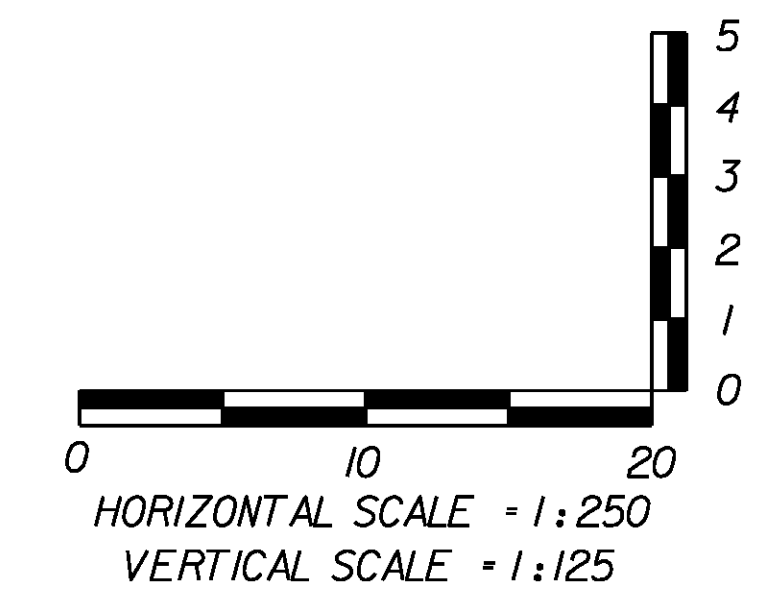

PROJECT NAME: CAMBRIDGE
 PROJECT NUMBER: STP 030-2(27)

FILE NAME: f78f163pro-drn.dgn
 PROJECT LEADER: JLS
 DESIGNED BY: MBL
 DRAINAGE PROFILE SHEET 2

PLOT DATE: 6/21/13
 DRAWN BY: MBL
 CHECKED BY: JAD
 SHEET 56 OF 214