


- 1 ADDED PIPE PROFILE 20
- 2 ADDED PIPE PROFILE 21
- 3 REVISED PIPE PROFILE 21

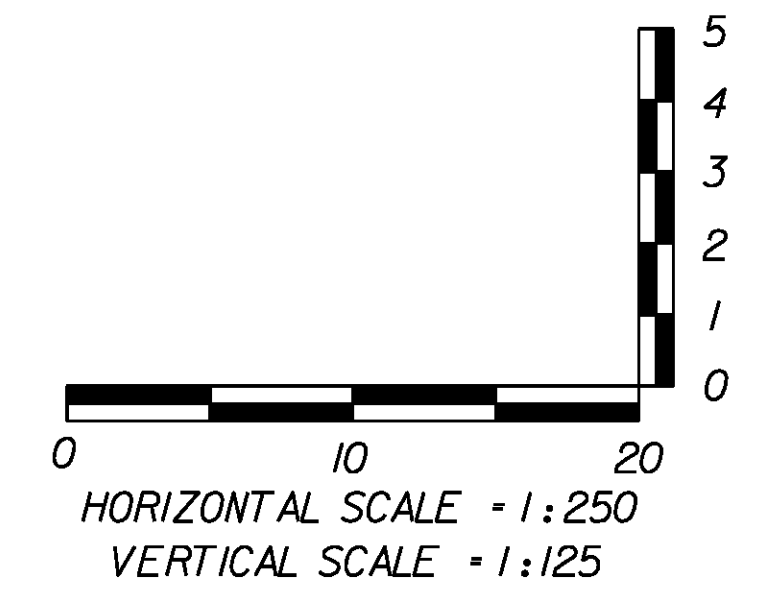

PROJECT NAME: CAMBRIDGE	PLOT DATE: 5/13/13
PROJECT NUMBER: STP 030-2(27)	DRAWN BY: MBL
FILE NAME: f78f163pro-drn.dgn	CHECKED BY: JAD
PROJECT LEADER: JLS	SHEET 57A OF 214
DESIGNED BY: MBL	
DRAINAGE PROFILE SHEET 4	