


MATCHLINE - STA. 20+200 - SEE LAYOUT PLAN 2



FOR R.O.W. USE ONLY

LINE SHOWN ON THIS PLAN AS EXISTING PROPERTY LINES P/L ARE BELIEVED TO BE ACCURATE BUT SHOULD NOT BE RELIED UPON FOR PURPOSES UNRELATED TO THE STATE OF VERMONT'S ACQUISITION OF LAND AND RIGHTS FOR THIS PROJECT.

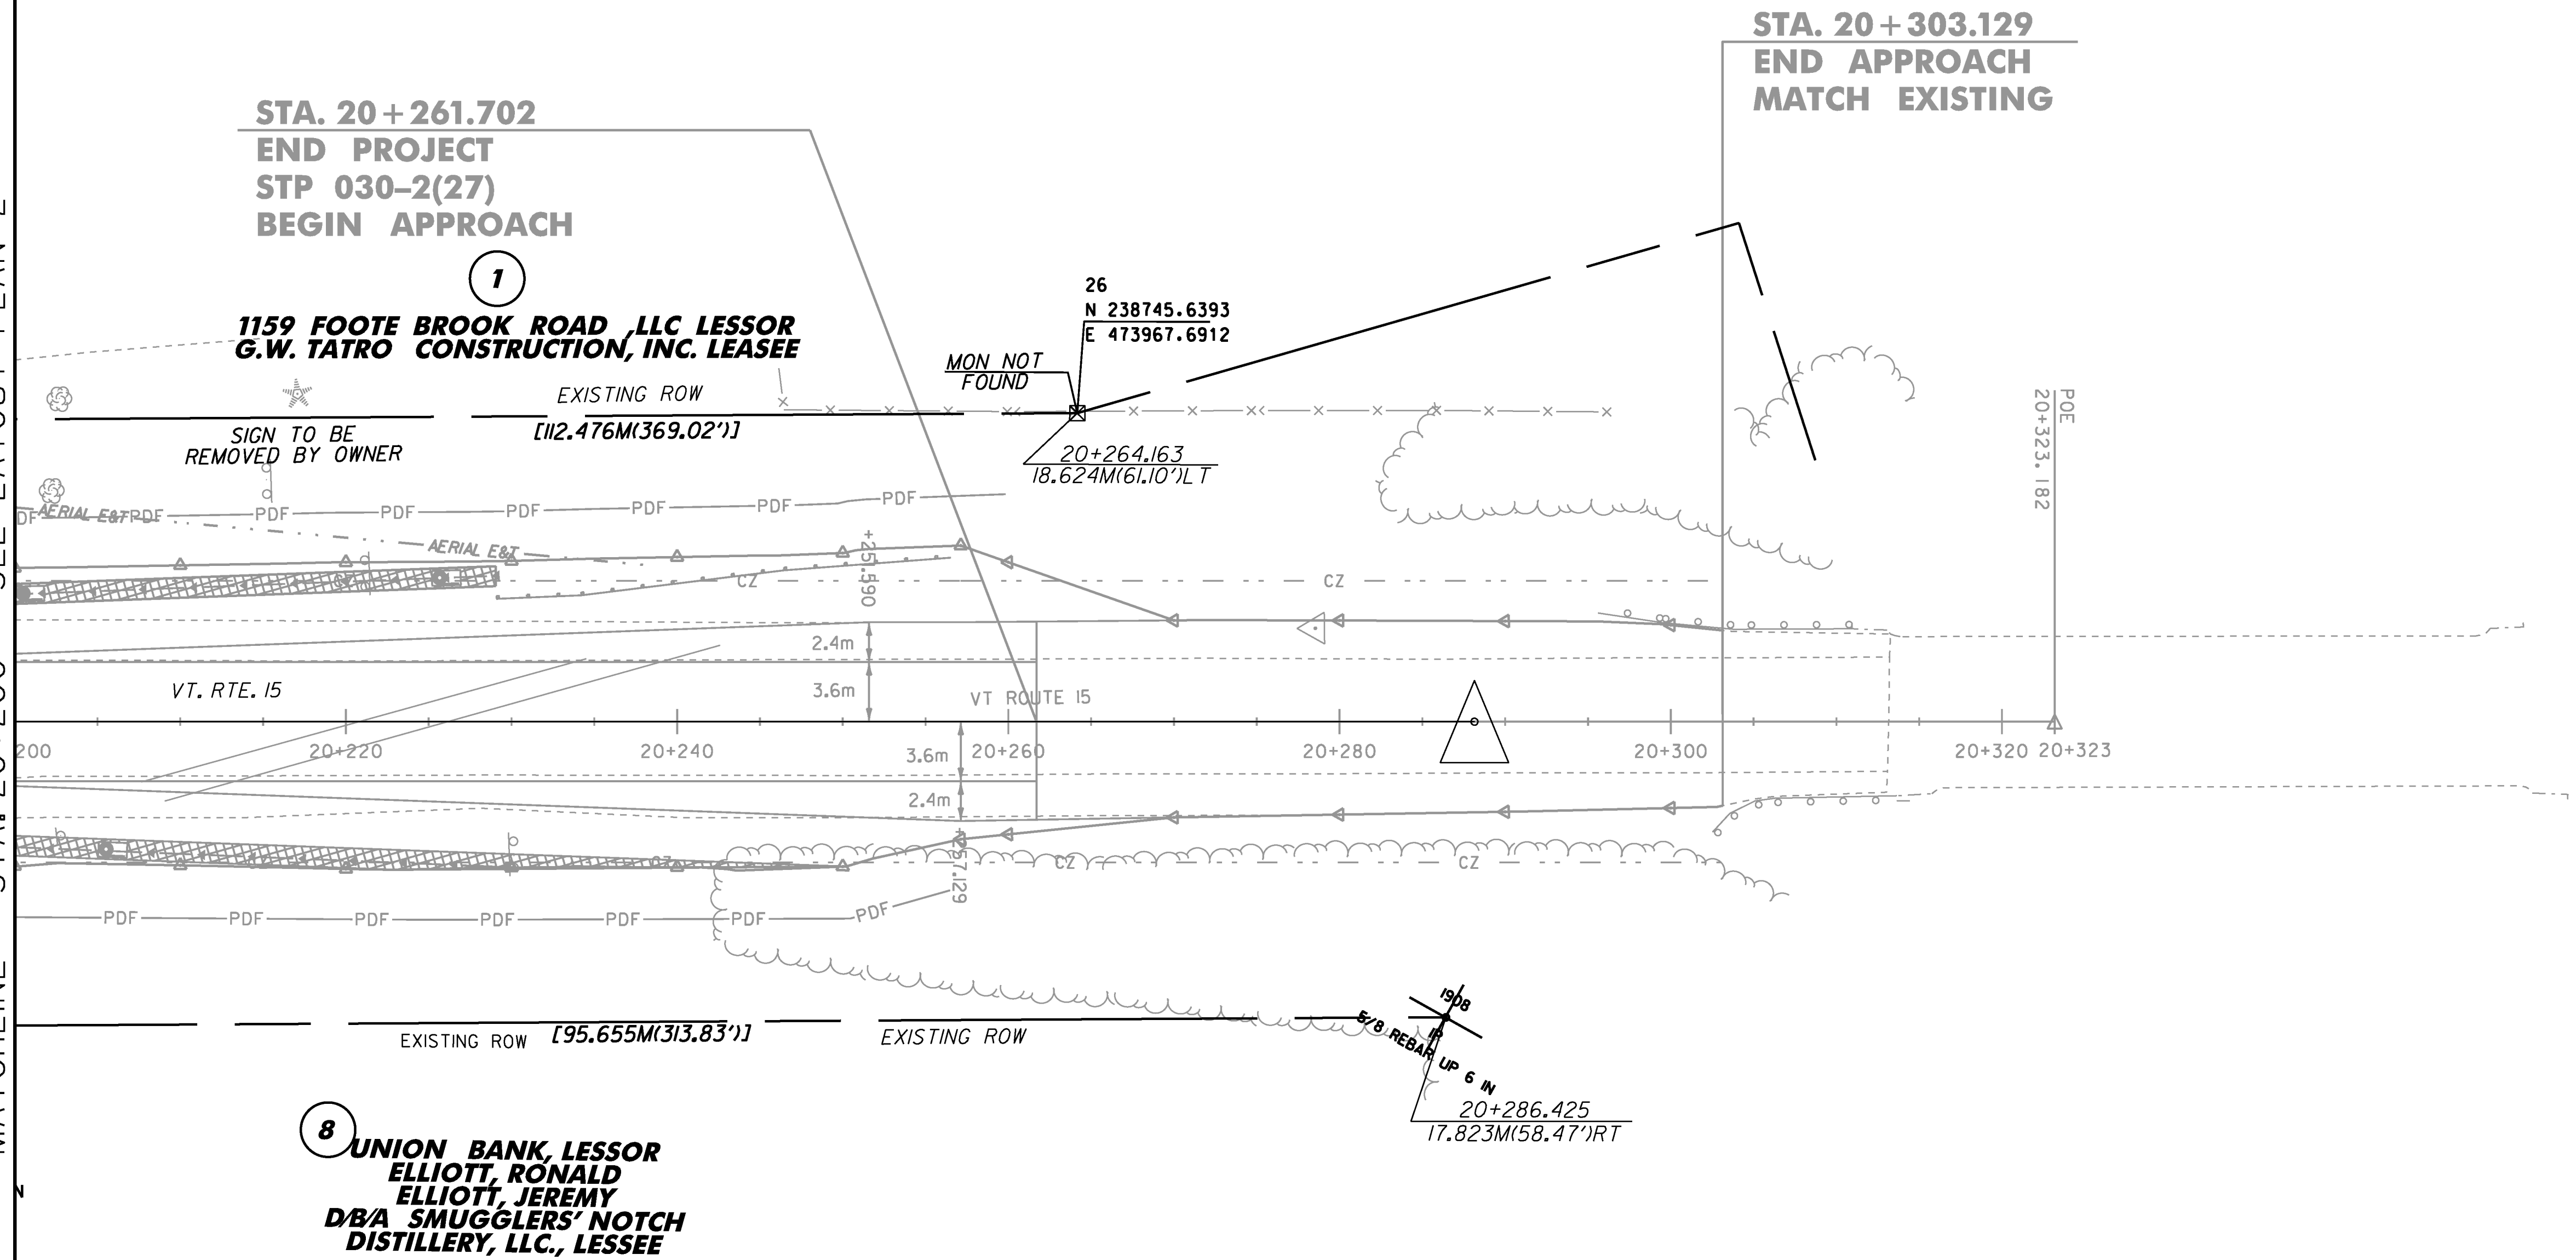

STP LAYOUT #3

PROJECT NAME: CAMBRIDGE	PLOT DATE: 05-JUN-2012
PROJECT NUMBER: STP 030-2(27)	DRAWN BY: B. FERLAZO
FILE NAME: r78f163STPlay3.dgn	CHECKED BY: H. PETROVS
PROJECT LEADER: JLS	SHEET 80 OF 214
DESIGNED BY: MBL	
R.O.W. STP LAYOUT SHEET 3	