


19+970.00

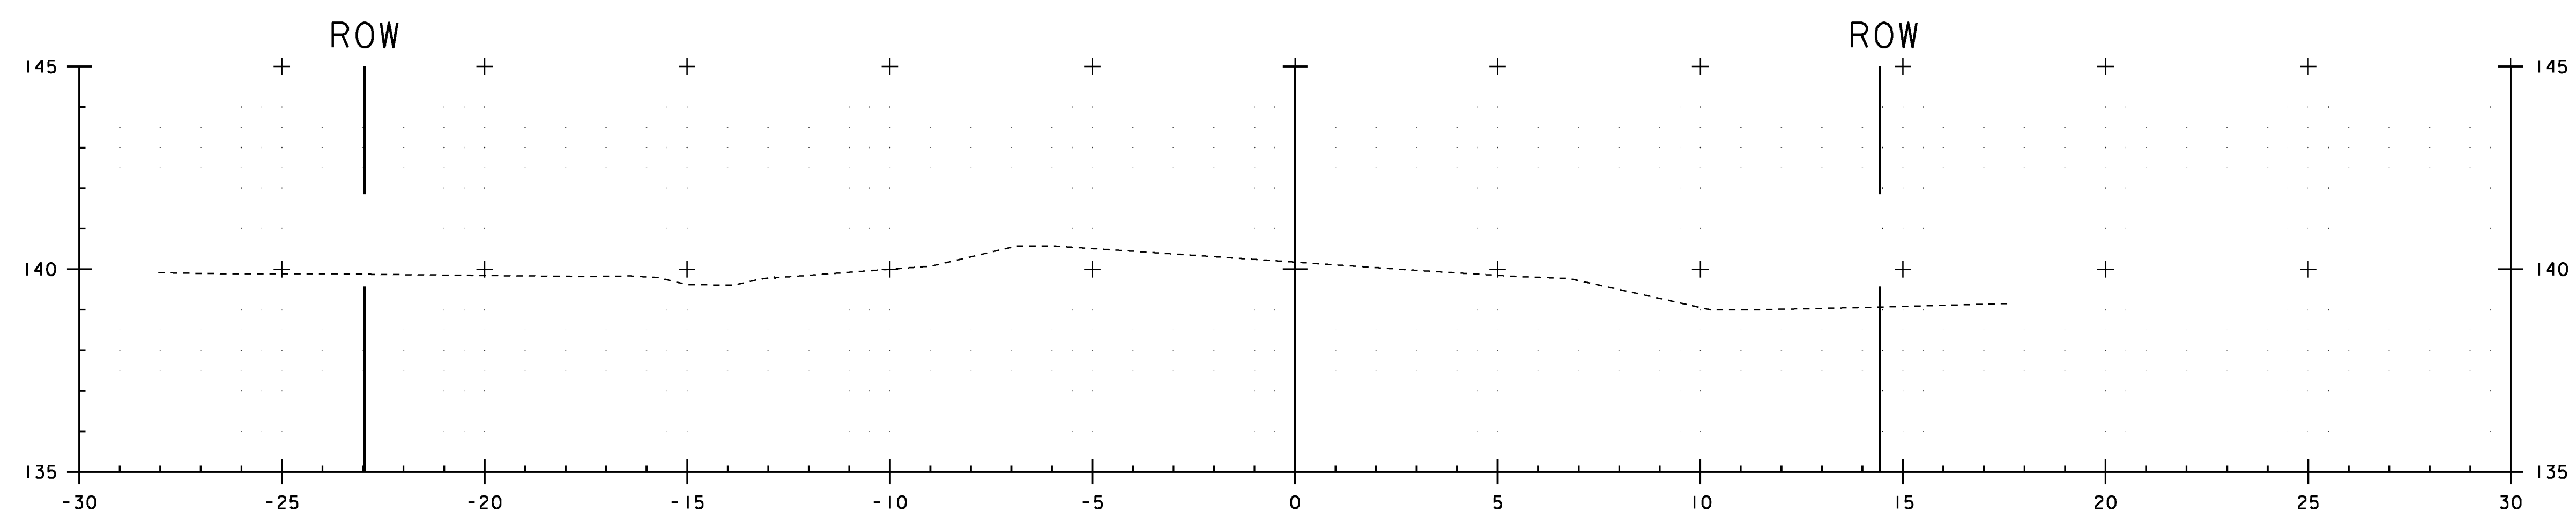

19+960.69
 BEGIN APPROACH
 MATCH EXISTING

VT ROUTE 15

STA. 19+961 TO STA. 19+970

PROJECT NAME: CAMBRIDGE	PLOT DATE: 05-JUN-2012
PROJECT NUMBER: STP 030-2(27)	DRAWN BY: MBL
FILE NAME: t78f163xsl.dgn	CHECKED BY: JAD
PROJECT LEADER: JLS	SHEET 82 OF 214
DESIGNED BY: MBL	
CROSS SECTION SHEET 1	