



20+100.00 \triangle 2

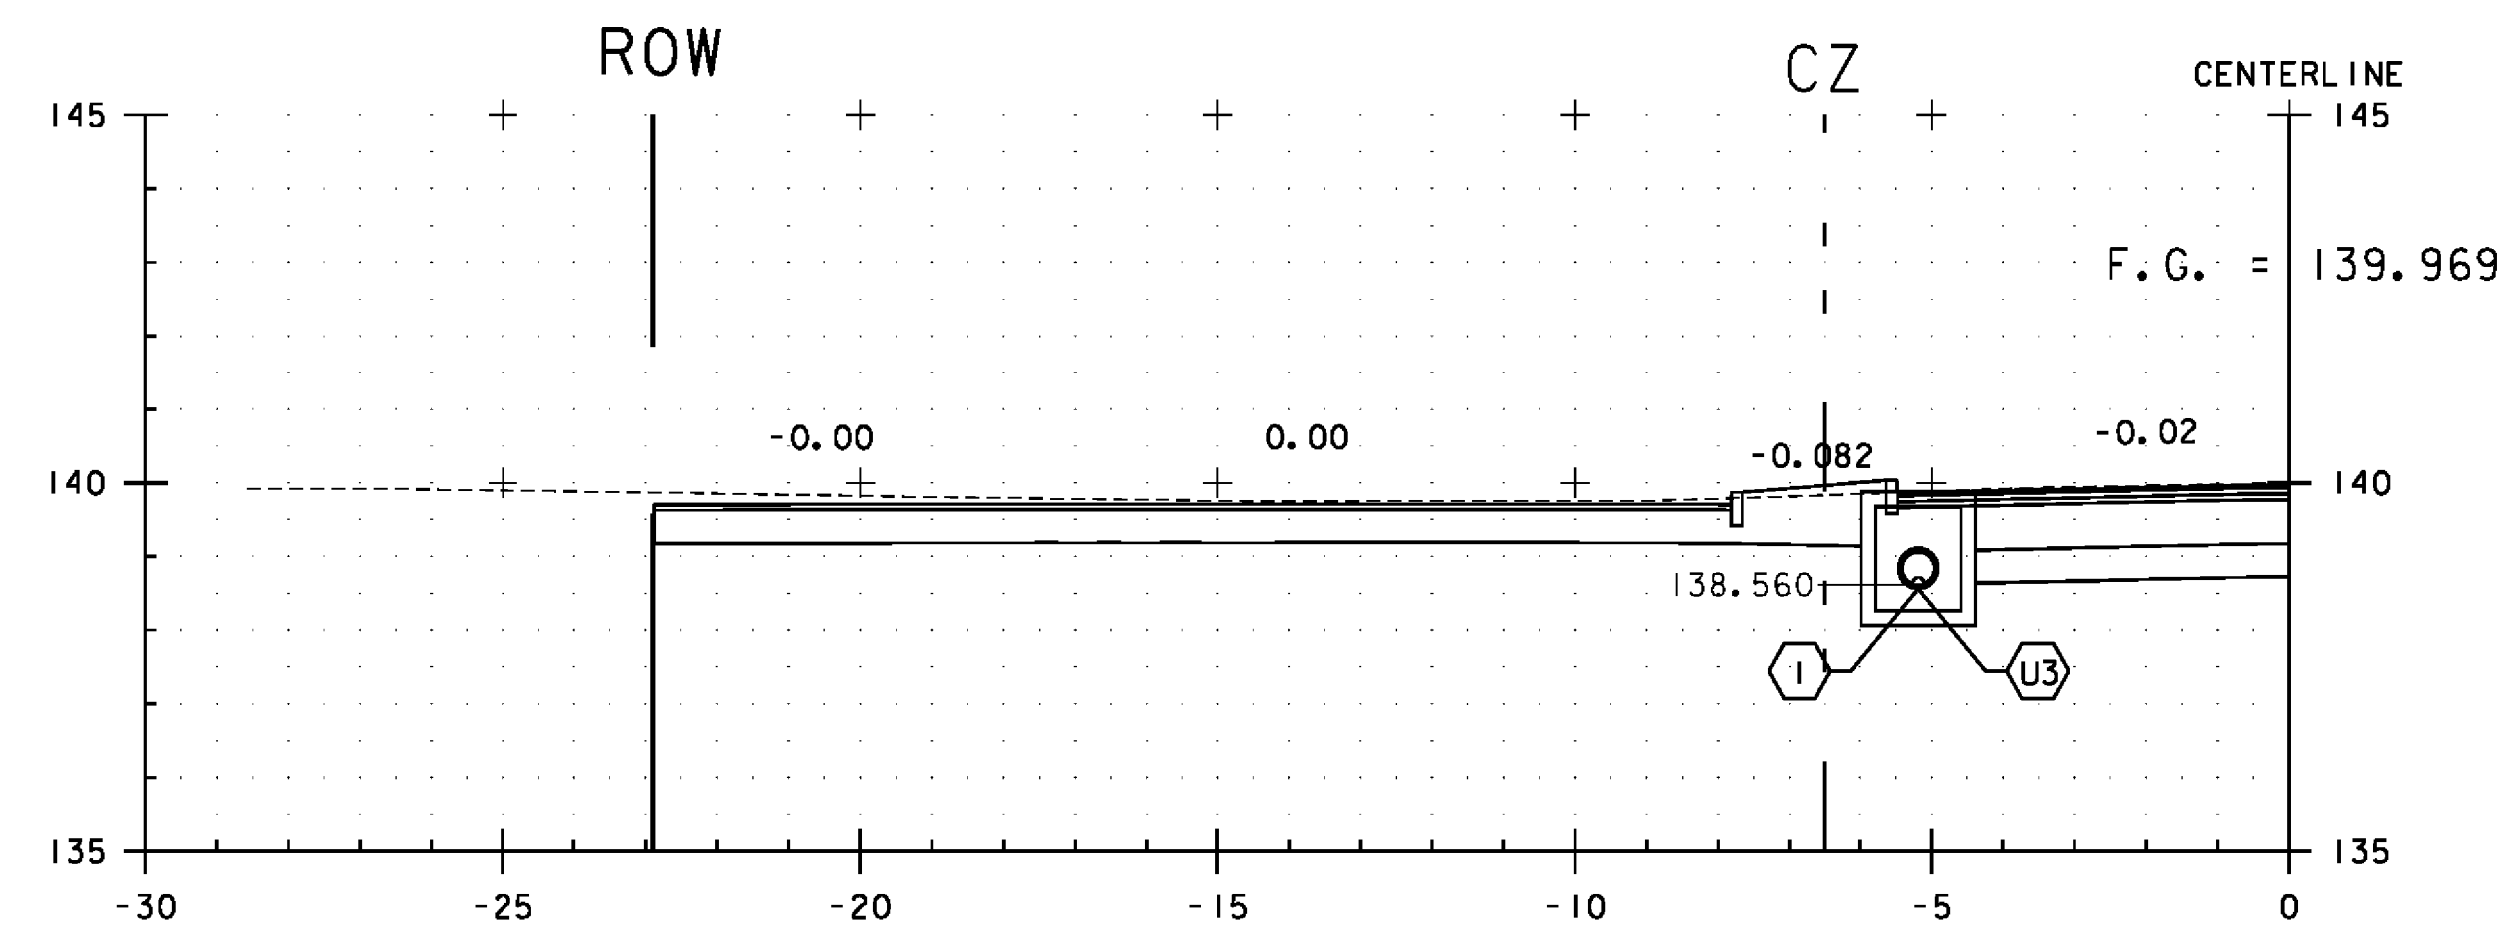

20+091.69 \triangle 1

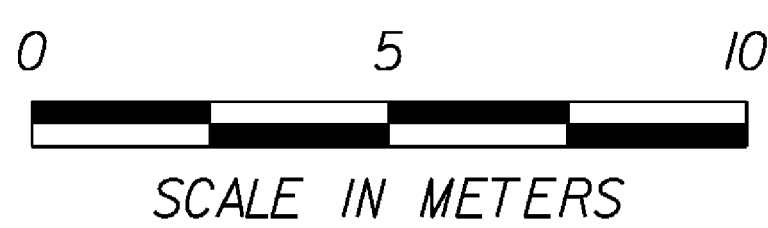

- \triangle 1 REVISED 20+091.69 FINISH GRADE, SUBGRADE, AND RIM ELEVATION
- \triangle 2 REVISED 20+100.00 FINISH GRADE, AND SUBGRADE

STA. 20+092 TO STA. 20+100

VT ROUTE 15

PROJECT NAME: CAMBRIDGE	
PROJECT NUMBER: STP 030-2(27)	
FILE NAME: 178f163xsl.dgn	PLOT DATE: 4/22/13
PROJECT LEADER: JLS	DRAWN BY: MBL
DESIGNED BY: MBL	CHECKED BY: JAD
CROSS SECTION SHEET 10 - REVISED	SHEET 91R OF 214