


VT ROUTE 15

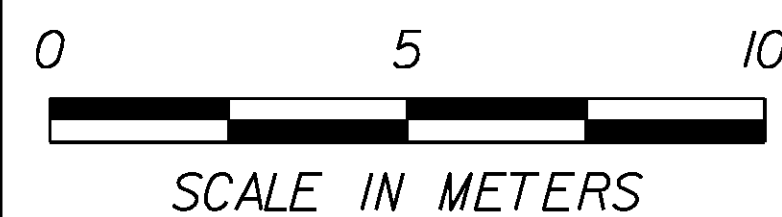

- △ 1 REVISED 20+110.00 FINISH GRADE, AND SUBGRADE
- △ 2 REVISED 20.11.92 FINISH GRADE, SUBGRADE, AND RIM ELEVATION

STA. 20+110 TO STA. 20+112

PROJECT NAME: CAMBRIDGE
PROJECT NUMBER: STP 030-2(27)

FILE NAME: f78f163xsl.dgn	PLOT DATE: 4/22/13
PROJECT LEADER: JLS	DRAWN BY: MBL
DESIGNED BY: MBL	CHECKED BY: JAD
CROSS SECTION SHEET II - REVISED	SHEET 92 OF 214