



20+130.00

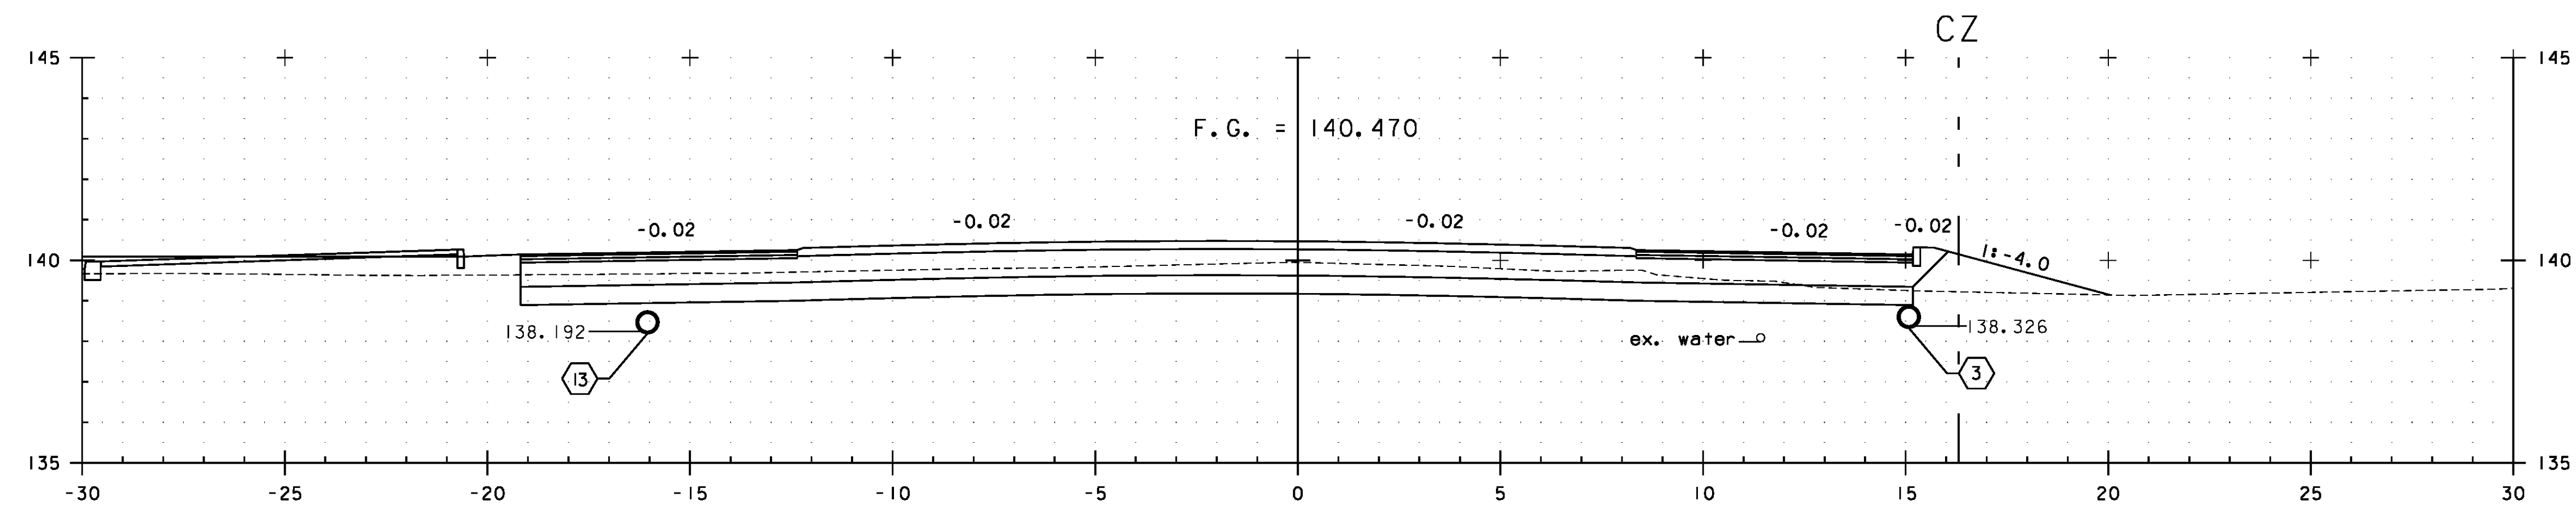

20+120.00

VT ROUTE 15

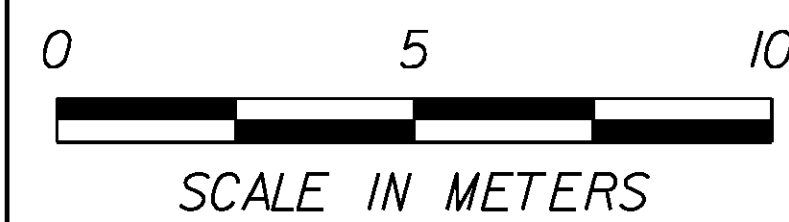

- REVISED 20+120.00 FINISH GRADE AND SUBGRADE
- REVISED 20+130.00 FINISH GRADE AND SUBGRADE

STA. 20+120 TO STA. 20+130

PROJECT NAME: CAMBRIDGE
PROJECT NUMBER: STP 030-2(27)

FILE NAME: f78f163xsl.dgn	PLOT DATE: 4/22/13
PROJECT LEADER: JLS	DRAWN BY: MBL
DESIGNED BY: MBL	CHECKED BY: JAD
CROSS SECTION SHEET 12 - REVISED	SHEET 93 OF 214