


20+140.00

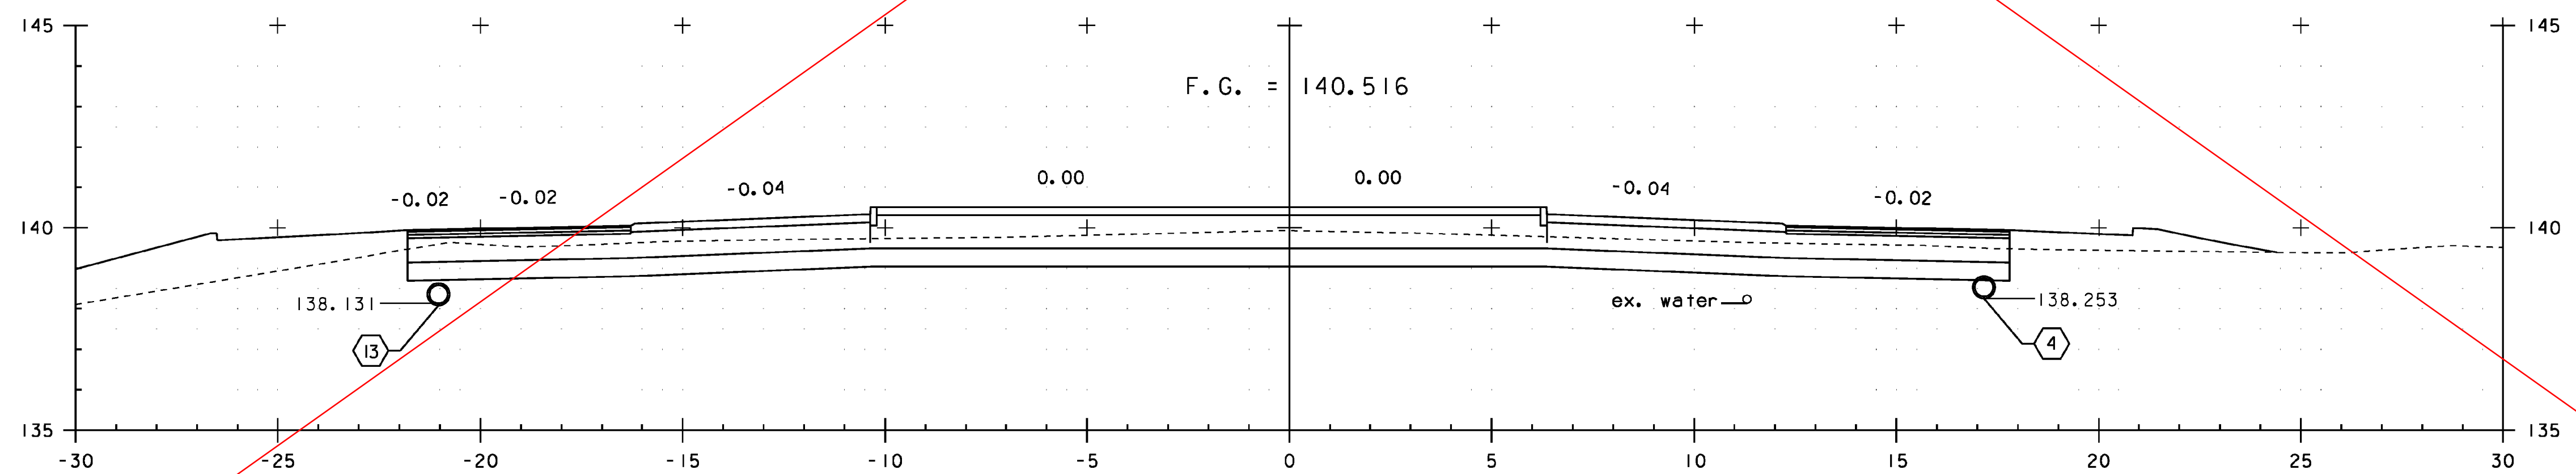

20+130.64

VT ROUTE 15

STA. 20+131 TO STA. 20+140

PROJECT NAME:	CAMBRIDGE	PLOT DATE:	05 JUN-2012
PROJECT NUMBER:	STP 030-2(27)	DRAWN BY:	MBL
FILE NAME:	+78f163xsl.dgn	CHECKED BY:	JAD
PROJECT LEADER:	JLS	SHEET	94 OF 214
DESIGNED BY:	MBL		
CROSS SECTION SHEET	13		