



20+140.00

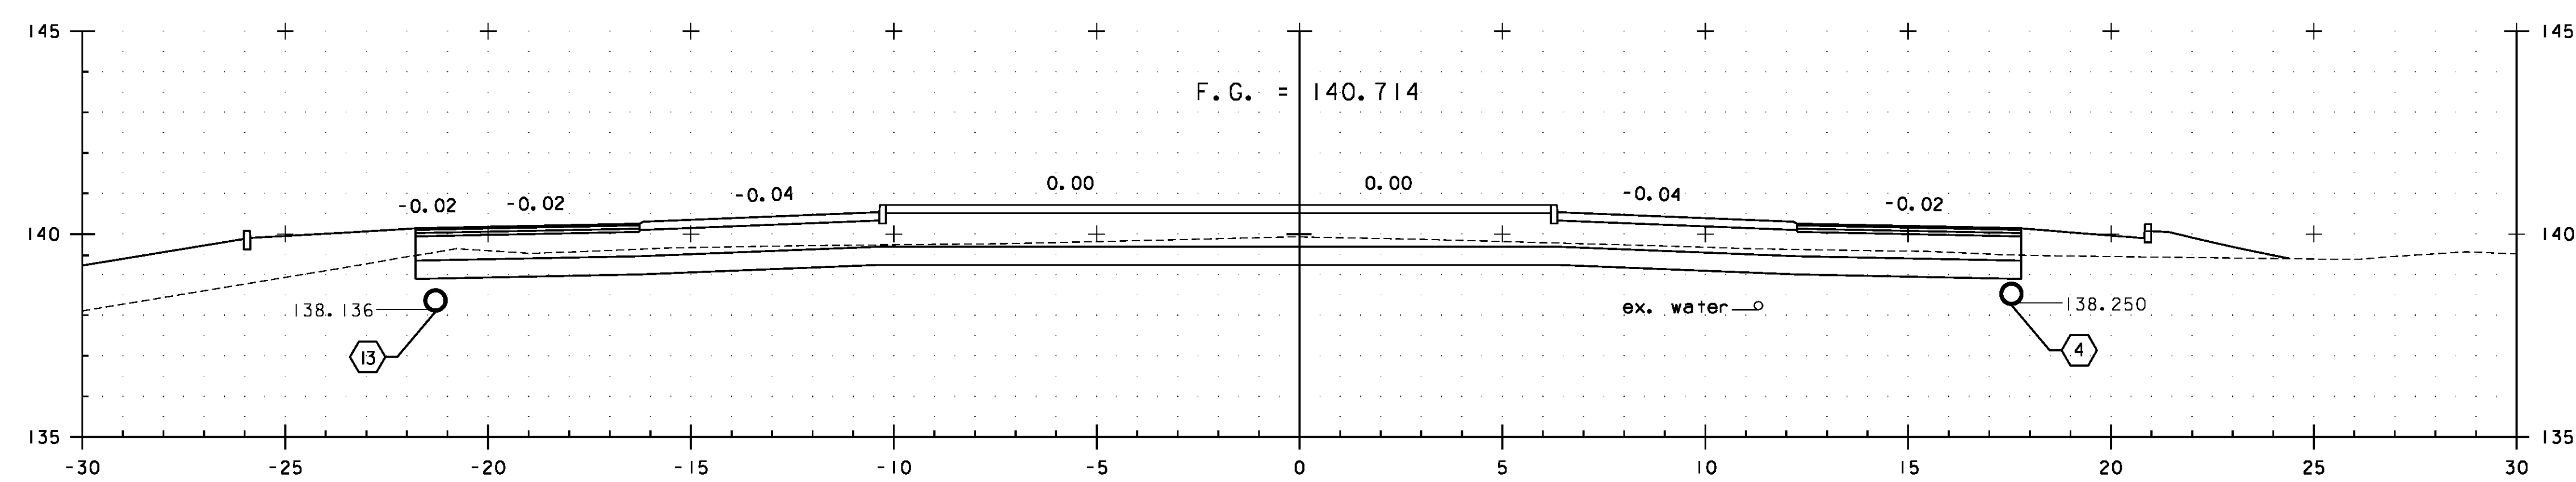

20+130.64

VT ROUTE 15

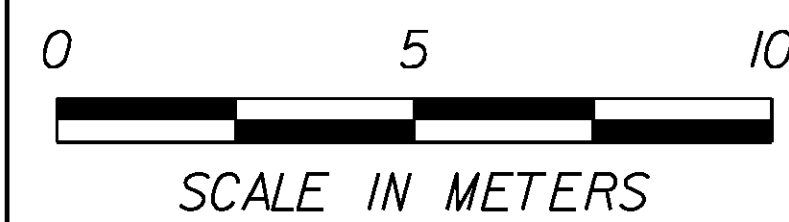

REVISED 20+130.64 FINISH GRADE AND SUBGRADE

REVISED 20+140.00 FINISH GRADE AND SUBGRADE

STA. 20+131 TO STA. 20+140

PROJECT NAME: CAMBRIDGE
PROJECT NUMBER: STP 030-2(27)

FILE NAME: f78f163xsl.dgn	PLOT DATE: 4/22/13
PROJECT LEADER: JLS	DRAWN BY: MBL
DESIGNED BY: MBL	CHECKED BY: JAD
CROSS SECTION SHEET 13 - REVISED	SHEET 94 OF 214