


VT ROUTE 15

PROJECT NAME: CAMBRIDGE	
PROJECT NUMBER: STP 030-2(27)	
FILE NAME: f78f163xsl.dgn	PLOT DATE: 5/13/13
PROJECT LEADER: JLS	DRAWN BY: MBL
DESIGNED BY: MBL	CHECKED BY: JAD
CROSS SECTION SHEET 14	SHEET 95 OF 214

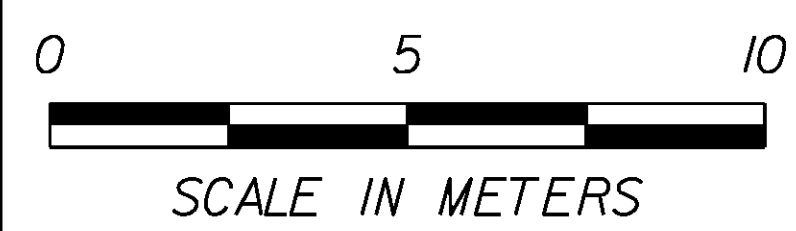

- 1 REVISED 20+148.17 FINISH GRADE, SUBGRADE, AND RIM ELEVATION
- 2 REVISED 20+147.92 FINISH GRADE, SUBGRADE, AND RIM ELEVATION
- 3 REVISED 20+148.17 PIPE 21 ELEVATION AND OFFSET

STA. 20+147 TO STA. 20+148