




20+160.00 \triangle_3 \triangle_5

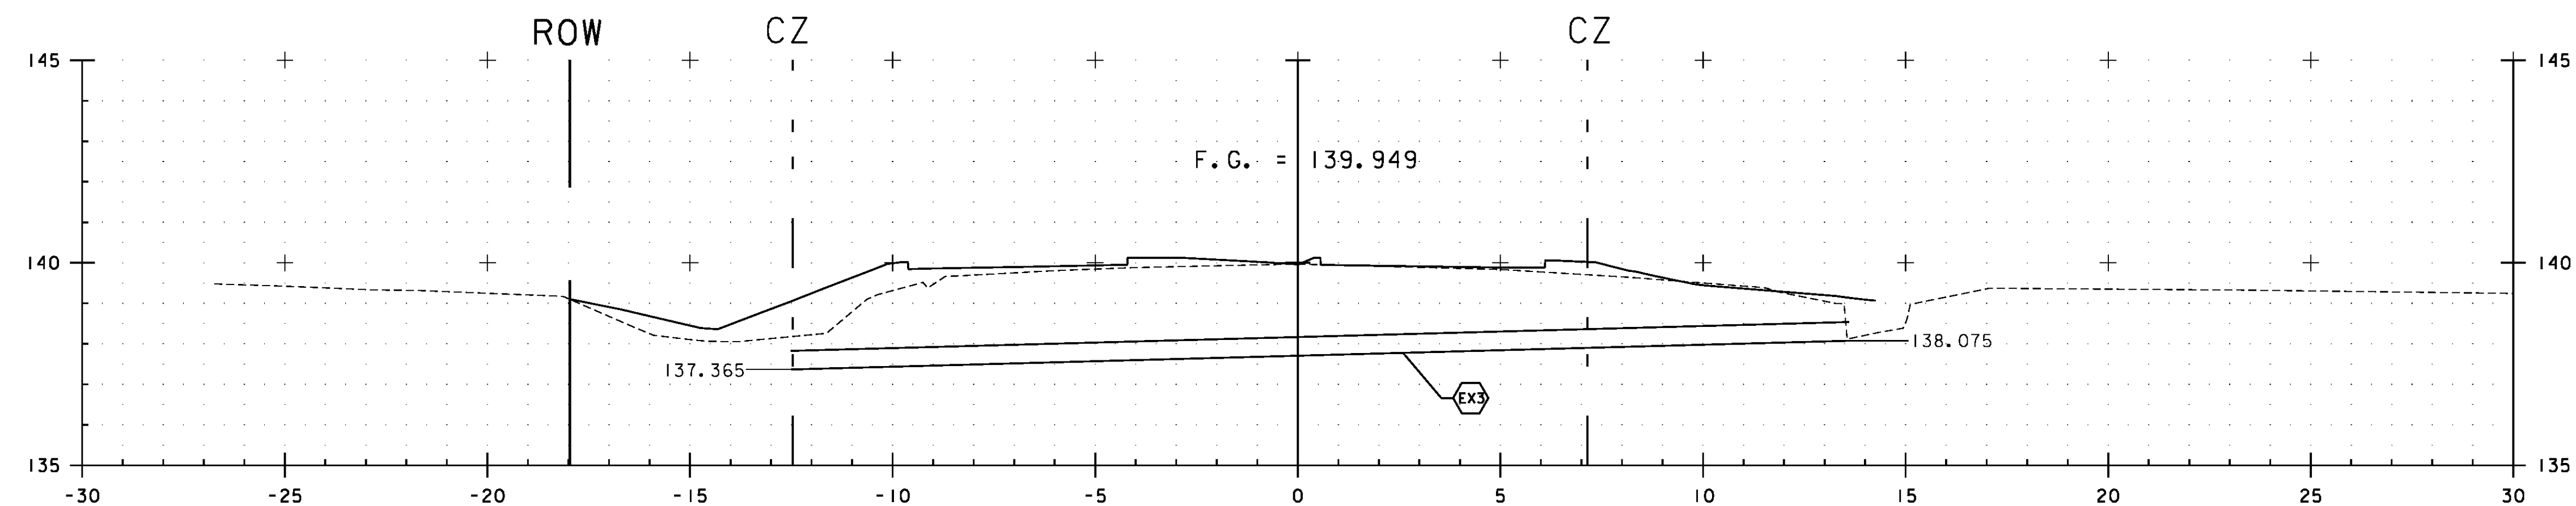

20+151.79 \triangle_2

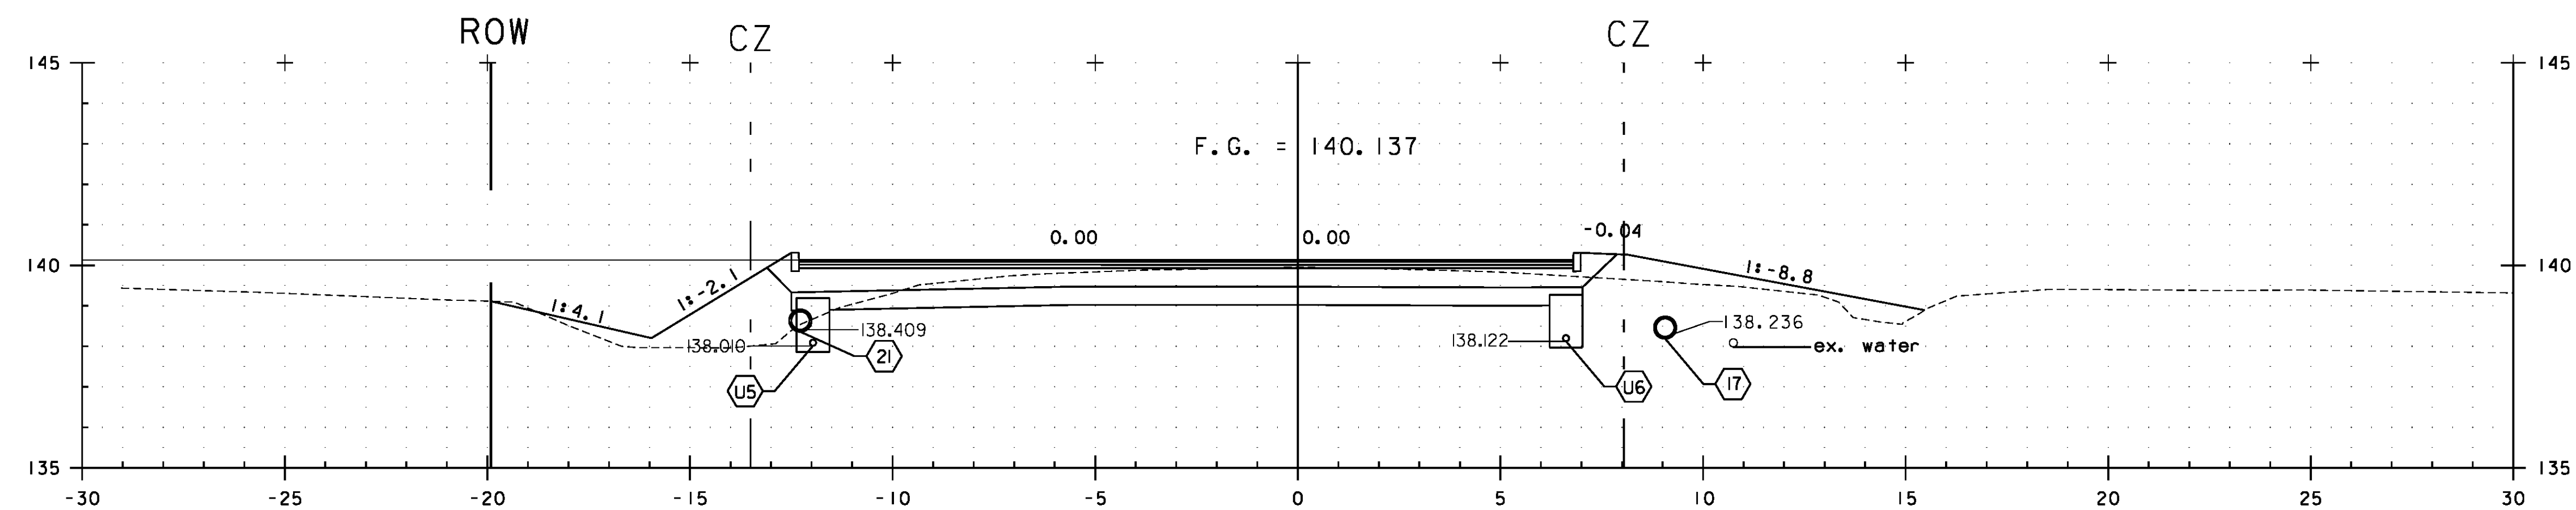

20+150.00 \triangle_1 \triangle_4

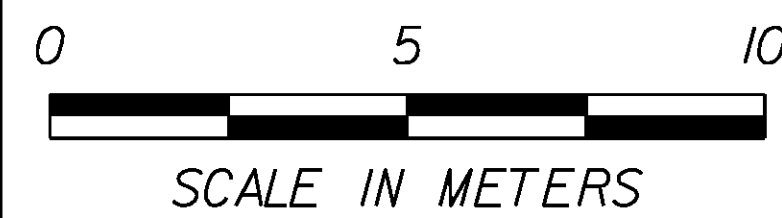

- \triangle_1 REVISED 20+150.00 FINISH GRADE AND SUBGRADE
- \triangle_2 REVISED 20+151.79 FINISH GRADE AND SUBGRADE
- \triangle_3 REVISED 20+160.00 FINISH GRADE AND SUBGRADE
- \triangle_4 REVISED 20+151.79 FINISH GRADE AND SUBGRADE
- \triangle_5 REVISED 20+160.00 PIPE 21 ELEVATION AND OFFSET

STA. 20+150 TO STA. 20+160

VT ROUTE 15

PROJECT NAME: CAMBRIDGE
PROJECT NUMBER: STP 030-2(27)

FILE NAME: f78f63xsl.dgn
PROJECT LEADER: JLS
DESIGNED BY: MBL
CROSS SECTION SHEET 15

PLOT DATE: 5/13/13
DRAWN BY: MBL
CHECKED BY: JAD
SHEET 96 OF 214