


20+180.00

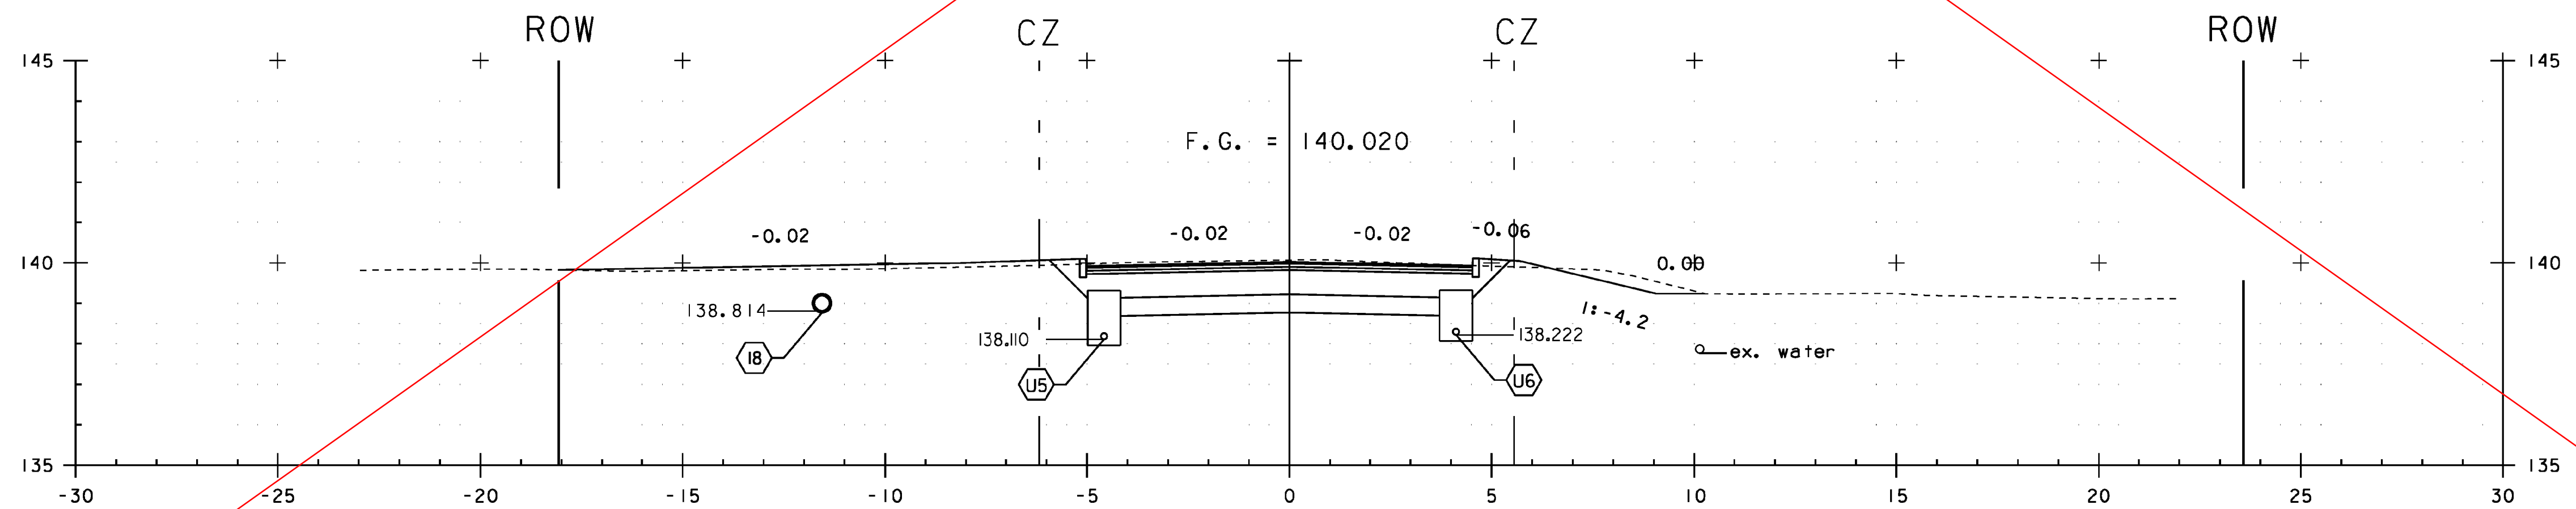

20+170.00

VT ROUTE 15

STA. 20+170 TO STA. 20+180

PROJECT NAME: CAMBRIDGE	PLOT DATE: 05 JUN-2012
PROJECT NUMBER: STP 030-2(27)	DRAWN BY: MBL
FILE NAME: +78f163xsl.dgn	CHECKED BY: JAD
PROJECT LEADER: JLS	SHEET 97 OF 214
DESIGNED BY: MBL	
CROSS SECTION SHEET 16	

SEE REVISION SHEET