



20+190.00

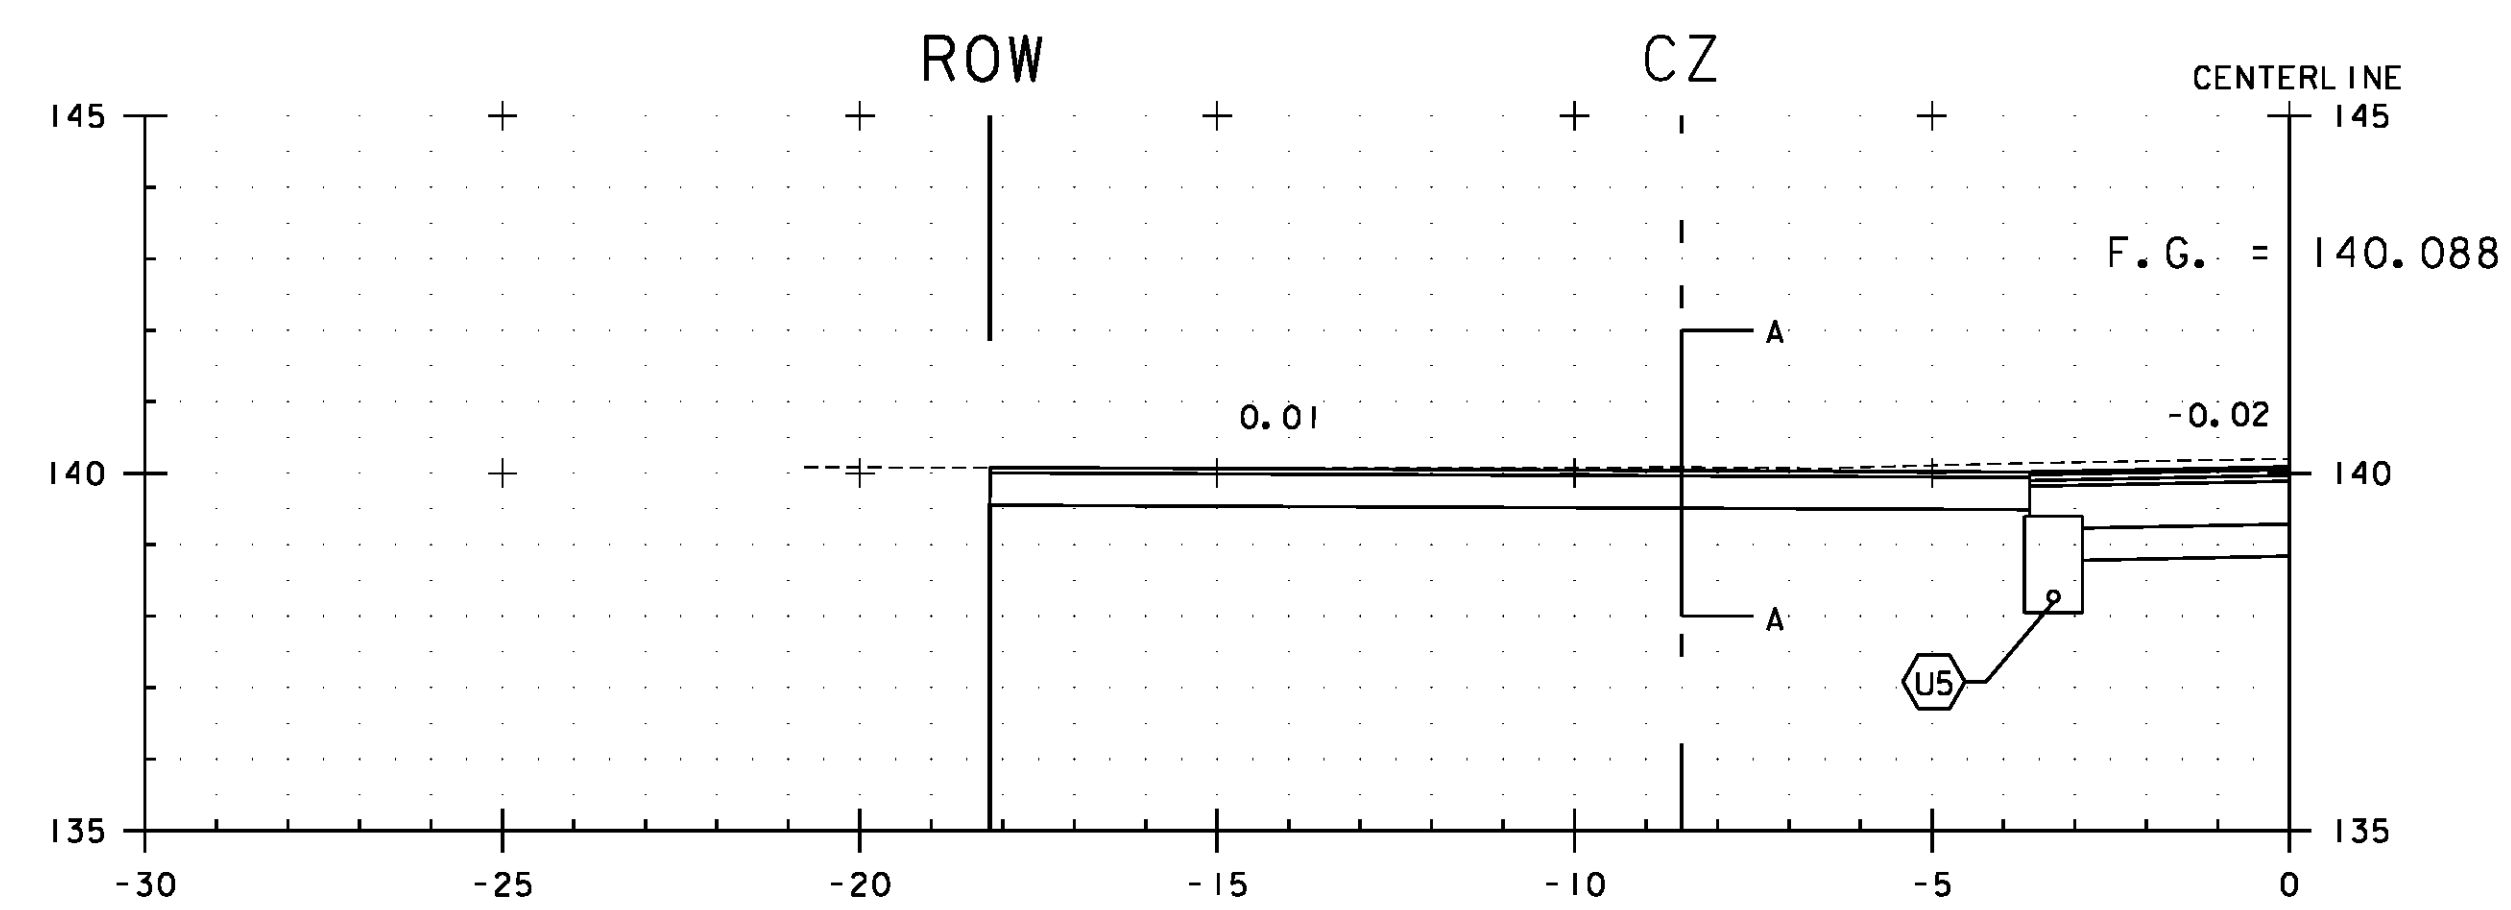

20+191.21  
DRIVE LT.

VT ROUTE 15

PROJECT NAME: CAMBRIDGE	PLOT DATE: 5/13/13
PROJECT NUMBER: STP 030-2(27)	DRAWN BY: MBL
FILE NAME: f78f163xsl.dgn	CHECKED BY: JAD
PROJECT LEADER: JLS	SHEET 98 OF 214
DESIGNED BY: MBL	
CROSS SECTION SHEET 17	

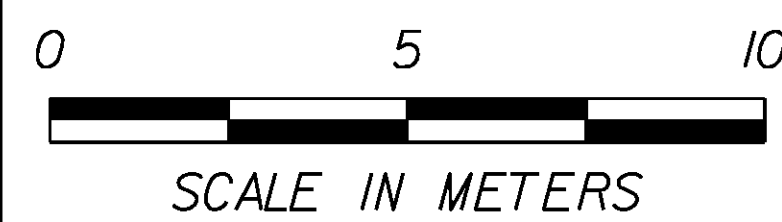

REVISED 20+191.21 FINISH GRADE

REVISED 20+190.00 FINISH GRADE AND SUBGRADE

REVISED 20+190.00 REMOVED PIPE 18A

STA. 20+187 TO STA. 20+190