


20+200.00

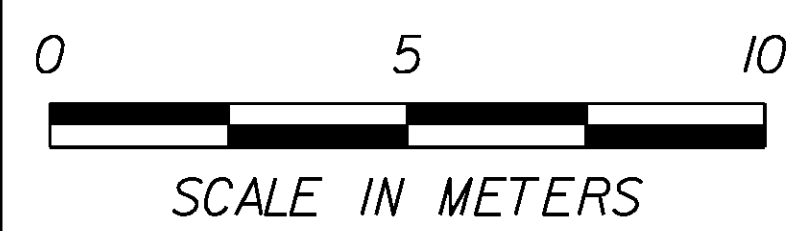

- REVISED 20+200.00 FINISH GRADE AND SUBGRADE
- REVISED 20+200.00 REMOVED PIPE 18A

STA. 20+197 TO STA. 20+200

VT ROUTE 15

PROJECT NAME: CAMBRIDGE	
PROJECT NUMBER: STP 030-2(27)	
FILE NAME: f78f163xsl.dgn	PLOT DATE: 5/13/13
PROJECT LEADER: JLS	DRAWN BY: MBL
DESIGNED BY: MBL	CHECKED BY: JAD
CROSS SECTION SHEET 18	SHEET 99 OF 214