


20+270.00

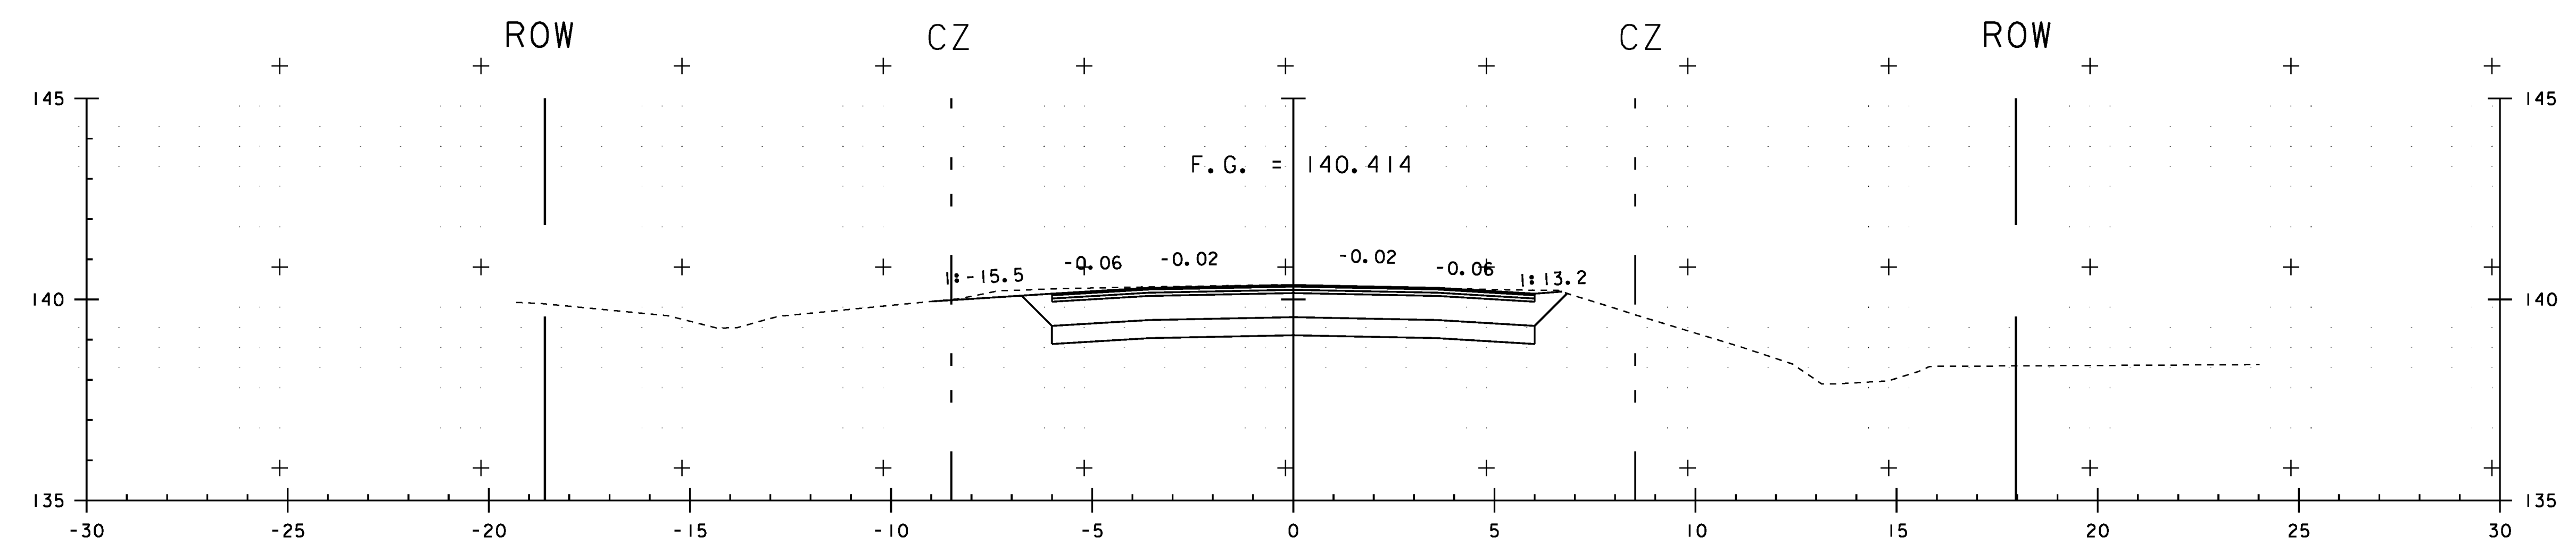

20+261.702
 END PROJECT
 BEGIN APPROACH

VT ROUTE 15

STA. 20+262 TO STA. 20+270

PROJECT NAME: CAMBRIDGE	PLOT DATE: 05-JUN-2012
PROJECT NUMBER: STP 030-2(27)	DRAWN BY: MBL
FILE NAME: +78f163xsl.dgn	CHECKED BY: JAD
PROJECT LEADER: JLS	SHEET 103 OF 214
DESIGNED BY: MBL	
CROSS SECTION SHEET 22	