


20+290.00

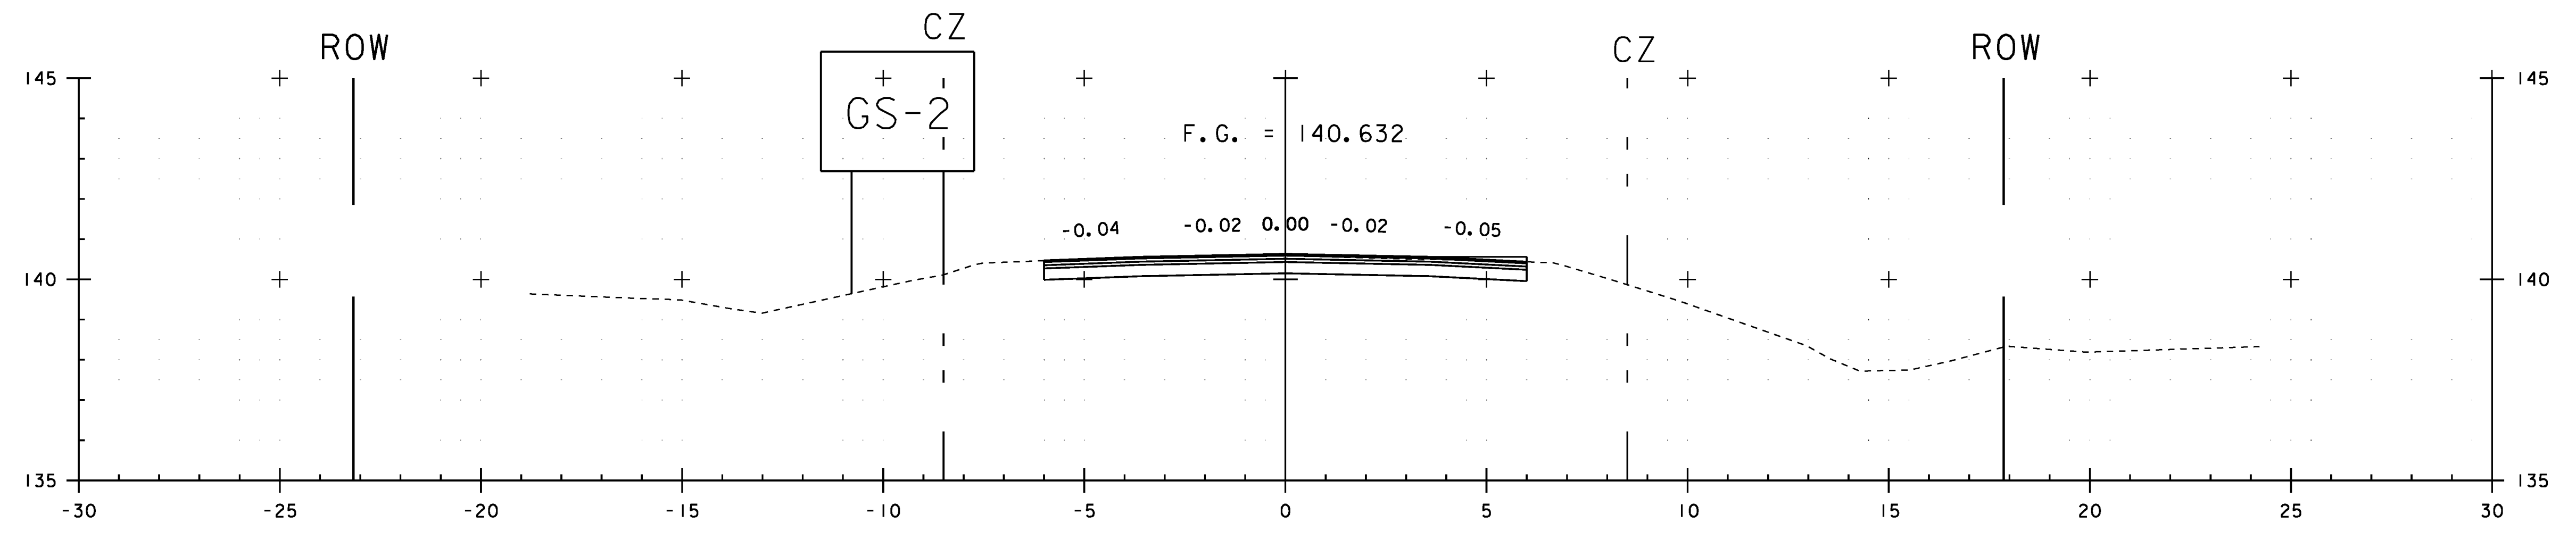

20+280.00

VT ROUTE 15

PROJECT NAME: CAMBRIDGE	
PROJECT NUMBER: STP 030-2(27)	
FILE NAME: +78f163xsl.dgn	PLOT DATE: 05-JUN-2012
PROJECT LEADER: JLS	DRAWN BY: MBL
DESIGNED BY: MBL	CHECKED BY: JAD
CROSS SECTION SHEET 23	SHEET 104 OF 214

STA. 20+280 TO STA. 20+290