


20+303.129
 END APPROACH
 MATCH EXISTING

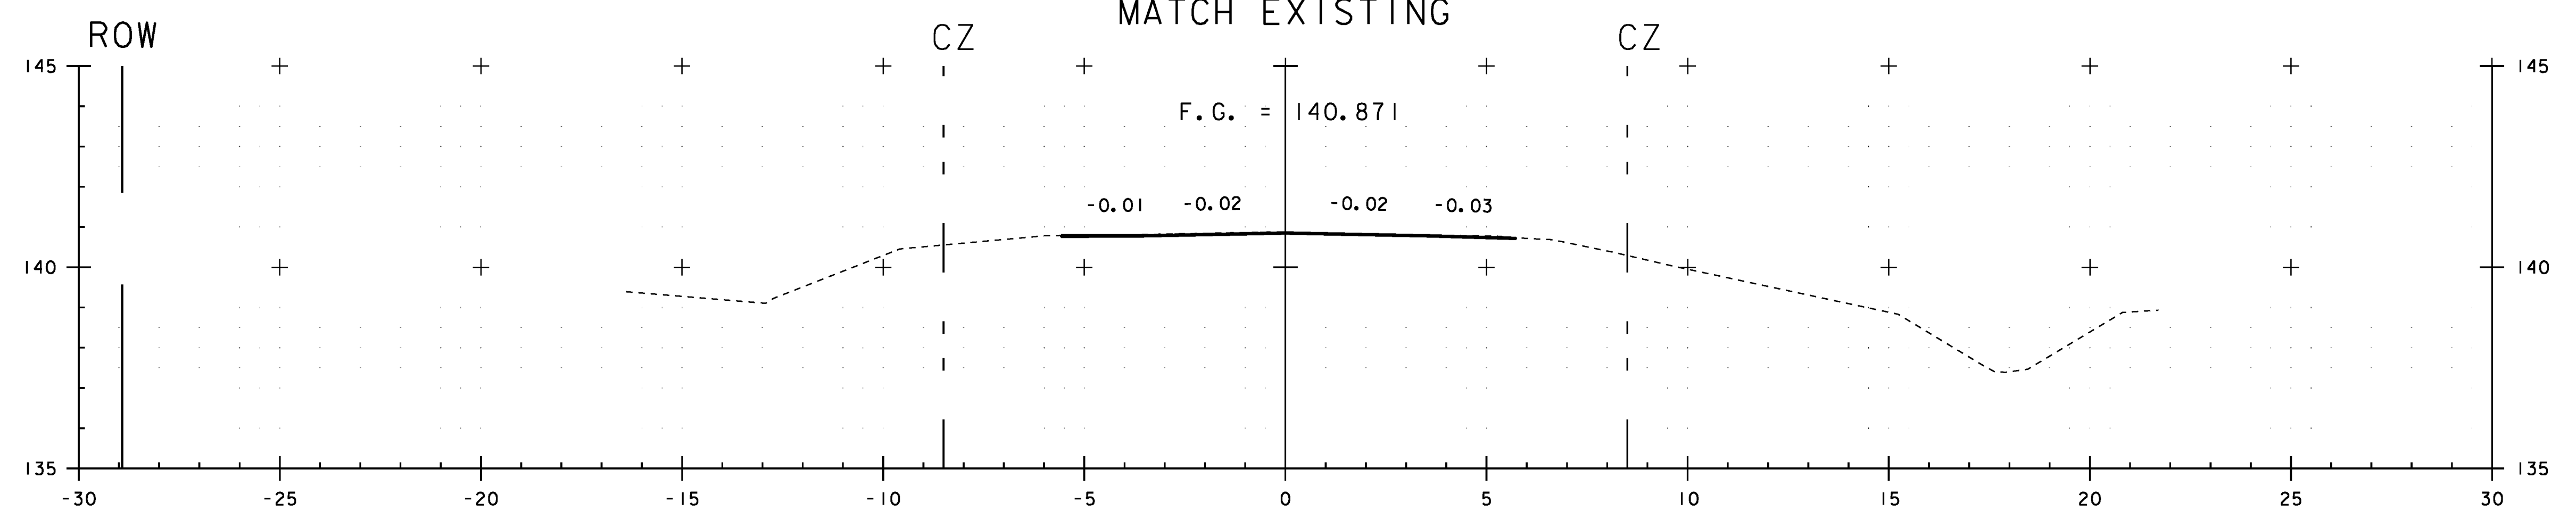

20+300.00

VT ROUTE 15

STA. 20+300 TO STA. 20+303

PROJECT NAME: CAMBRIDGE	PLOT DATE: 05-JUN-2012
PROJECT NUMBER: STP 030-2(27)	DRAWN BY: MBL
FILE NAME: +78f163xsl.dgn	CHECKED BY: JAD
PROJECT LEADER: JLS	SHEET 105 OF 214
DESIGNED BY: MBL	
CROSS SECTION SHEET 24	