


9+910.00

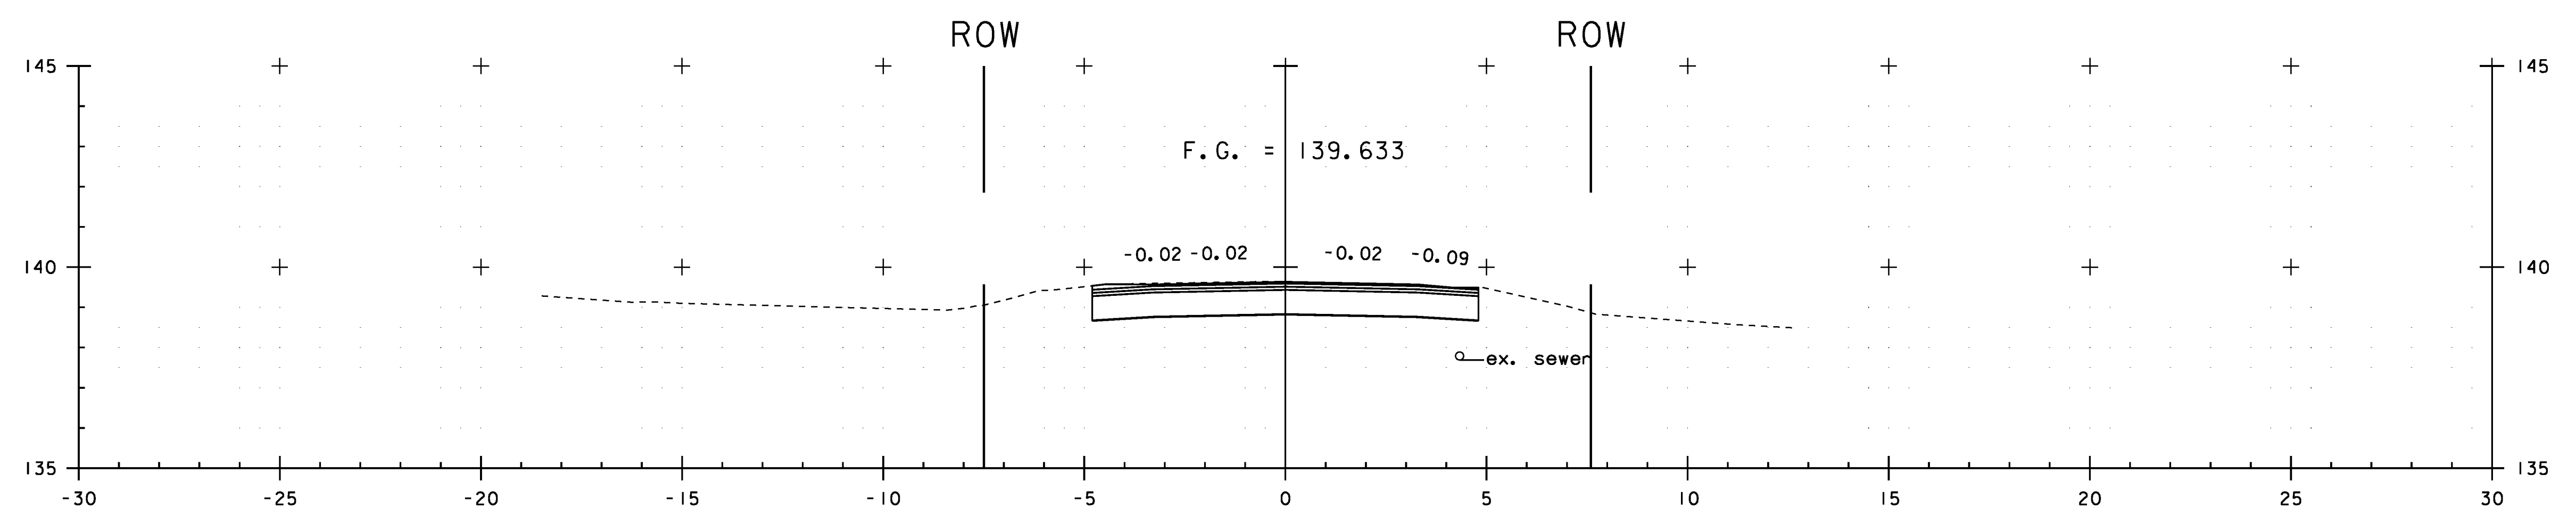

9+900.00

VT ROUTE 108

STA. 9+900 TO STA. 9+910

PROJECT NAME:	CAMBRIDGE	PLOT DATE:	05-JUN-2012
PROJECT NUMBER:	STP 030-2(27)	DRAWN BY:	MBL
FILE NAME:	+78f163xsl.dgn	CHECKED BY:	JAD
PROJECT LEADER:	JLS	CROSS SECTION SHEET 27	SHEET 108 OF 214
DESIGNED BY:	MBL		