


9+934.42
DRIVE LT.

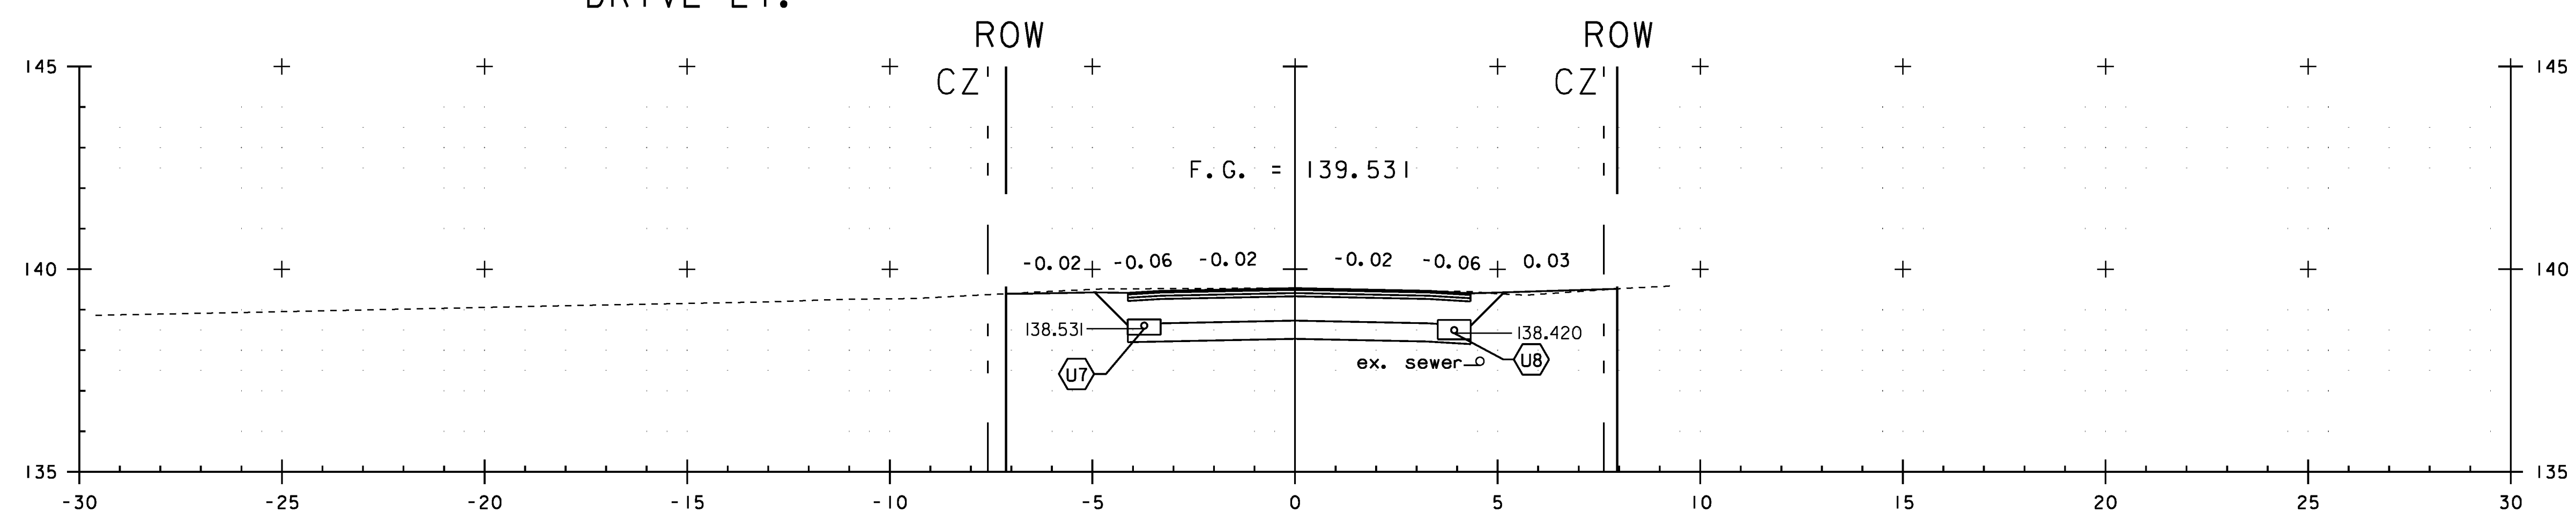

9+930.00

VT ROUTE 108

STA. 9+930 TO STA. 9+934

PROJECT NAME:	CAMBRIDGE	PLOT DATE:	05-JUN-2012
PROJECT NUMBER:	STP 030-2(27)	DRAWN BY:	MBL
FILE NAME:	+78f163xsl.dgn	CHECKED BY:	JAD
PROJECT LEADER:	JLS	CROSS SECTION SHEET 29	SHEET 110 OF 214
DESIGNED BY:	MBL		